

Lloyd's Register of Shipping.

SURVEYS FOR FREEBOARD.

Computation of Freeboard for Steamer, Sailing Ship, Tanker
having Poop Bridge and Forecastle. Port of Survey London

(Type of Superstructures.)

Date of Survey 29th June '32

Name of Surveyor Thomas E. Snowden

Ship's Name BENVORLICH Nationality and Port of Registry British Leith. Official Number 142010 Gross Tonnage 5193 Date of Build 1919-8

Moulded Dimensions: Length 399.5 Breadth 52. Depth 31.2041

Moulded displacement at moulded draught = 85 per cent. of moulded depth 12890 (@ 26'4")

Coefficient of fineness for use with Tables .740

Particulars of Classification +100 A.1.
S.S. Ind. No. 3-8-31

Depth for Freeboard (D)	Depth correction	Round of Beam correction
Moulded depth ... 31.00 ✓	(a) Where D is greater than Table depth (D - Table depth) R = <u>(31.04 - 26.63) 3 = +13.23 ✓</u>	Moulded Breadth (B) <u>52.00</u> ✓
Stringer plate <u>48"</u> ... 04 ✓	(b) Where D is less than Table depth (if allowed) (Table depth - D) R =	Standard Round of Beam = $\frac{B \times 12}{50} = \frac{12.48}{50} = 12.48$ ✓
Sheathing on exposed deck $T \left(\frac{L-S}{L} \right) =$	If restricted by superstructures	Ship's Round of Beam = <u>13.00</u> ✓
Depth for Freeboard (D) = <u>31.04</u> ✓		Difference <u>.52</u> ✓
		Restricted to
		Correction = $\frac{\text{Diff}}{4} \times (1 - \frac{S_1}{L}) = \frac{.52}{4} (1 - \frac{.5044}{1}) = -.06$ ✓

DEDUCTION FOR SUPERSTRUCTURES.

	Mean Covered Length (S)	Equivalent Enclosed Length (S)	Height	Height Correction	Effective Length (E)
Poop enclosed ...	<u>49-3</u> ✓	<u>49.25</u> ✓	<u>7-11½</u> ✓		<u>49.25</u> ✓
„ overhang ...					
R.Q.D. enclosed ...					
„ overhang ...					
Bridge enclosed ...	<u>112-8</u> ✓	<u>112.67</u> ✓	<u>7-11½</u> ✓		<u>112.67</u> ✓
„ overhang aft ...	<u>3½</u> ✓	<u>.22</u> ✓			<u>.22</u> ✓
„ overhang forward ...	<u>3½</u> ✓	<u>.14</u> ✓			<u>.14</u> ✓
F'cle enclosed ...	<u>39-25</u> ✓	<u>39.25</u> ✓			<u>39.25</u> ✓
„ overhang ...					
Trunk aft ...					
„ forward ...					
Tonnage opening aft ...					
„ „ forward ...					
Total ...	<u>201.75</u> ✓	<u>201.53</u> ✓			<u>201.53</u> ✓

Standard Height of Superstructure 7.495 ✓

„ „ R.Q.D. ✓

Deduction for complete superstructure 41.96 ✓

Percentage covered $\frac{S}{L} = \frac{50.50}{100} = 50.50\%$ ✓

„ „ $\frac{S_1}{L} = \frac{50.44}{100} = 50.44\%$ ✓

„ „ $\frac{E}{L} = \frac{50.44}{100} = 50.44\%$ ✓

Percentage from Table, Line A. ✓

(corrected for absence of forecastle (if required))

Percentage from Table, Line B. 36.44% ✓

(corrected for absence of forecastle (if required))

Interpolation for bridge less than 2L (if required)

Deduction = 41.96 × .3644 = -15.29 ✓

SHEER CORRECTION.

Station	Standard Ordinate	S	M	Product	Actual Ordinate	Effective Ordinate	S	M	Product
A.P. ...	<u>49.95</u> ✓	1		<u>49.95</u> ✓	<u>60</u> ✓	<u>60.00</u> ✓	1		<u>60.00</u> ✓
L from A.P. ...	<u>22.23</u> ✓	4		<u>88.92</u> ✓	<u>26½</u> ✓	<u>26.47</u> ✓	4		<u>105.88</u> ✓
¾ L „ ...	<u>5.49</u> ✓	2		<u>10.98</u> ✓	<u>6¾</u> ✓	<u>6.62</u> ✓	2		<u>13.24</u> ✓
Amidships ...		4					4		
¾ L from F.P. ...	<u>10.99</u> ✓	2		<u>21.98</u> ✓	<u>13½</u> ✓	<u>13.33</u> ✓	2		<u>26.66</u> ✓
¼ L „ ...	<u>44.46</u> ✓	4		<u>177.84</u> ✓	<u>52</u> ✓	<u>53.33</u> ✓	4		<u>213.32</u> ✓
F.P. ...	<u>99.90</u> ✓	1		<u>99.90</u> ✓	<u>120</u> ✓	<u>120.00</u> ✓	1		<u>120.00</u> ✓
Total ...				<u>449.57</u> ✓					<u>539.10</u> ✓

Mean actual sheer aft = Excess

Mean standard sheer aft

Mean actual sheer forward = Excess

Mean standard sheer forward

Length of enclosed superstructure forward of amidships = .155

„ „ aft of „ = .127

Correction = $\frac{\text{Difference between sums of products}}{18} = \frac{89.53}{18} = 4.975$ (if limited to maximum allowance of $1\frac{1}{2}$ ins. per 100 ft.)

If limited on account of midship superstructure.

Deduction for Tropical Freeboard.
Addition for Winter and Winter North Atlantic Freeboard.

Depth to Freeboard Deck = 31.04 ✓
Summer freeboard = 5.96 ✓
Moulded draught (d) = 25.08 ✓

Deduction for Tropical freeboard and addition for Winter freeboard = $\frac{d}{4}$ inches = 6.27 = 6½ ✓
Addition for Winter North Atlantic Freeboard (if required) =

Deduction for Fresh Water.

Displacement in salt water at summer load water line
 $\Delta = 11521$ ✓
Tons per inch immersion at summer load water line
 $T = 41.62$ ✓

Deduction = $\frac{\Delta}{40T}$ inches
= $\frac{11521}{40 \times 41.62}$
= 7 ✓

TABULAR FREEBOARD corrected for Flush Deck (if required)

Correction for coefficient $\frac{.720 + .680}{1.36} = \frac{1.400}{1.36} = 1.03$

	+	-
Depth Correction ...	<u>13.23</u>	
Deduction for superstructures ...		<u>15.29</u> ✓
Sheer correction ...		<u>2.47</u> ✓
Round of Beam correction ...		<u>.06</u> ✓
Correction for Thickness of Deck amidships ...		
Other corrections, scantlings, etc. ...		
	<u>13.23</u>	<u>17.82</u>

Summer Freeboard = 71.48 ✓

SUMMER FREEBOARD amidships from Centre of Disc to top of Deck Line, Wood, Steel, Deck:—

Tropical Fresh Water Line above Centre of Disc ...	<u>13½</u> ✓
Fresh Water Line „ „ ...	<u>7</u> ✓
Tropical Line „ „ ...	<u>6½</u> ✓
Winter Line below „ „ ...	<u>6½</u> ✓
Winter North Atlantic Line „ „ ...	

Tropical Fresh Water Freeboard ...	<u>4-10½</u> ✓
Fresh Water „ „ ...	<u>5-4½</u> ✓
Tropical „ „ ...	<u>5-5¼</u> ✓
Winter „ „ ...	<u>6-5¼</u> ✓
Winter North Atlantic „ „ ...	

7 JUL 1932

PARTICULARS OF PROTECTION TO OPENINGS, ETC.

HATCHWAYS ON FREEBOARD AND SUPERSTRUCTURE DECKS									
Description of Hatchway		Nº1 UD	Nº2 UD	Nº3 B&D	Nº3 UD	Nº4 UD	Nº5 UD		
Dimensions of Hatchway		32'6" x 20'	34'8" x 20'	10'10" x 18'	10'10" x 18'	34'8" x 20'	28' x 20'		
COAMINGS	Height above Deck	30"	30"	30"	9"	30"	30"		
	Thickness	44	44	44	44	44	44		
	Sides	44	44	44	44	44	44		
	Ends	44	44	44	44	44	44		
Stiffeners		10" B.A.	10" B.A.	7" B.A.	-	10" B.A.	10" B.A.		
Brackets, Stays		2	2	-	-	2	2		
HATCH BEAMS	Number	6	6	/		6	5		
	Spacing	4'-8"	5'-0"			5'-0"	4'-8"		
	Scantling and Sketch	4x3x44 18"x36"	As N°1			As N°1	As N°1		
	Bearing Surface	3 1/2	3 1/2			3 1/2	3 1/2		
FORE AND AFTERS	Number	/		3	3	/			
	Spacing			4'-6"	4'-6"				
	Unsupported Lengths			10'-10"	10'-10"				
	Scantling* and Sketch			3x3x38 10"x36"	3x3x38 10"x36"				
Bearing Surface		/		3 1/2	3 1/2	/			
HATCH COVERS	Material			Pine	Pine				
	Thickness			2 1/4"	2 1/4"				
	How fitted			F&A	F&A				
	Bearing Surface			3 1/4"	3 1/4"				
Spacing of Cleats		24"	24"	24"	24"	24"	24"		
Number of Tarpaulins		3	3	3	3	3	3		
<p>*Are wood fore and afters steel shod at all bearing surfaces? <i>Yes</i></p> <p>Are battens and wedges efficient and in good condition? <i>Yes</i></p> <p>Are tarpaulins in good condition and in accordance with rule requirements? <i>Yes on Weather St.</i></p> <p>Are lashings provided in accordance with rule requirements? <i>Yes</i></p>									

Particulars of fiddle, funnel and ventilator coamings:—

Fiddle gratings fitted with hinged plate covers.
Ventilator & funnel coamings in good order.
E.R. Skylight Steel strongly constructed

Particulars of Flush Bunker Scuttles:—

None

Particulars of Companionways:—

None.

Particulars of Ventilators in exposed positions on freeboard and superstructure decks:—

Forecastle:—	2 @ 4" SN x 10 1/2" high to file	Bridge St.	3 @ 10" x 18" high	to B&D Space	Wood plugs and Canvas covers fitted ex. to SN vents
	2 @ 18" x 16" " " hold		2 @ 18" x 36" " " hold	" " hold	
	1 @ 9" x 21" " " F.P. STORE.		1 @ 12" x 12" (M.V.)	" Bunkers	
			1 @ 14" x 15" (M.V.)	" GF Settling	
Fore Well St.	4 @ 18" x 36" " " hold	Poop St.	2 @ 12" x 18" " " hold	" " hold	
Aft " "	6 @ 18" x 36" " " "		2 @ 18" x 16" " " hold	" " hold	

Particulars of Air Pipes in exposed positions on freeboard, raised quarter, or superstructure decks:—

Forecastle:—	1 @ 4" x 7" high to F.P.	Bridge Deck:—	2 @ 3" x 33" high to DRS	No closing appliances fitted.
	1 @ 3" x 12" " " D.B.		2 @ 2" x 20" " " F.W.	
			2 @ 2" x 12" " " B&D	
			1 @ 2" x 24" " " F.W.	
Fore Well St.	6 @ 3" x 33" " " D.B.	Poop:—	2 @ 2 1/2" x 14" high to A.P.	Canvas covers fitted for closing air pipes
Aft Well St.	4 @ 3" x 31" " " "			
	1 @ 3" x 12" " " "			

Particulars of Gangway Cargo and Coaling Ports:—

None.



© 2020

Lloyd's Register Foundation

Particulars of Scuppers and Sanitary Discharge Pipes:—

Discharges amidships aft led overboard above freeboard deck & fitted with storm valves.

Particulars of Side Scuttles:—

All fitted with fixed hinged deadlights.

Particulars of Guard Rails:—


Forecastle:— Rails 3' high; 2 rods; Stanchions 5'-0" apart.
Bridge:— " 3'-6" " ; 3 " ; " 4'-6" "
Poop:— " 3'-3" " ; 2 " ; " 5'-0" "

Particulars of Gangways, Lifelines, etc.:—

Eyeplates & stretching screws &c provided but not yet fitted.

Crew Aft.

Particulars of Freeing Arrangements.

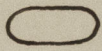	Length of Bulwark	Height of Bulwark	Size of Freeing Ports	Number each side	Area each side	Rule area each side
After Well ...	99'-8"	3'-7"	16" x 3'-6" 	3-5	21.5 \$ 12.9 Sqft	19.93
Forward Well ...	99'-8"	3'-7"	16" x 3'-6" "	3-5	21.5 \$ 12.9 Sqft	19.9

State position of each freeing port ... } After Well:— 18 1/2, 47' & 86' from Bt. ; 12" Sills
(F. and A. position and height above deck edge) } Forward Well:— 19' 36' & 64' " " ; " "
State whether the freeing ports are fitted with shutters, bars, or rails, and give particulars of such:—
2 bars to each port.

Additional area where sheer is less than standard.

Particulars of Superstructures, Trunks, Casings, Deckhouses.

	Coaming	Plating	Stiffeners	Spacing	End Attachments of Stiffeners	Size of Openings	Height of Sills	Height of Casings
Poop Bulkhead ...	39" x 44	.40	6 x 3 1/2 x 38 BA	27"	none	205' x 2'	18"	7-11 1/2
Raised Quarter Deck Bulkhead ...						206' x 3'-6"	18"	7-11 1/2
Bridge, After Bulkhead ...	36" x 32	.30	3 x 3 x 32	30"	none. Brackets T & B.	104' 9" x 2'-6"	18"	7-11 1/2
Bridge, Forward Bulkhead ...	42" x 44	.40	9 x 3 1/2 x 56 BA	30"	none.	205' x 2'	18"	7-11 1/2
Forecastle Bulkhead ...	39" x 34	.30	3 x 3 x 32	39"	none.	206' 5" x 3'-6"	18"	7-11 1/2
Trunk, Aft ...								
Trunk, Forward ...								
Exposed Machinery Casings on Freeboard or Raised Quarter Decks ...	Vert.	.40	4" flange	30"	-	305' 6" x 2'	18"	7-6" } 94'-0" }
Exposed Machinery Casings on Superstructure Decks ...								
Machinery Casings within Superstructures not fitted with Class I Closing Appliances ...	"	.40	" "	30"	Contin.	205' 6" x 2'	-	7-11 1/2
Deckhouses on Flush Deck Ships ...								

Particulars of Closing Appliances (state if capable of being manipulated from both sides).

Poop Bulkhead ...	2 hinged steel doors operated from both sides
Raised Quarter Deck Bulkhead ...	{ 1 Hinged Steel door to E.R. in 2 halves operated from both sides. 2 x 2 1/2" Shifting Boards full h. in riveted channels
Bridge, After Bulkhead ...	
Bridge, Forward Bulkhead ...	2 hinged steel doors operated from both sides 2 x 2 1/2" Shifting Boards full height in riveted channels.
Forecastle Bulkhead ...	
Exposed Machinery Casings on Freeboard or Raised Quarter Decks ...	
Exposed Machinery Casings on Superstructure Decks ...	3 hinged steel doors Operated from both sides
Machinery Casings within Superstructures not fitted with Class I Closing Appliances ...	2 " " " " " "
Deckhouses on Flush Deck Ships ...	




© 2020

Lloyd's Register Foundation

W343-0036(2/2)

Benwarlich

Superstructure bulkheads, trunks, deckhouses, casings, cargo and coaling hatchways, extent and thickness of sheathing on the freeboard deck, gangway, cargo and coaling ports, and any other openings, etc., which would affect the seaworthiness of the ship are to be shown on the following sketches:—

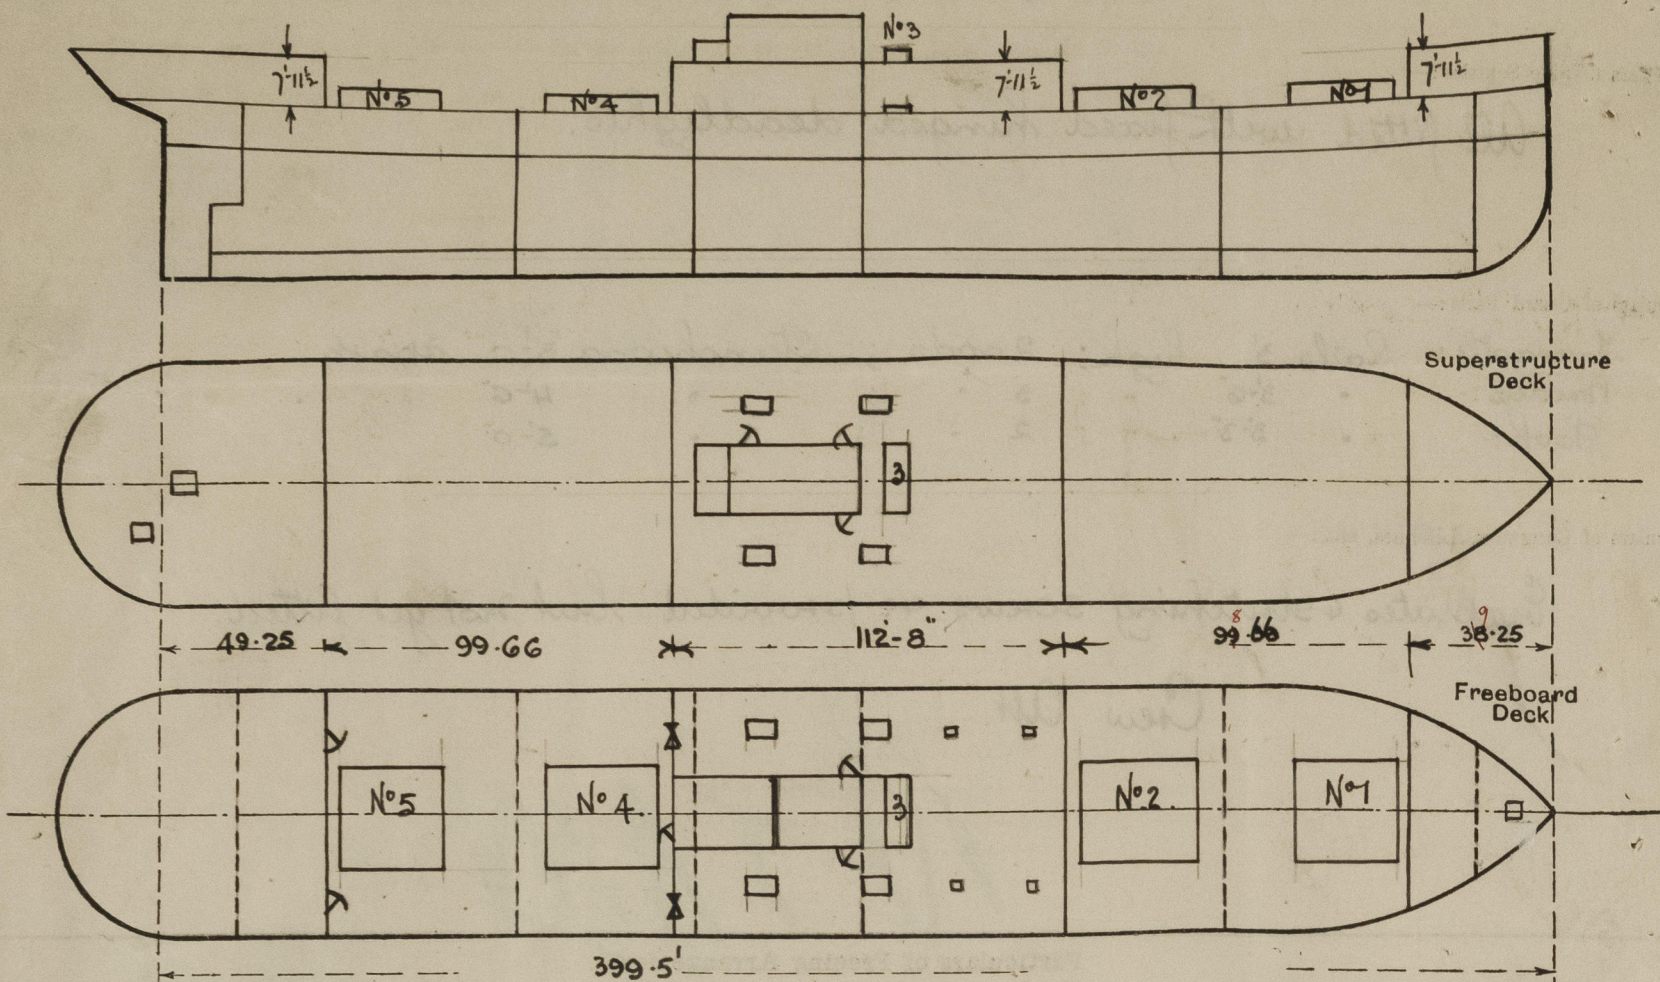

Disp't. at 28'-0" = 12890 tons
 " " 25'-3" = 11500 "
 T.P.1 " 25'-3" = 41.61


State any special features in the construction of the ship:—

Small hatches:—

- 1 B.F.P. on W.B. 3' x 3' x 6' high with covers cleats battens & tarpaulins
- 1 to A.P. " Poop. 31" x 24" x 15" " " " " "
- 1 " " " 40" x 40" x 18" " " " " "
- 4 on B.B. to Bunkers 8'-3" x 4'-6" x 18" high " " " " "
- 4 " W " " 8'-6" x 4'-6" x 9" " " " " "
- 1 " " Escape. 2'-6" x 2' x 9" " " " " "
- 4 " " " 2' x 2' x 9" " " " " "

Timber Deck Assignment:—

- ① Eye plates for lashings fitted ~~but a few~~ *addl required (efficiently spaced)*
- ② ~~No~~ *strong angle* sockets for uprights fitted on deck.
- ④ No permanent protection for steering rods & fitted
- ③ h°2, 3 & 4 D.B.s are reasonably W.T. at M.L. & have wing suction fitted

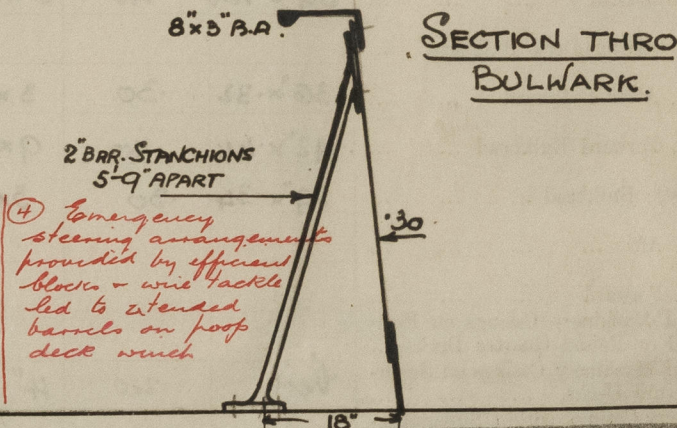

Builder's name and yard number

C. Connell & Co. Ltd. h.

Names of sister ships

"B" STANDARD

Owners

Ben Line Steamers Ltd (W. Thomson & Co. Mgrs)

Fee £

13 : 12 : 0

Received by me

5/7/32



© 2020

Lloyd's Register Foundation