



3. 5. 21.

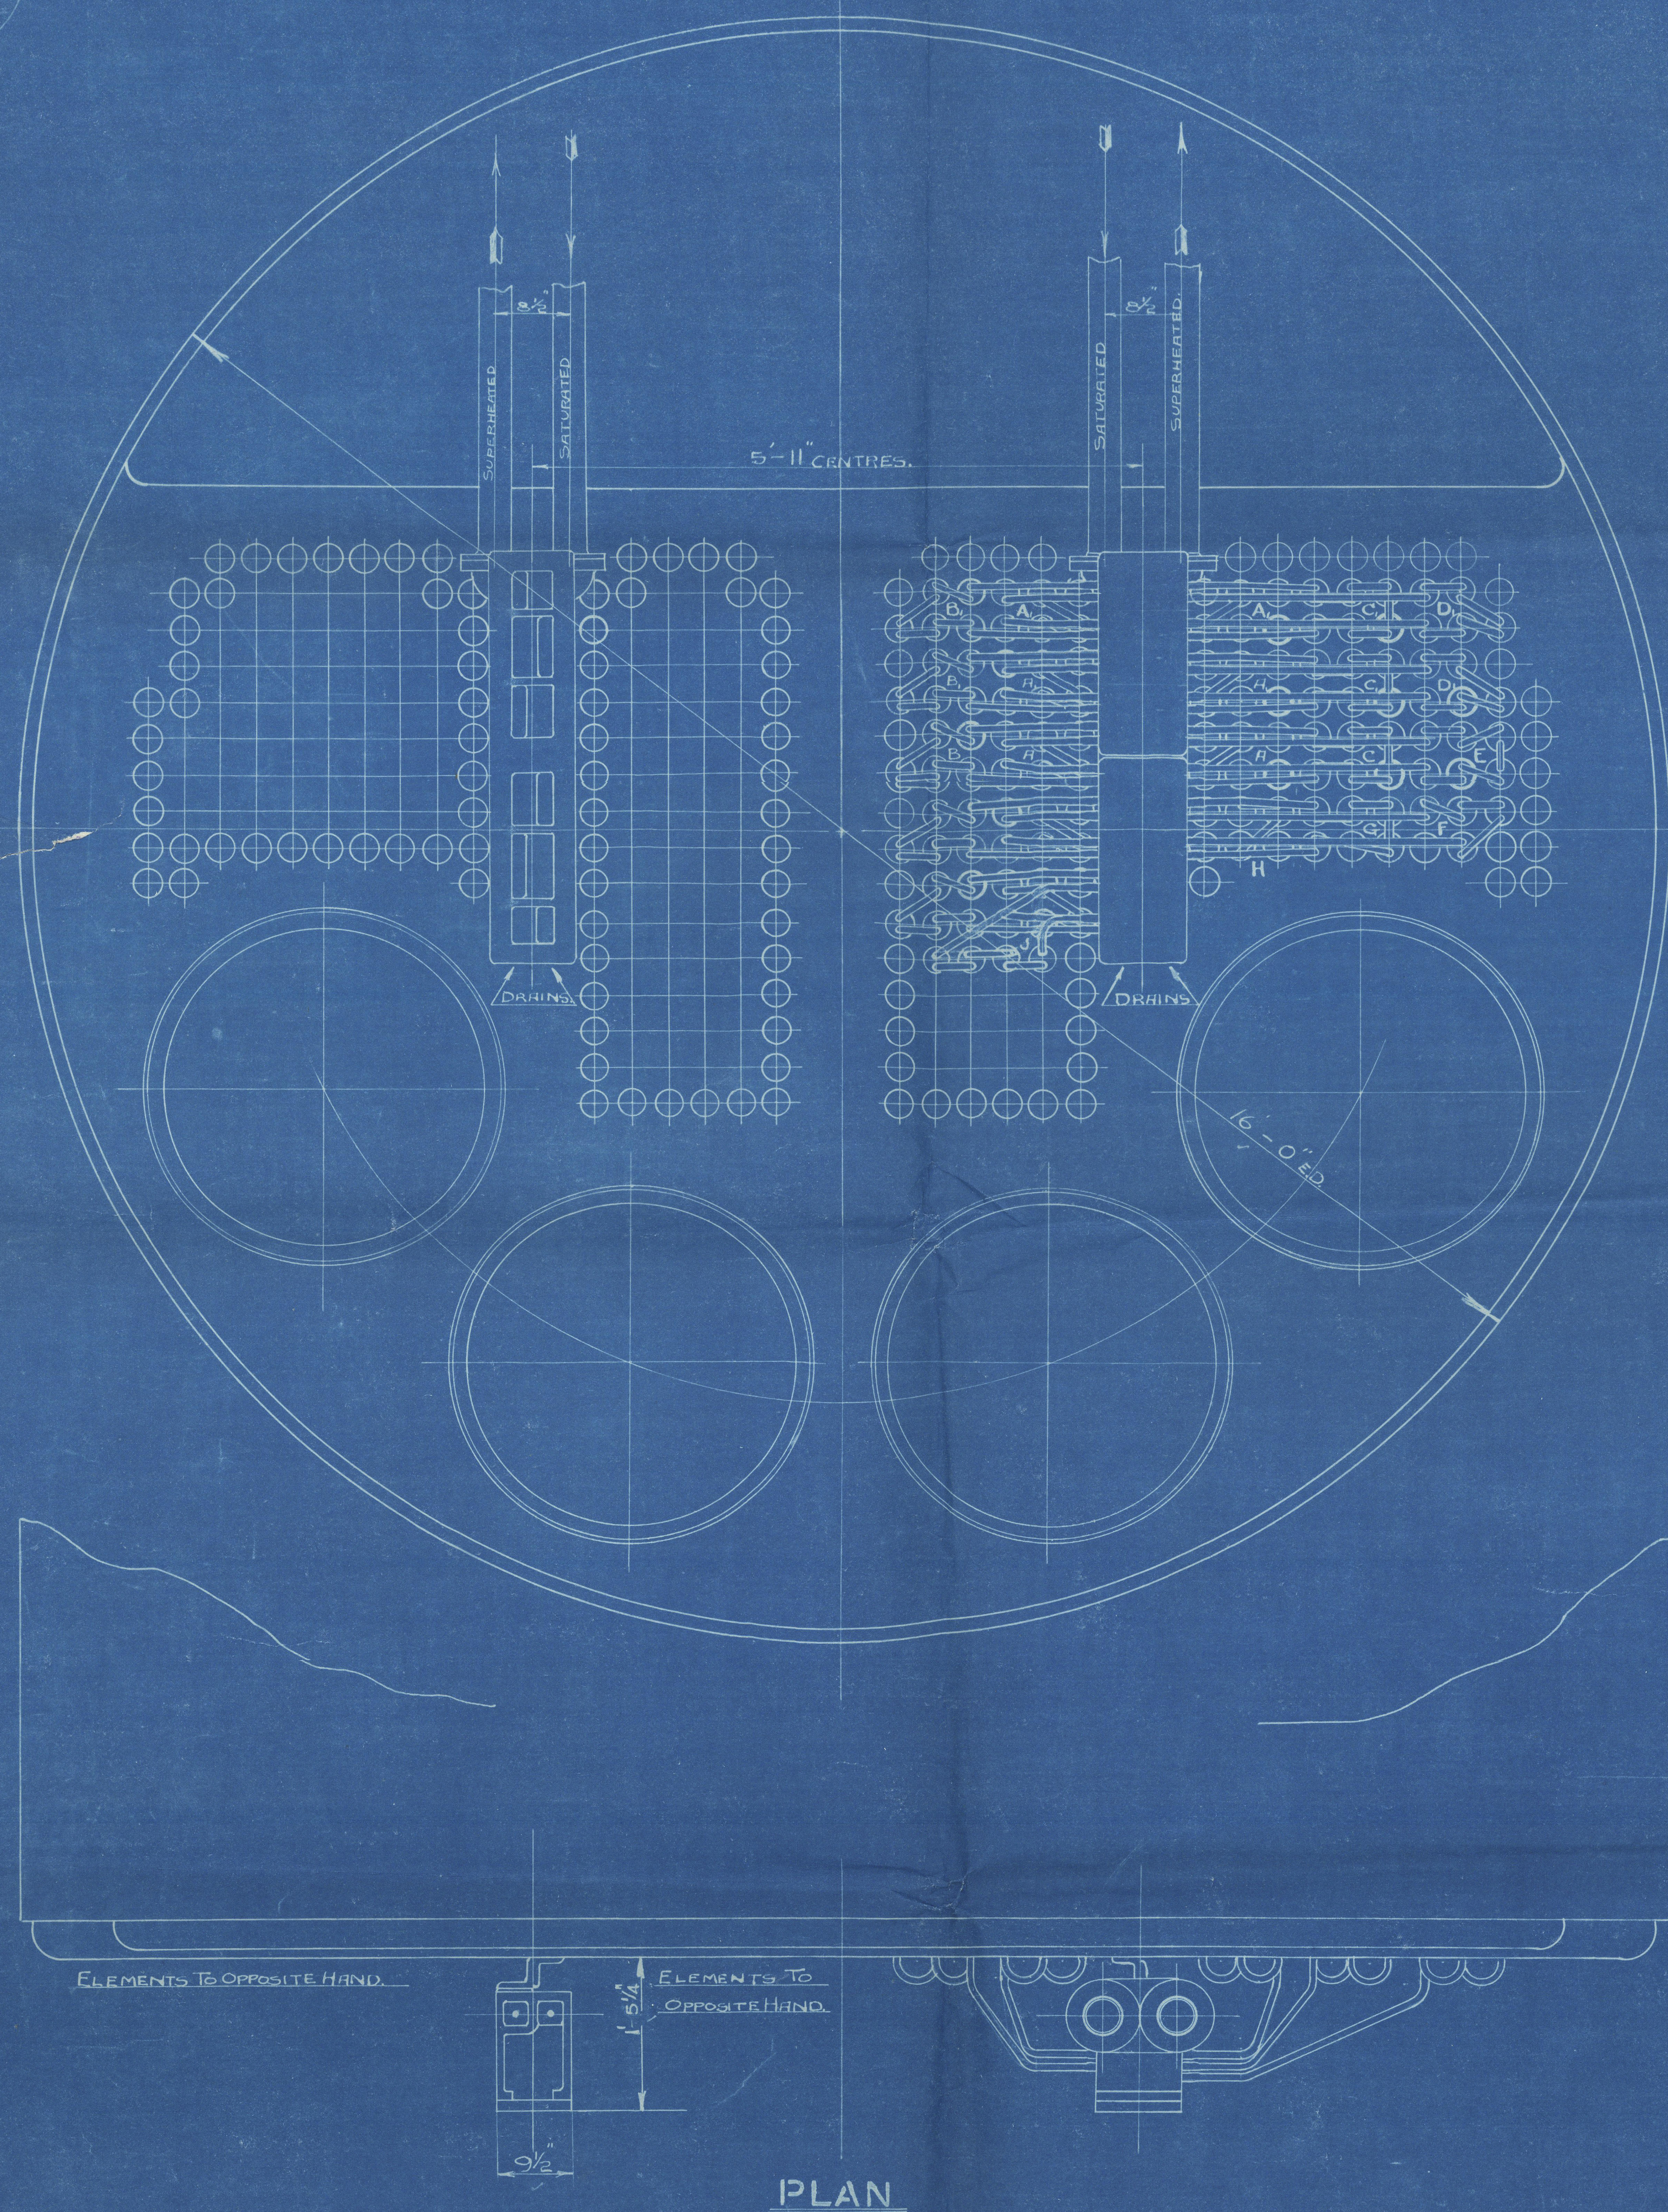


PLAN

SCALE 1 INCH = 1 FOOT.

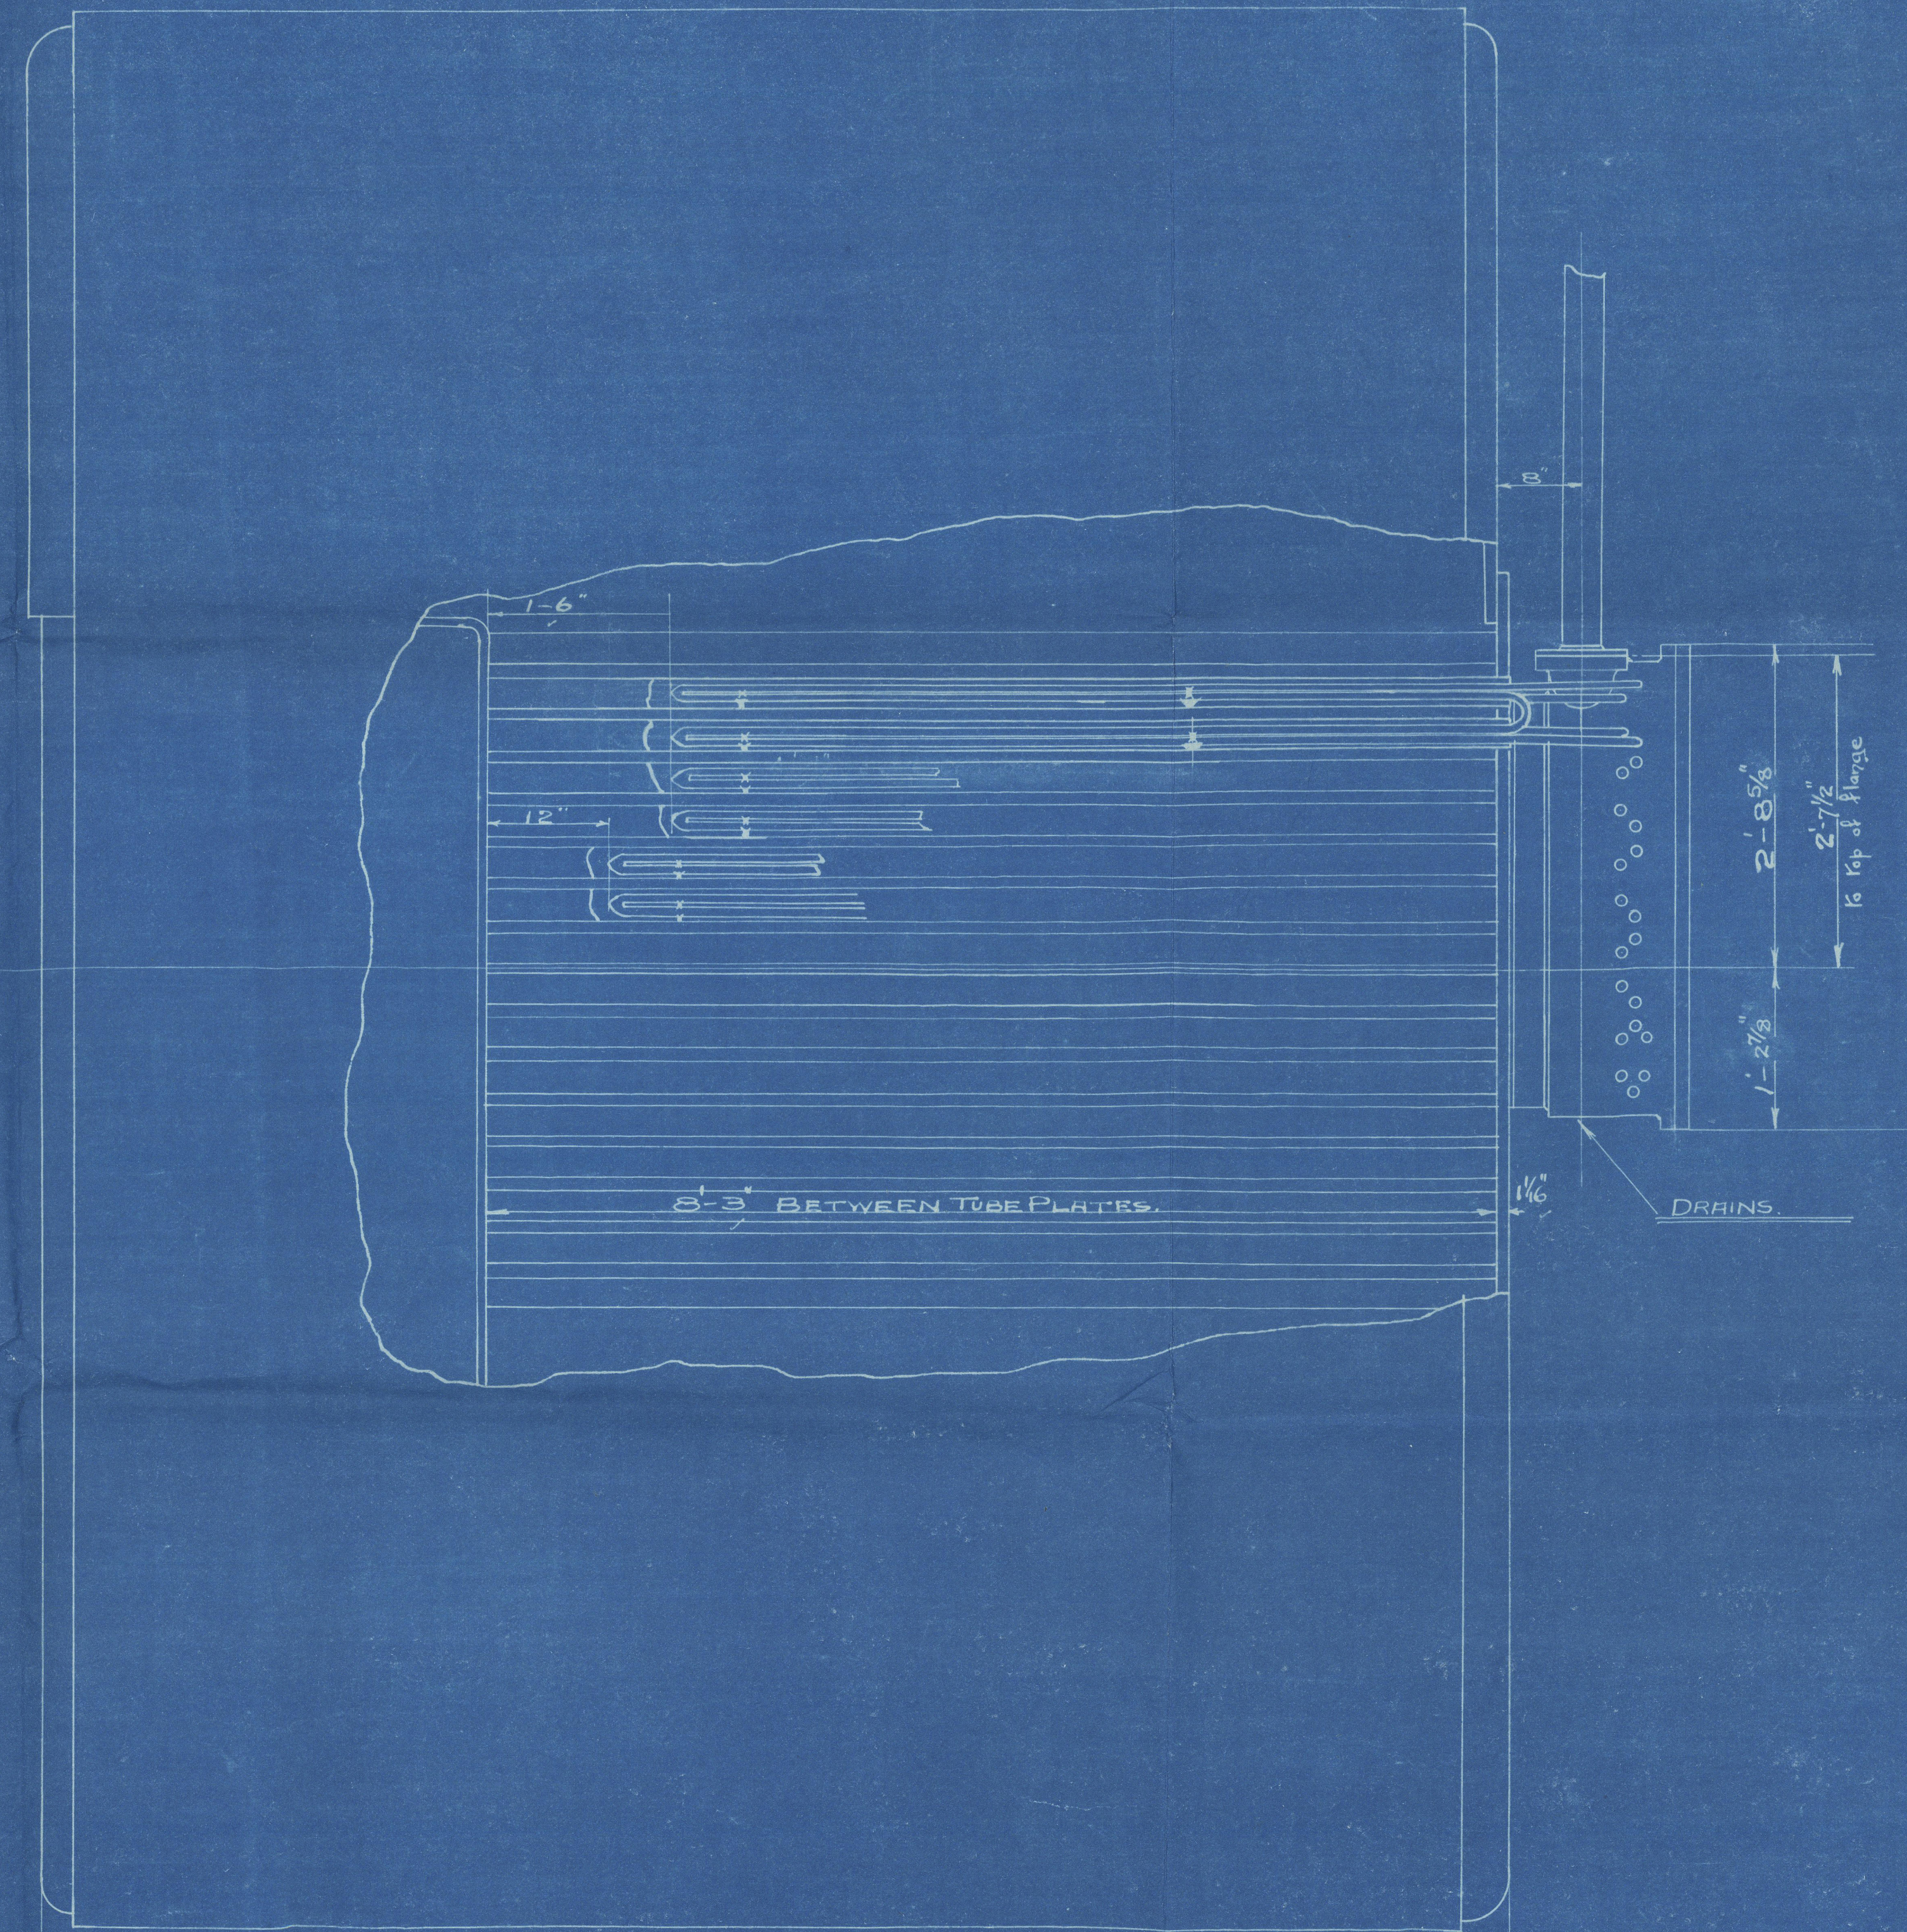

12'-0" MEAN LENGTH.

TOTAL HEATING SURFACE OF S.E. BOILER.	2879. # ✓
" " " ELEMENTS (EXT).	854. # ✓
" SUPERFICIAL AREA OF INSIDE OF ELEMENTS	640. # ✓
CROSS AREA OF ELEMENT PIPES	1944. ✓

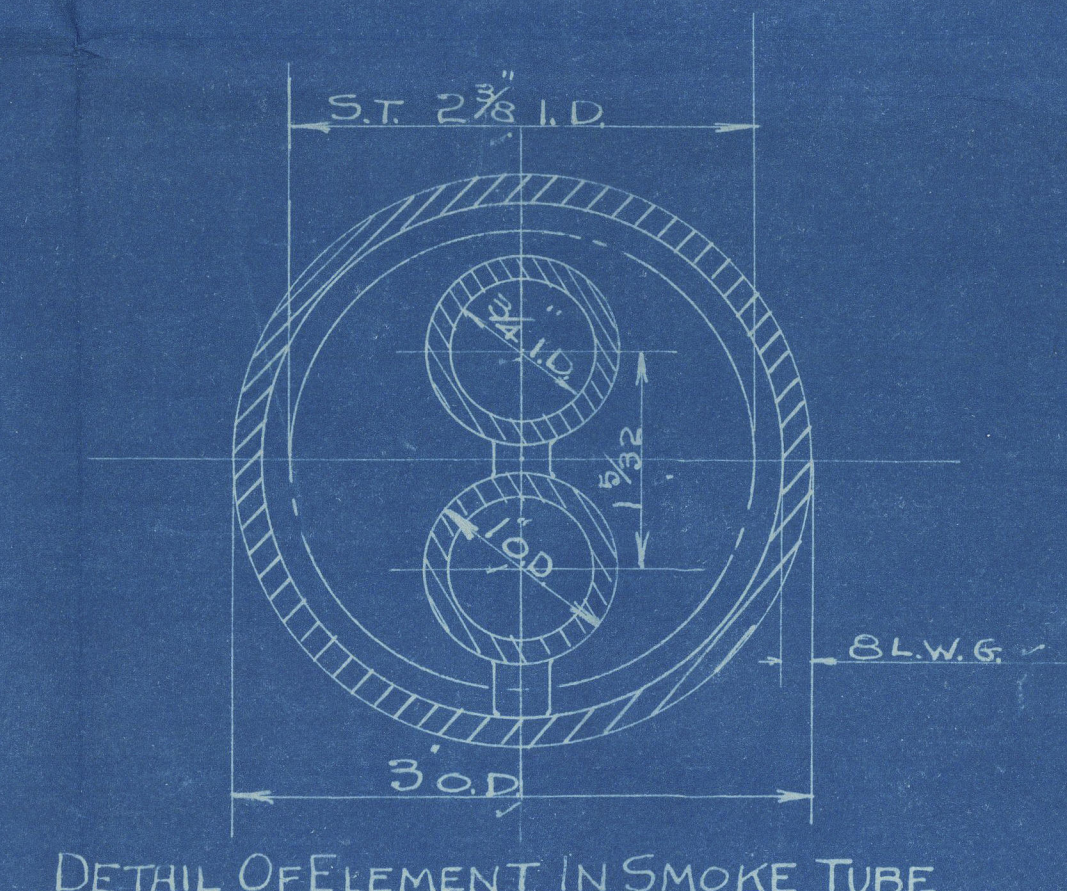

DETAIL OF ELEMENT IN SMOKE TUBE.

ARRANGEMENT OF THE "ROBINSON" MARINE SUPERHEATER

THE SUPERHEATER CORP. LTD
14, NEW BURLINGTON STREET, LONDON, W.1

MARINE DEPT

DRAWING NO. M 450/B.B.

DATE 3/1/21

Handwritten signature and date:
3/1/21

Robinsons Superheater

Palmer No 926 & 934

926.

British General.

Nwc. 75875 -

934

British Officer

NEWCASTLE ON TYNE.

Report No. 1/6/16/1

Arrangement of the Robinson
Superheater

British Captain
NEWCASTLE ON TYNE.

Report No. 1/6/14/08

"British Elfman"

NEWCASTLE ON TYNE.

Report No. 1/6/14/15.

W346-0134

LR

© 2020

Lloyd's Register
Foundation