

T.S.S. "ORAMA" also OTRAMTO.



PROPOSED MODIFICATIONS ON H DECK FRAMES 147-163.

SCALES - PROFILES $\frac{1}{8}$ INCH = 1 FOOT. PLANS $\frac{1}{16}$ INCH = 1 FOOT.

17.1.36




ELEVATION 8'-0" P.S.S.

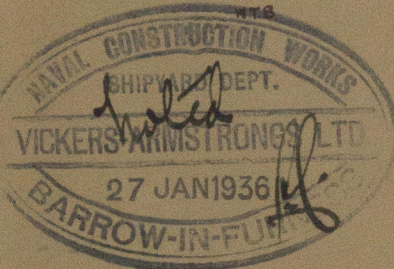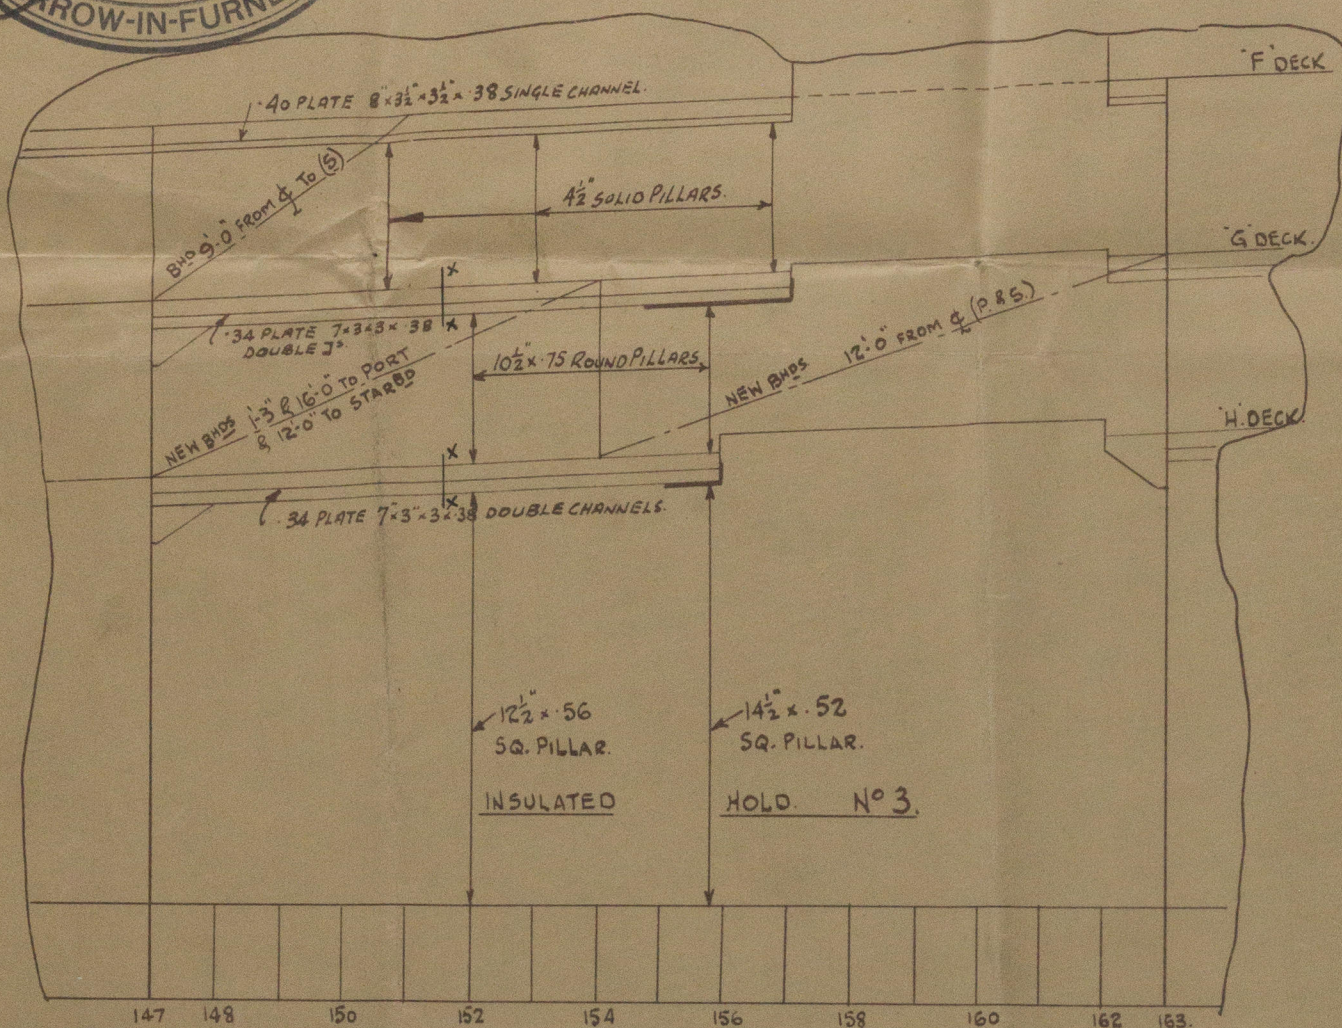


- NOTES:- 1. 3RD CLASS ACCOMMODATION OR CARGO ON G DECK
2. INSULATED CARGO CHAMBERS ARRANGED ON H DECK
WITH 1 TIER HANGING CARGO UNDER G DECK.
3. HATCH SPACE NOT INSULATED.
4. SPACES FOR HANGING CARGO TINTED IN RED.


ELEVATION 24'-0" P.S.S.

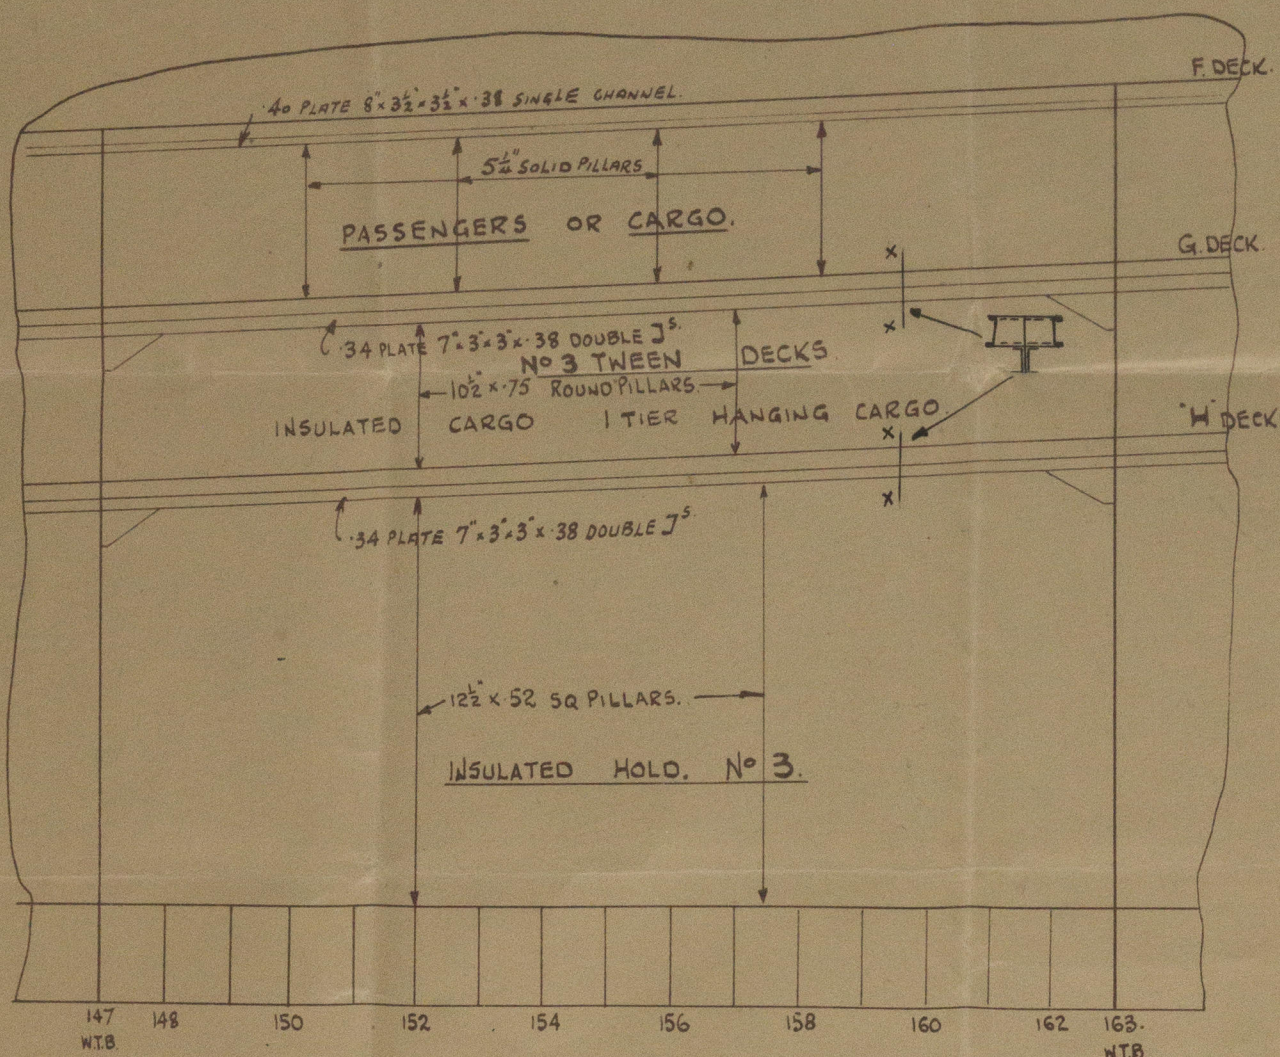

G DECK

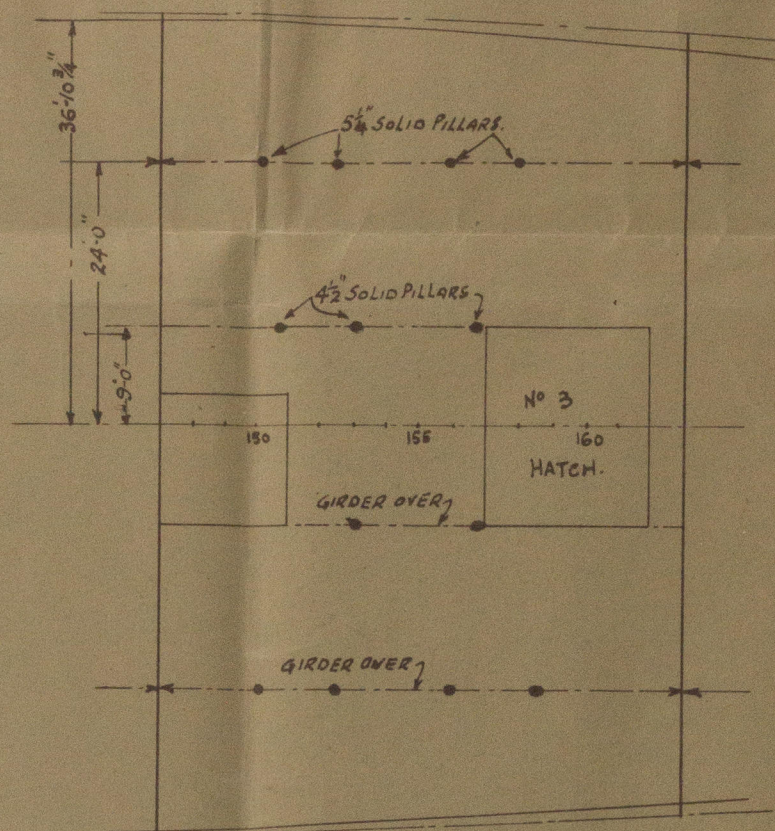


H DECK

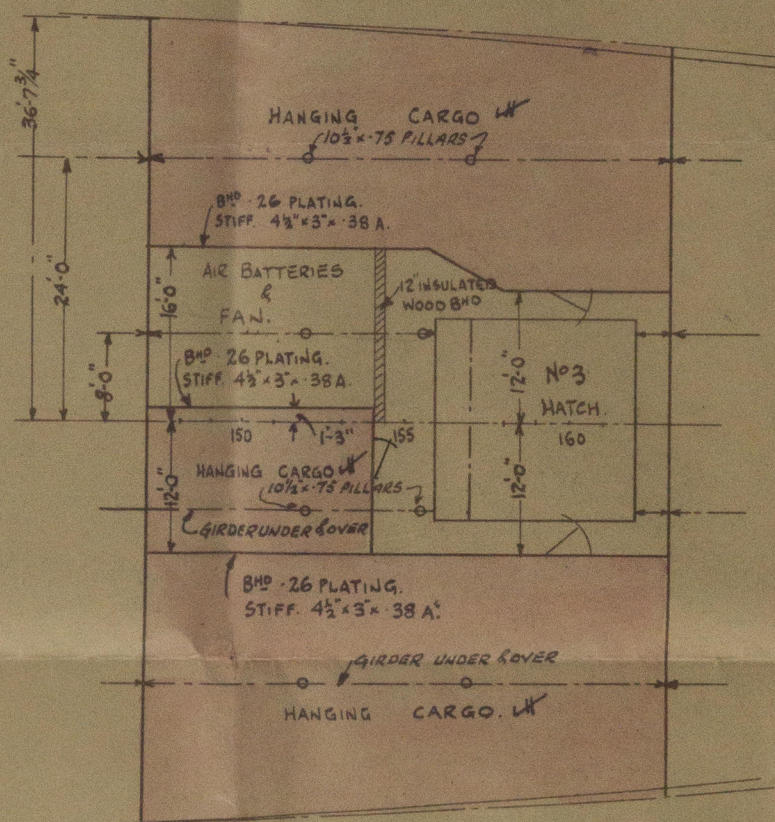

W GASTIGHT CHAMBERS.


LONG BULKHEADS.

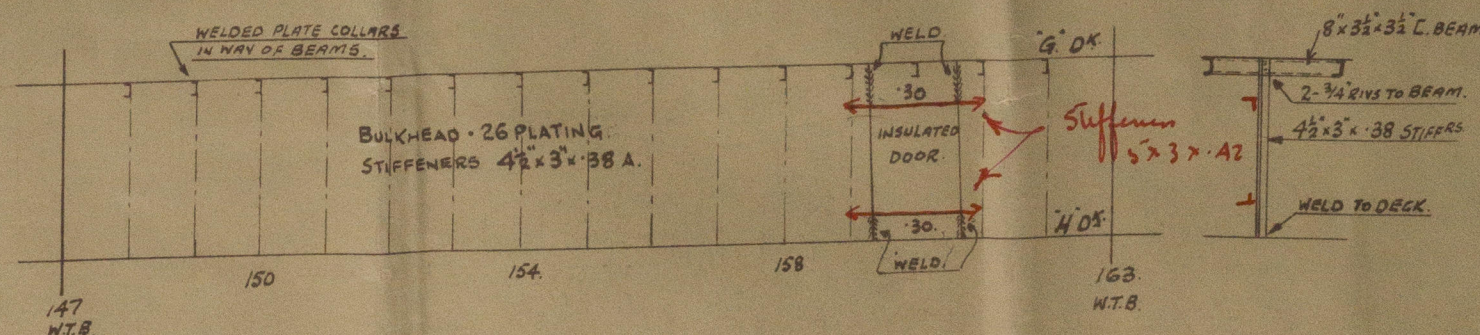

PLAN NO 8.

W348-0029

27.1.36

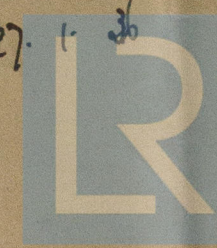

© 2020
Lloyd's Register
Foundation

T. S. S. ORAMA

Proposed Modifications to
Lower Tweendecks H & G decks
N° 3 Hold

Burrows. Report No. 2600.

© 2020

LR

W348 + 0029
Lloyd's Register
Foundation