


STEEL BOILER 12-6 DIA 11-0 LONG 180 LBS W.P.

LLOYDS

~~4806-7~~
5255




Shell Plates 10' 3" Wide
15 Pitches. 116 Holes. 7 1/8" Pitch

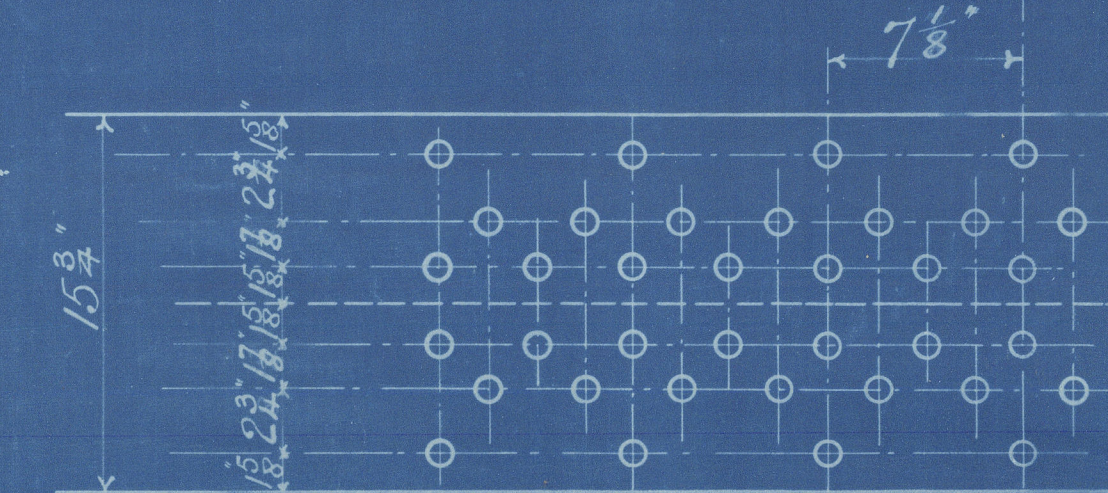

Buttstraps 3/8" thick outside 1/4" thick inside
Tensile 28 to 32 tons.
Holes drilled in position.

Circum Beams 116 Holes 3 1/8" Pitch To be continuous below furnace line

RILEY BROS. (BOILERMAKERS) LTD.
STOCKTON ON TEES.

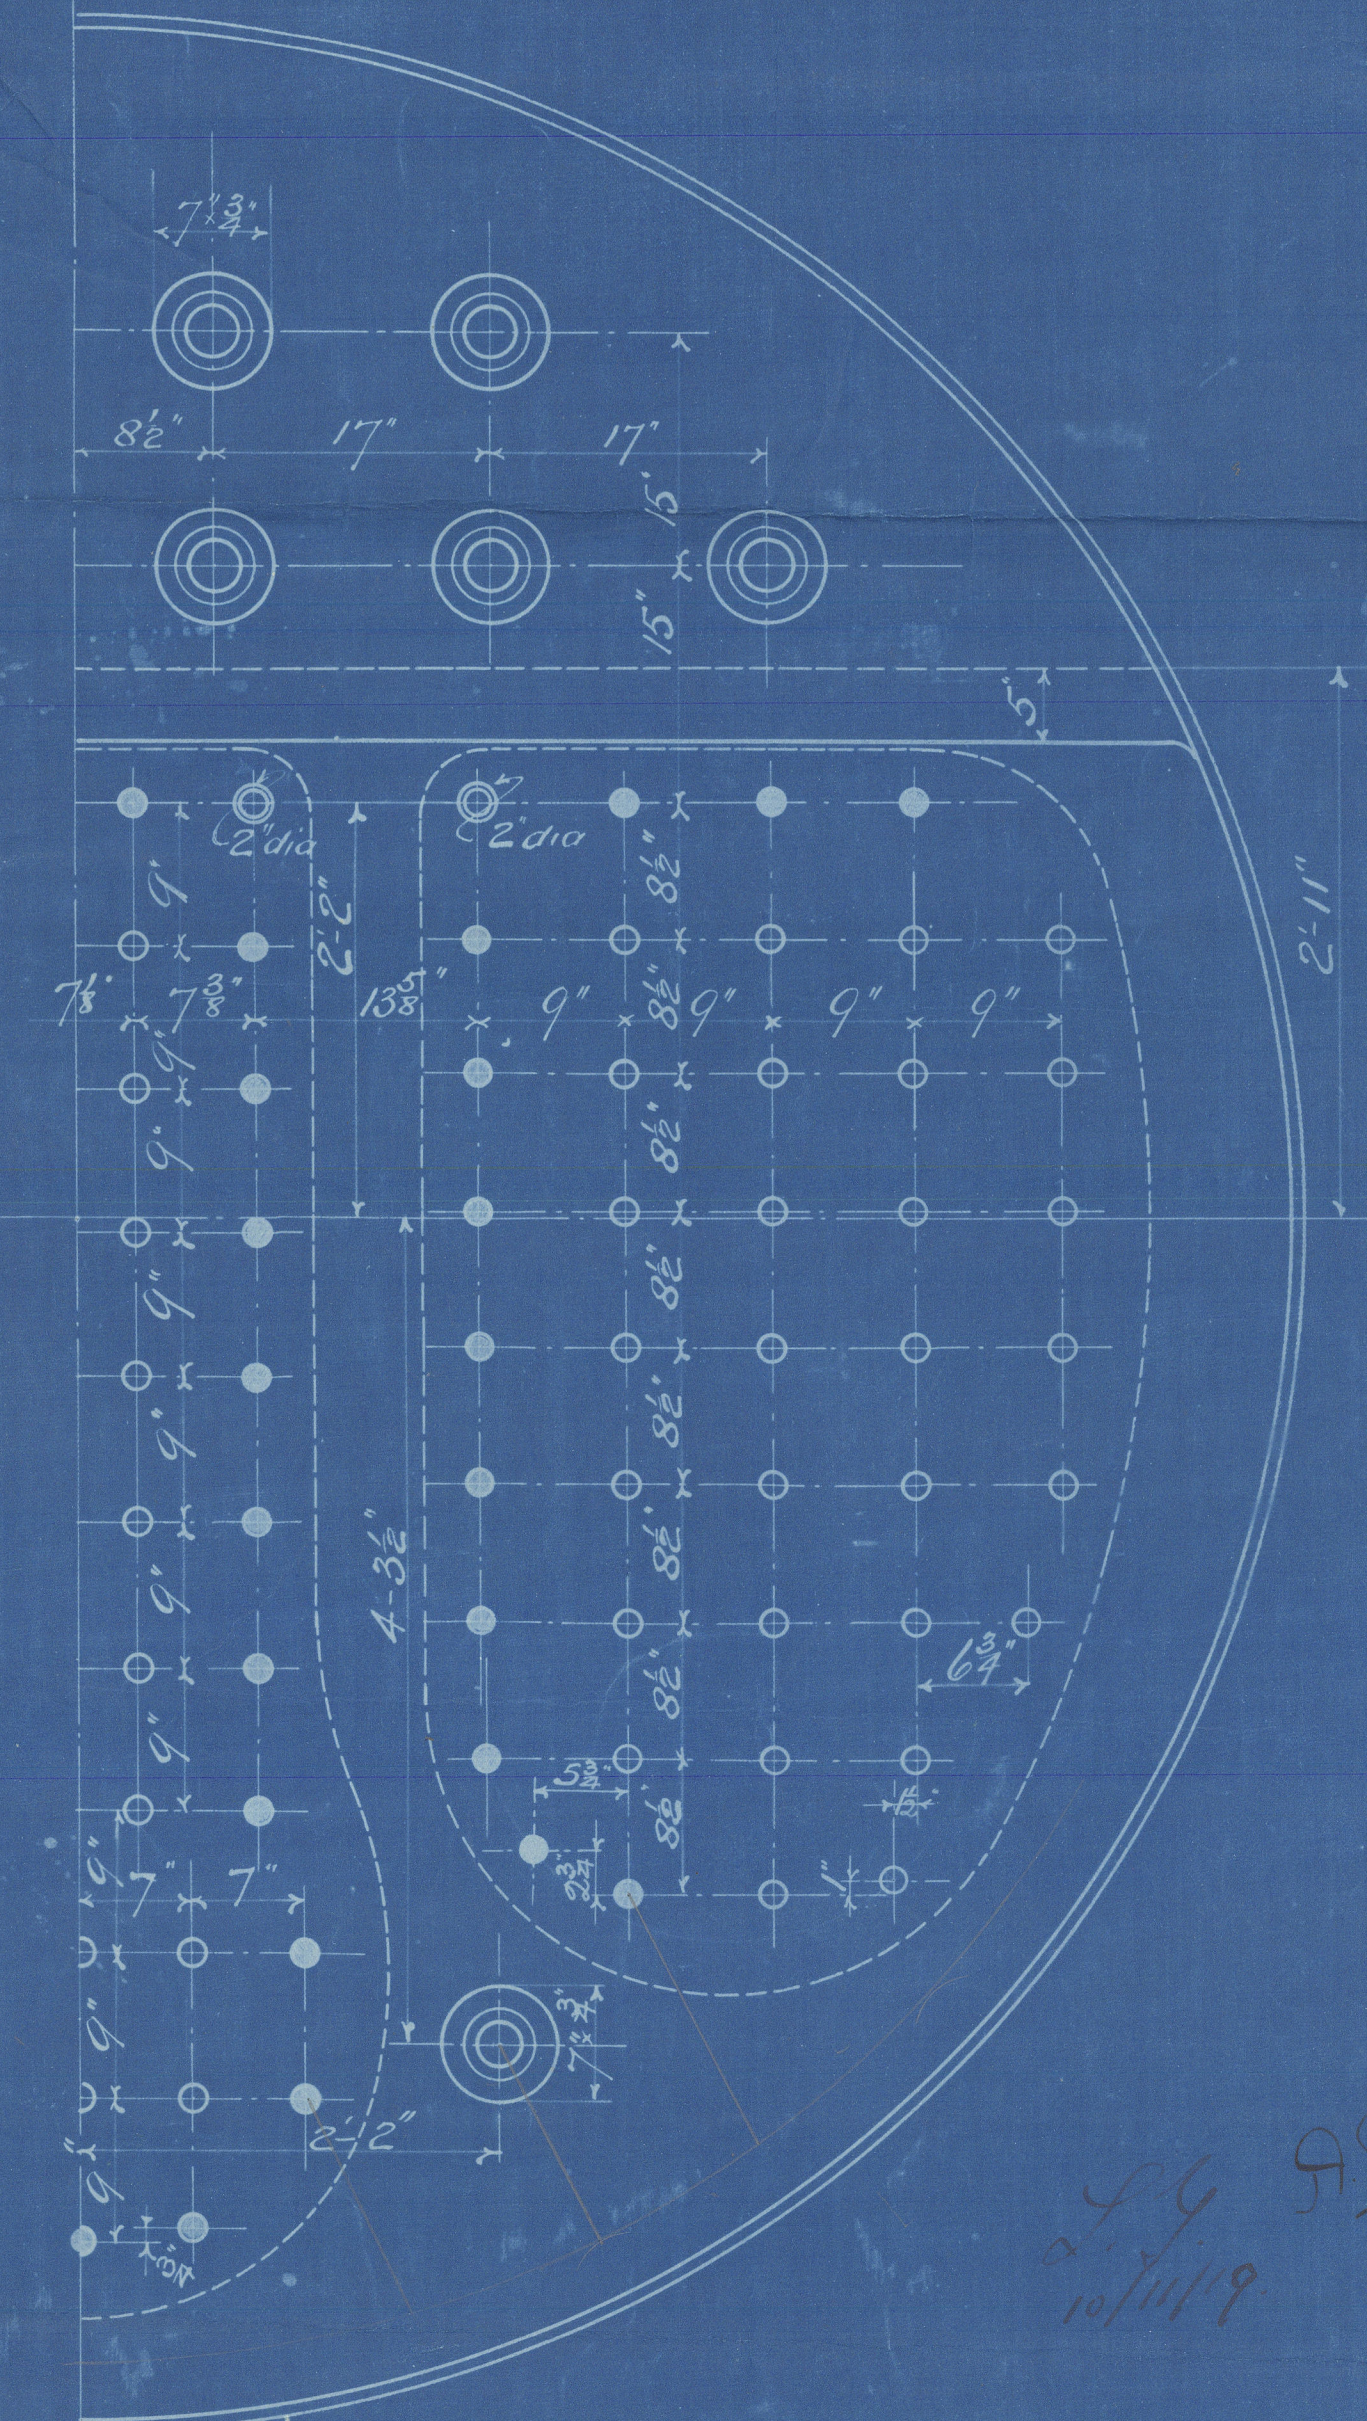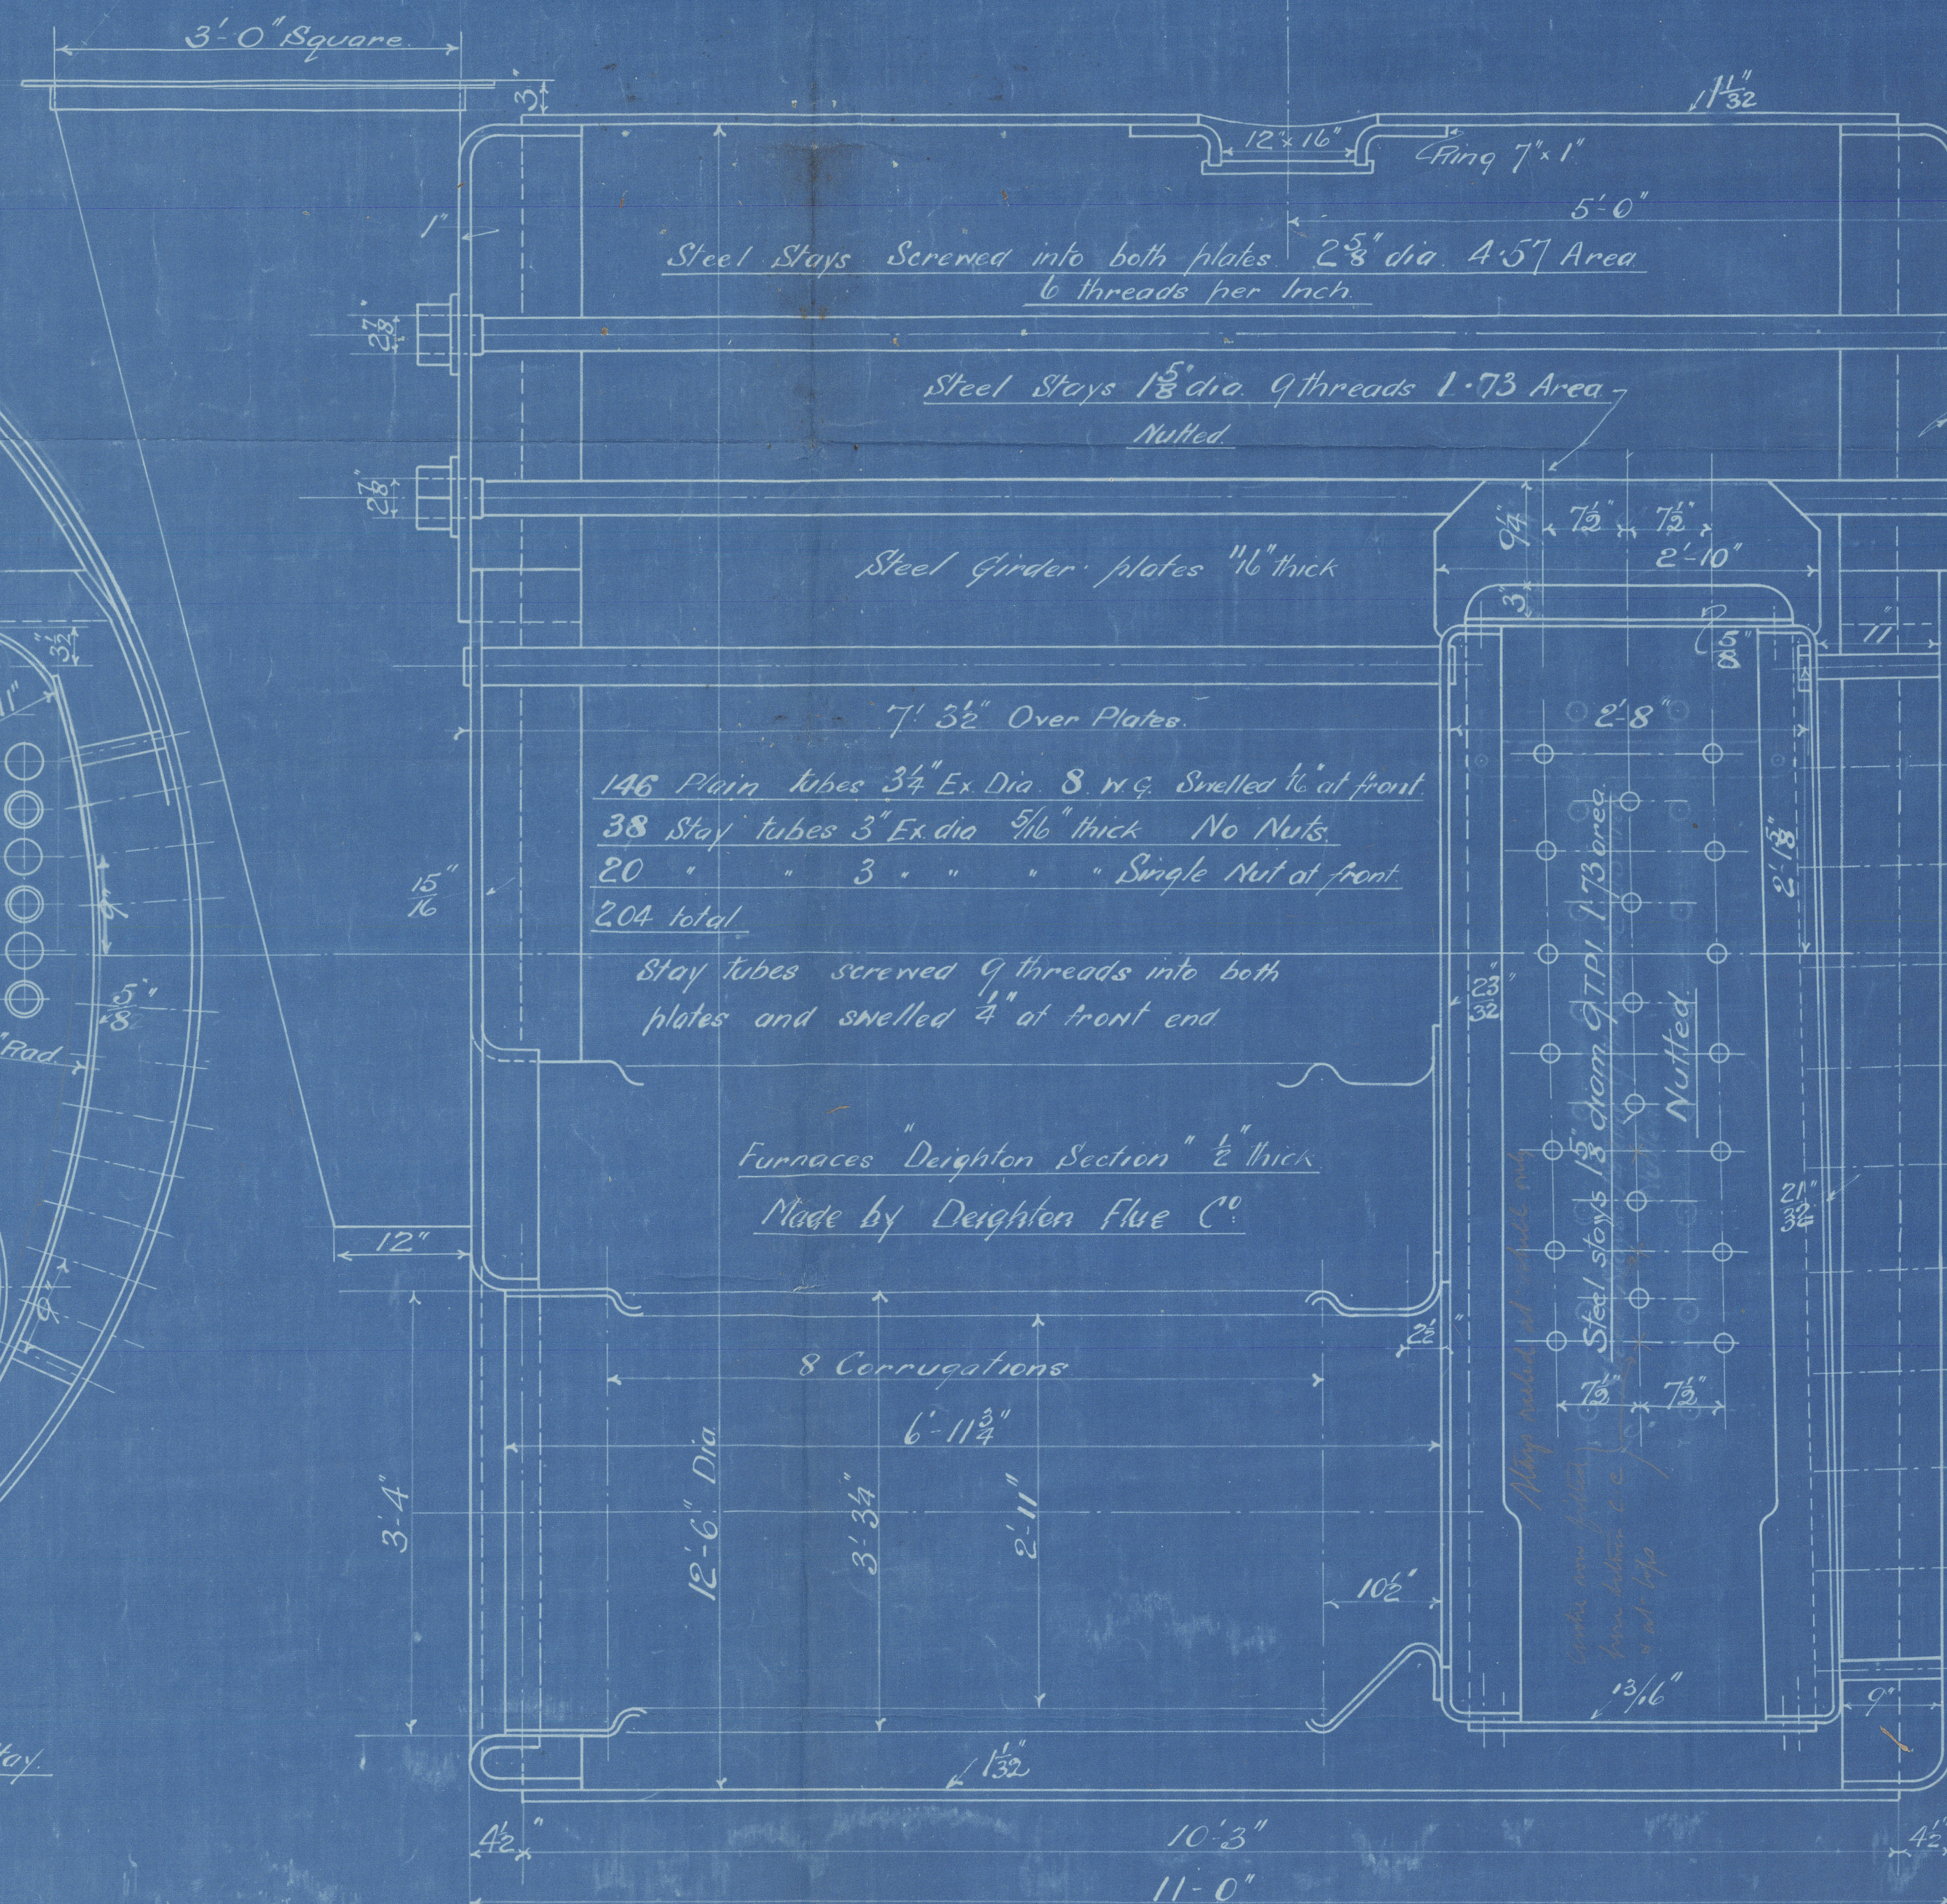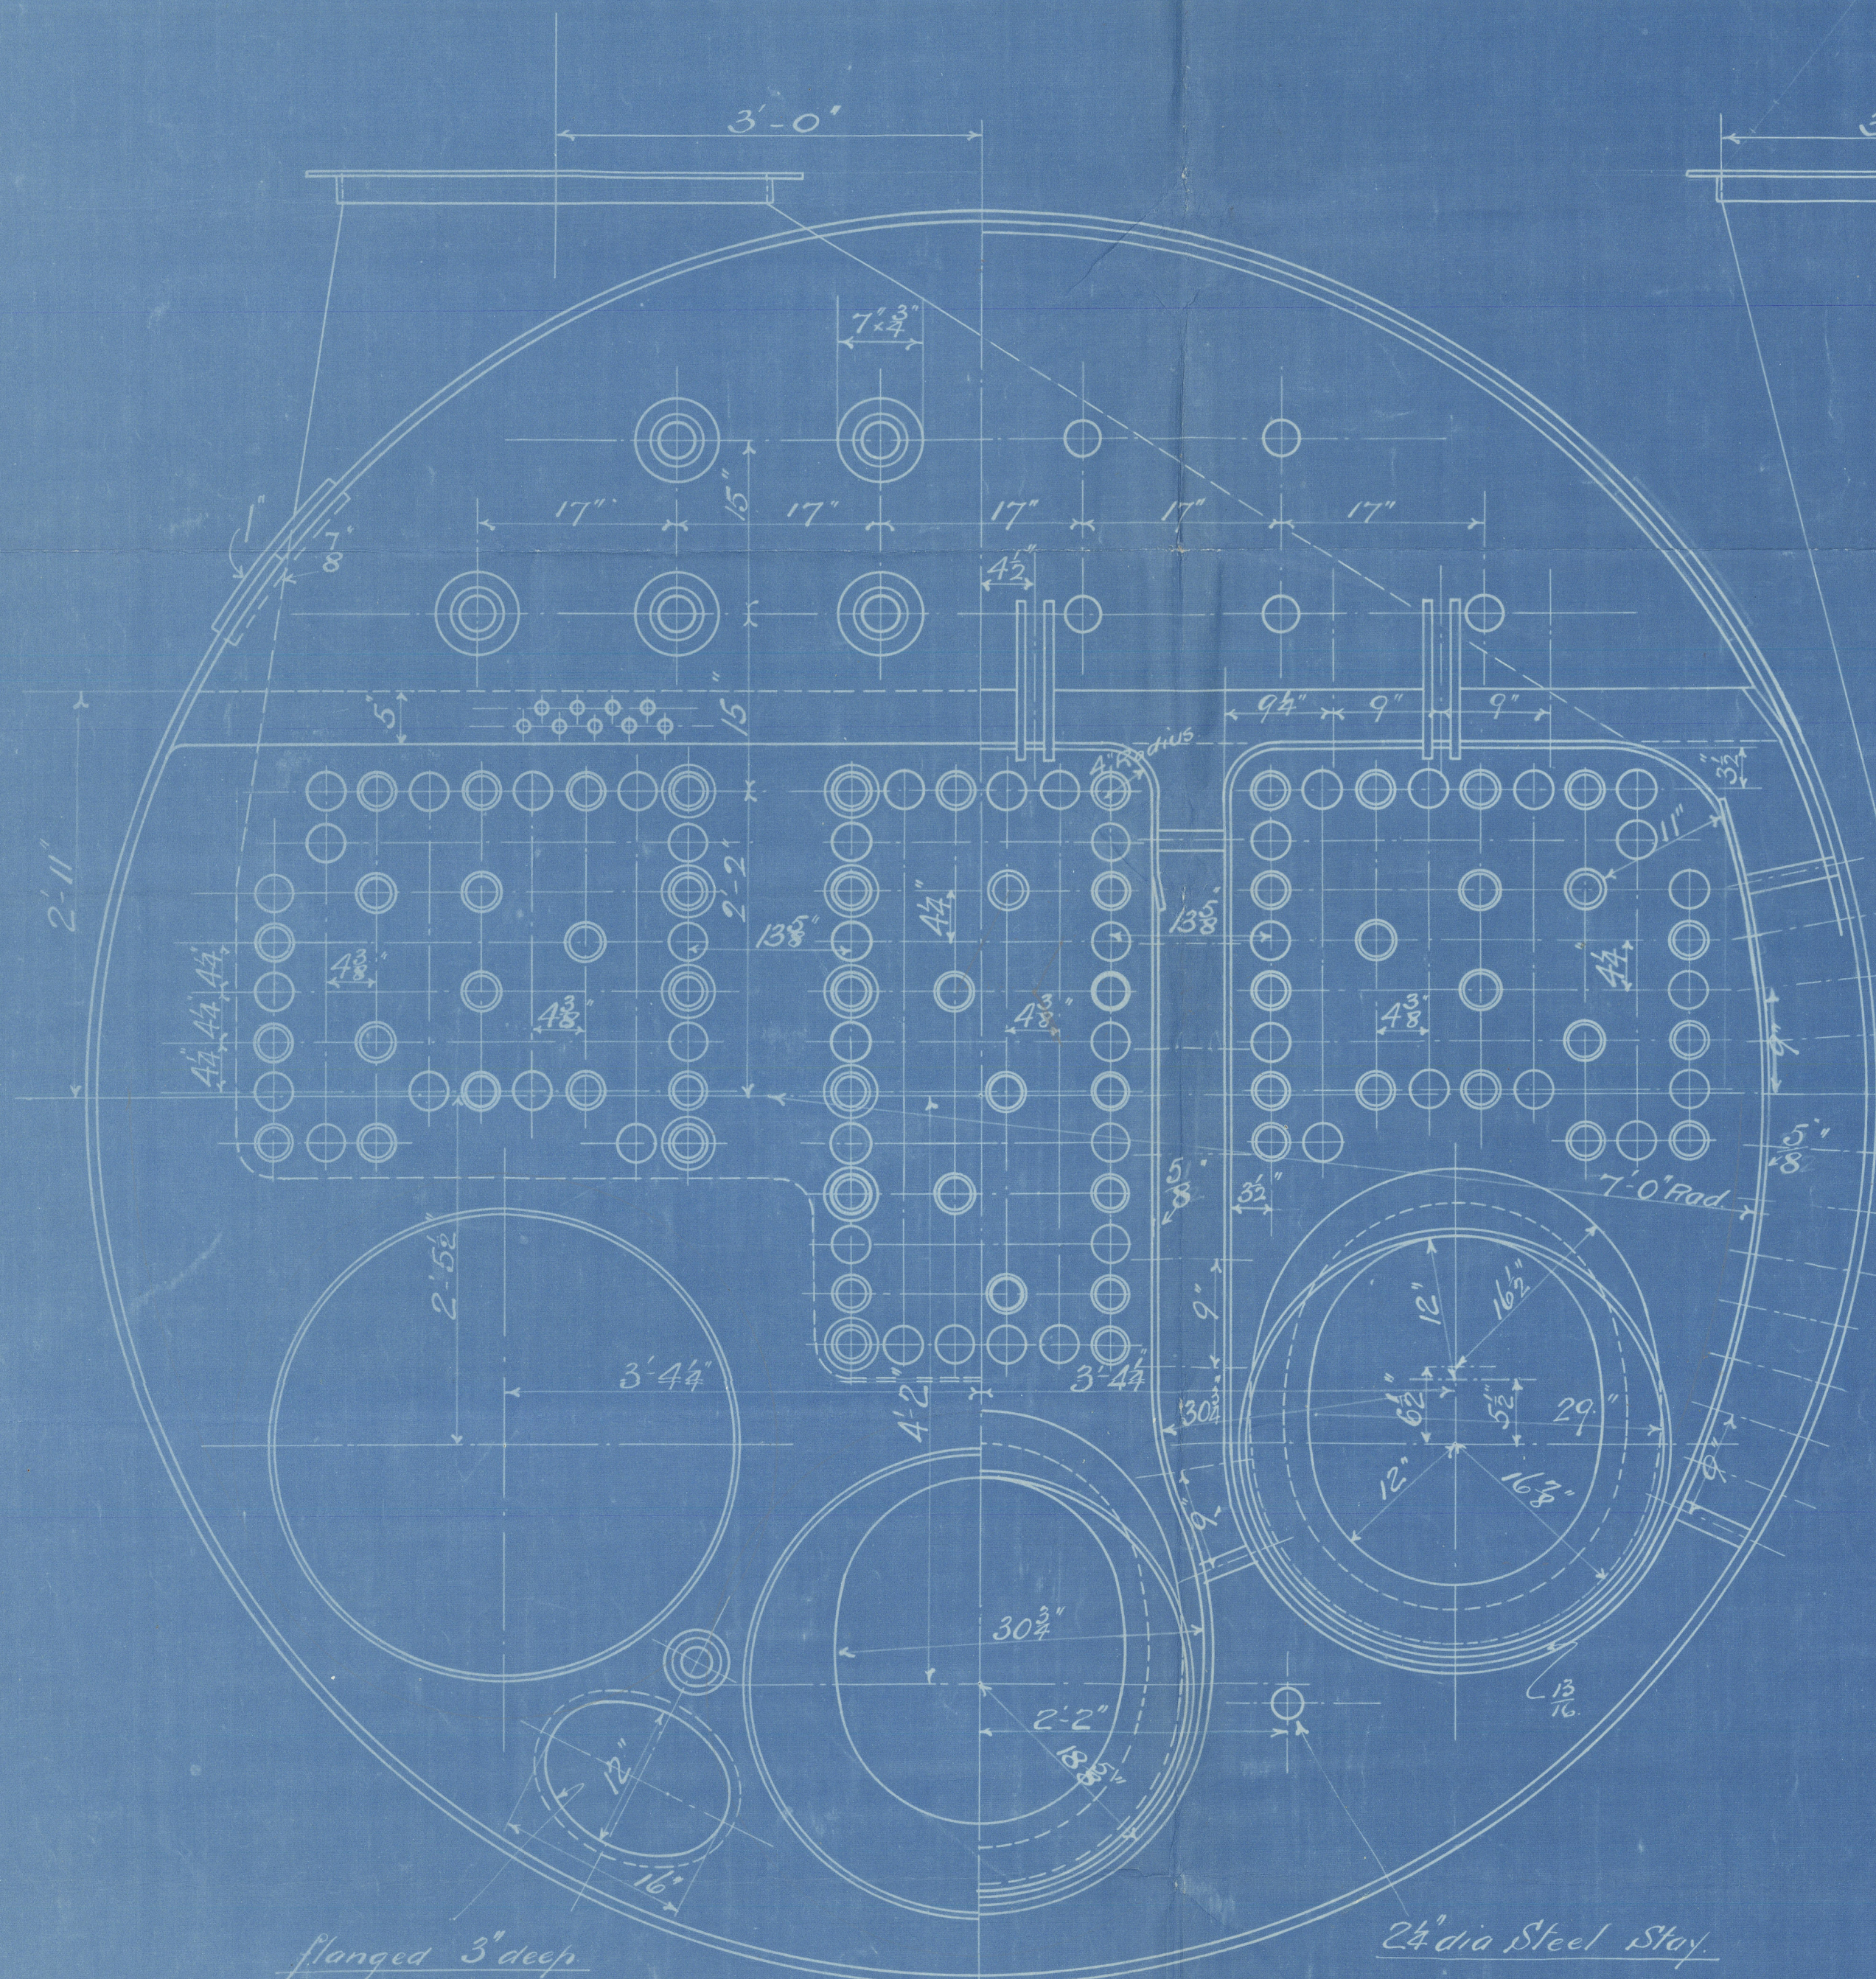

Steel Stays 1 1/2" dia. 9 threads. 2.03 Area Nutted.
All square from C.C. plates

Heating Surface 1530 sq ft.
Grate Area = 5' 6" bars = 50 sq ft.

44 APR
10/11/19

Miss Riley Bros Lim¹
Boiler No 5255
for
Thomson & Taylor & Co.
S.S. No 196
Working Press 180 lbs
"Ethel Radcliffe"

No.	6143
LLOYD'S TEST	
360	Prob
WP 180	Report.
22.7.20 - W.M	No 10757

Boiler No 4806 fitted in
SS. Filimston
Prob Report No 9282

W35-0036



© 2020

Lloyd's Register
Foundation