

PROFILE

A circular purple ink stamp. The outer ring contains the text "H. B. CRAIG, TAYLOR & CO. LIMITED" at the top and "STOCKTON-ON-TEES" at the bottom. In the center, the date "28 JUL 1910" is stamped. There are decorative horizontal lines above and below the date.

* DENOTES 12° BULB ANGLE FRAMES
CARRIED TO BRIDGE & FORECASTLE DECK

ALL PERK P.A. FRAMES
TO FILE DECK

Strengthening of bottom forward to be submitted.

S. M. M.
13.8.19

29.7.19 2020
Lloyd's Register Foundation

W35-0068

Miss Craig Taylor & Co. Ld.


no 196

Profile & Deck Plan

"Ethel Radcliff"

Wab Idt Lpt 10858

Wab report no. 10844

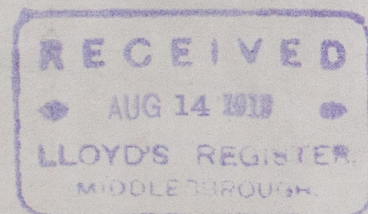

W35-0068



© 2020

Lloyd's Register
Foundation

RECEIVED
SEP 26 1919
LLOYD'S REGISTER,
MIDDLESBROUGH.



© 2020

Lloyd's Register
Foundation



305
© 2020
Lloyd's Register
Foundation