


13.11.25

CONNECTION OF HATCH END BEAMS

SCALE 3/4" = 1' 0"

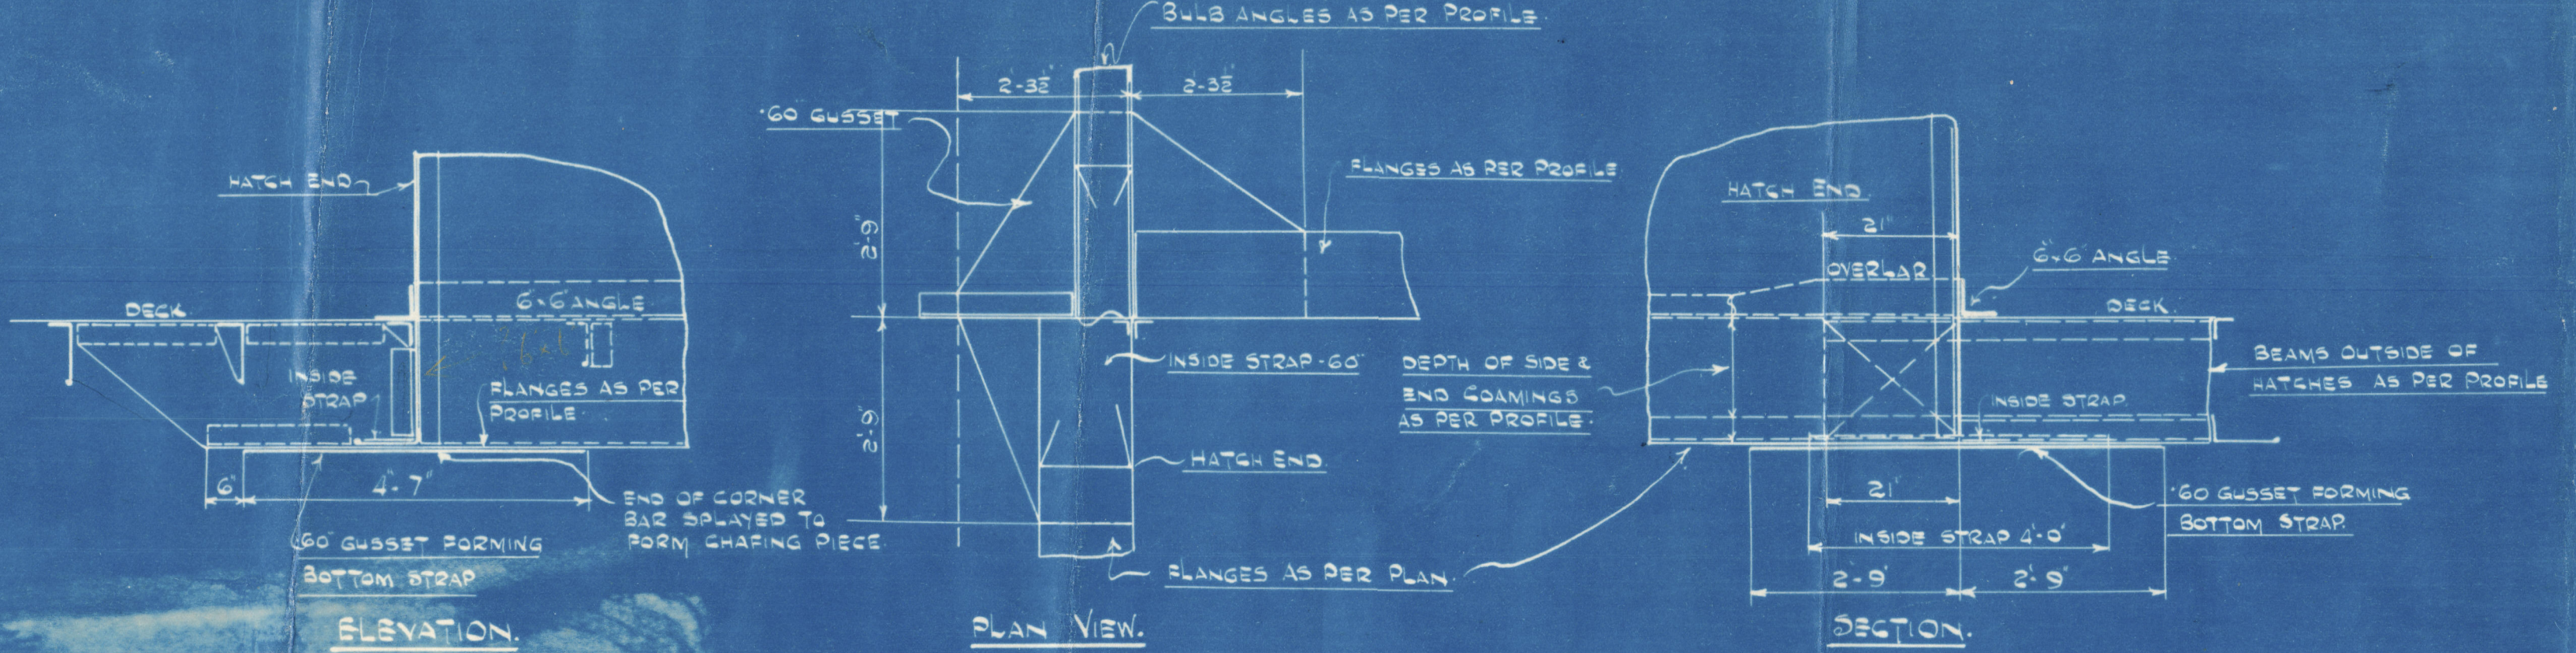


PROFILE.

SCALE 3/4" = 1' 0"

2.5 390'-0" - 54'-0" - 28'-9" M.T.

NOTE: NO PILLARS FITTED AT SIDES OR CORNERS OF HATCHES.

NOTE: N.B.S. DENOTES NEW BRITISH STANDARD SECTION.

 


979-80.

PLAN NO 2

DRAWN BY SE

CHECKED BY J.H.B.

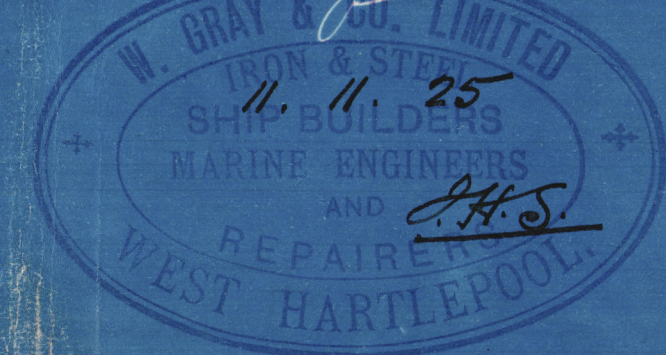

979-80. & 81



Radn Letter
19.11.25
Hoyt & Co.
Foundry
W350-0071

Grays 979 980 & 981

O.W

PROFILE



979 "FIRBY"

HPL. RPT. 16414.

980 "OTTERPOOL" *

Hpl Rpt 16423

981 Warlaby.

W. Hpl Rpt. 16465

SV Romanby




© 2020

Lloyd's Register
Foundation

W350-1000

W350-0071

97 9/80/81

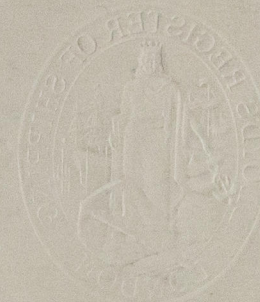

© 2020

Lloyd's Register

Foundation