
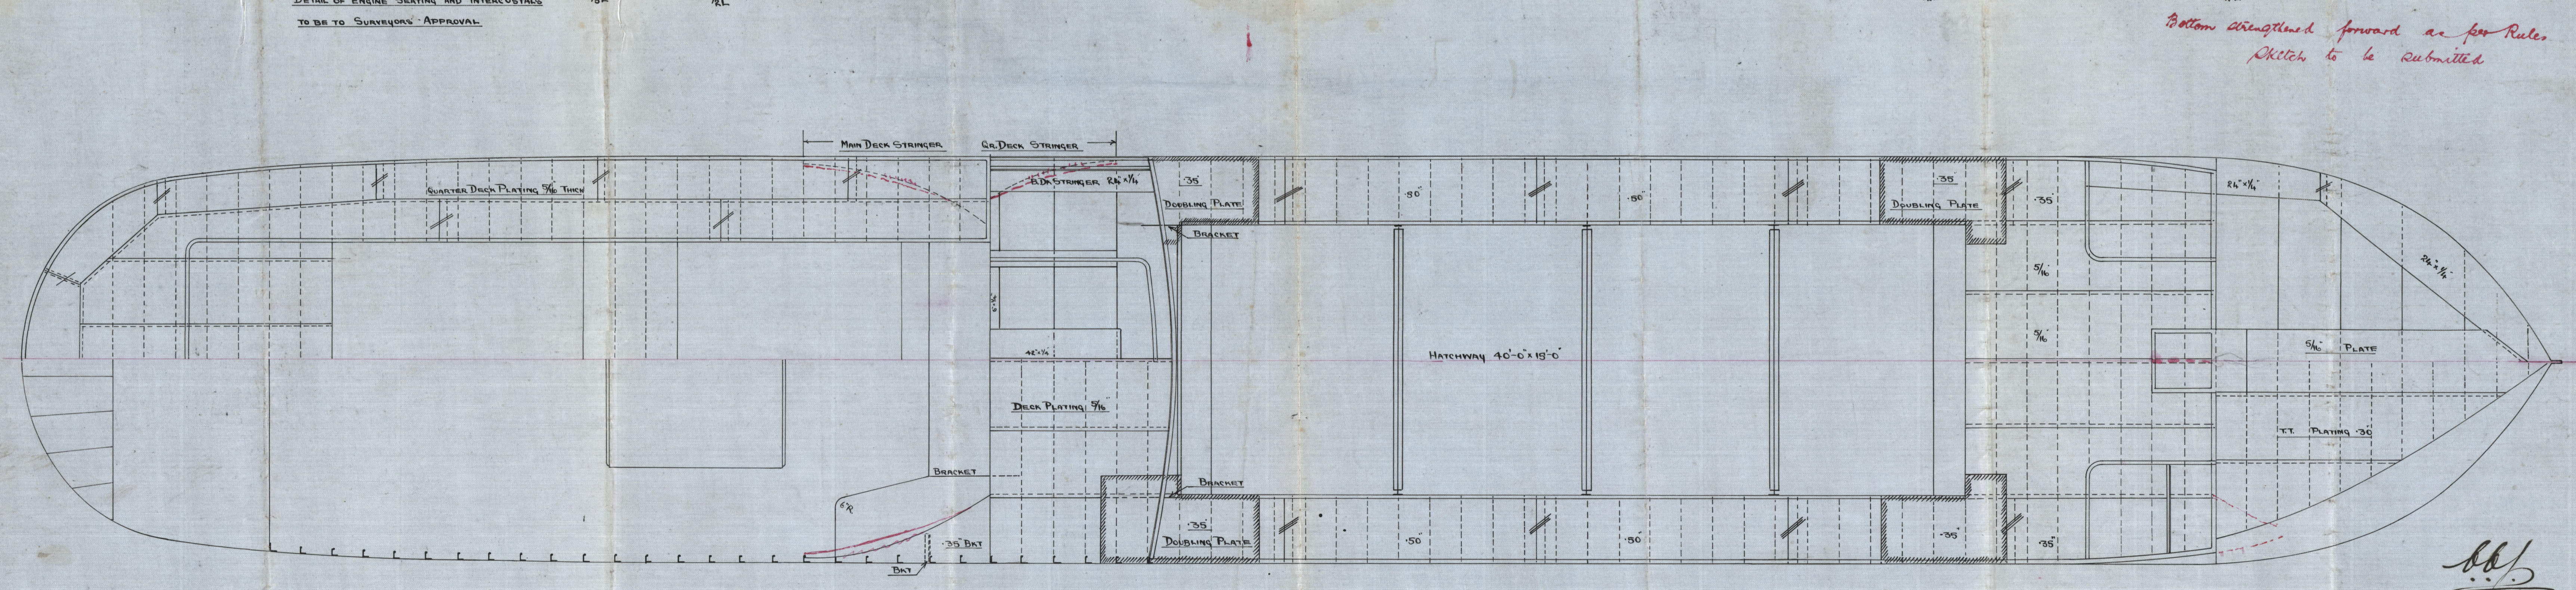


15.5.17  
 22/5/17  
 "FAVORABLE"  
 07821 HTJ

SS N° 23  
 DIMENSIONS 135 Ft x 23 Ft x 10'-9" MLD to M.D.  
 SCALE 1/4" = 1 FOOT

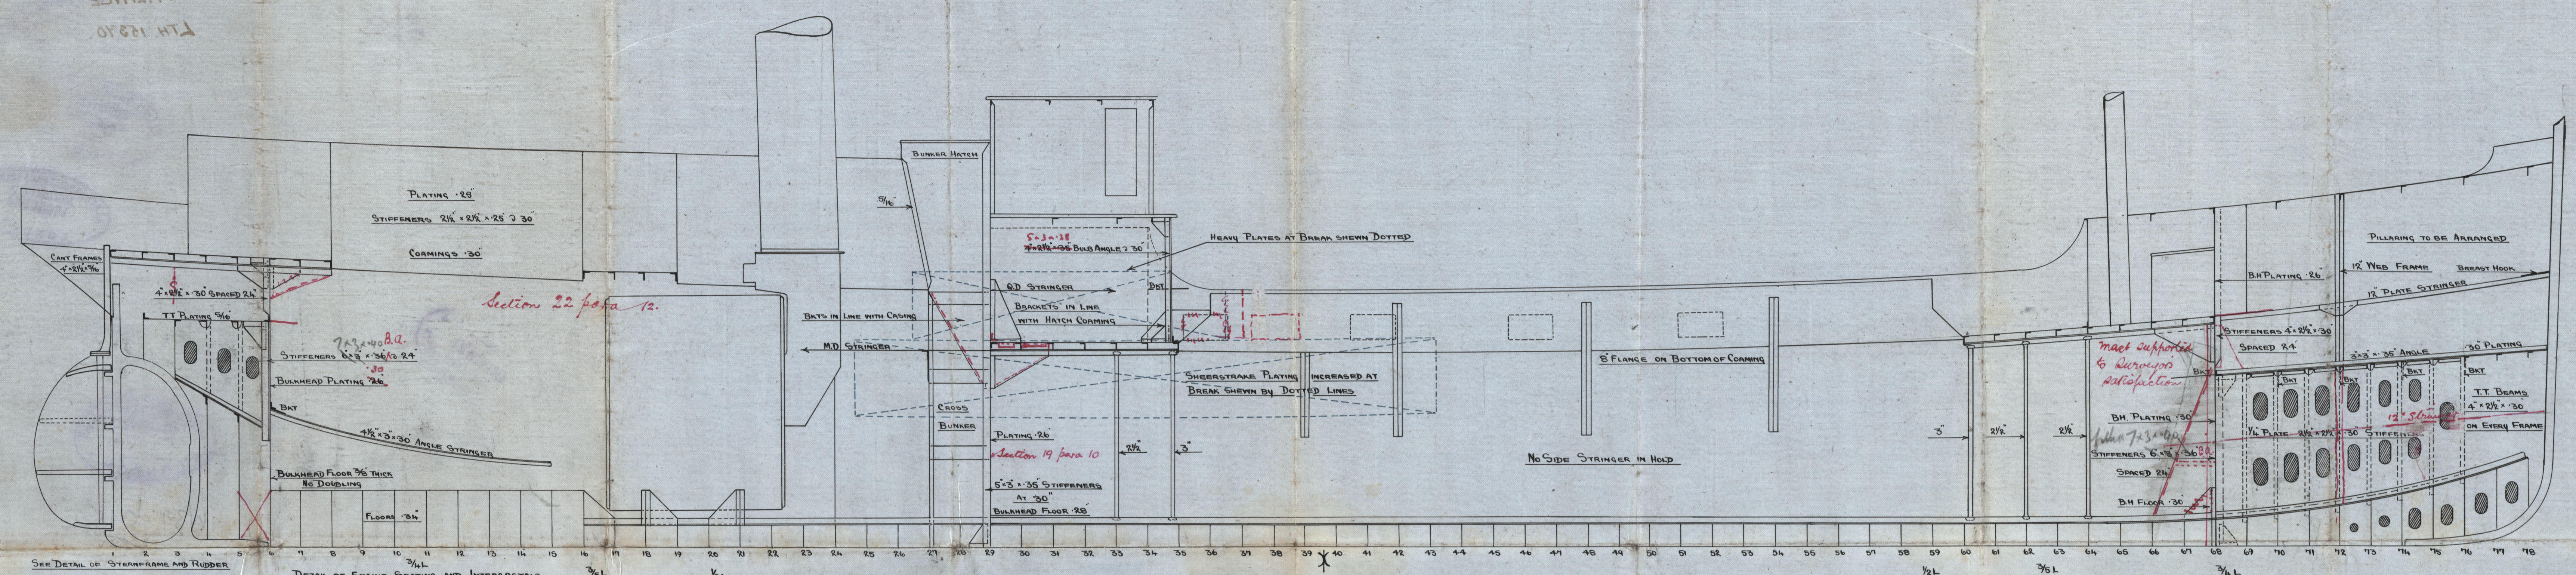

LONGITUDINAL SECTION AND DECK PLAN

Bottom strengthened forward as per Rules.  
 Sketch to be submitted.

J.B.  
 14.2.17.


S.S. No 23

Profile Plan

Mons A. Jeffrey & Co  
Altra

"FALAYEE"

LTH. 15340.

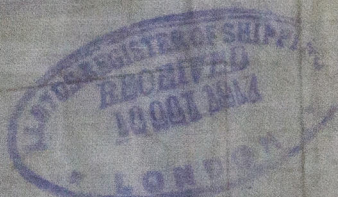

© 2021

Lloyd's Register  
Foundation

W37-0152