

Do all the Frames extend to the top height in the Poop? *Yes* Raised Quarter Deck? *Yes* Bridge House? *Yes* Forecastle? *Yes*
 To what height do the Reverse Frames extend? *Longitudinal Framing*
 Has the Poop or Raised Quarter Deck an efficient Iron Bulkhead at the fore end? *Yes*
 Is the Forecastle at least as high as the main or top-gallant rail? *Yes* Has the Forecastle an efficient Iron or Wood Bulk'd. at after end? *Yes*
 Are the Engine and Boiler openings covered by a Bridge, Poop, Raised Quarter Deck, or enclosed by a Strong Iron or Steel Deckhouse? *By Shelter Deck with Deck house on shelter deck.*
 If the openings are not so protected are the exposed parts of the Casings efficiently constructed? *Yes*
 Give thickness of plating; scantlings and spacing of Stiffeners *Coaming 4-6, Plating 30, Stiffeners 3 1/2 flanges 2-6 apart.*
 What is the height of the exposed Casings? *7-6* Are suitable means provided for closing all openings in them in bad weather? *Yes*
 Are the Weather Deck Hatchways efficiently constructed and at least equal to the requirements of Section 28 of the Rules for 1904-5? Give particulars below: *Yes*

| Position and Size. | Cargo Hatch to Main Deck | | Summer Deck | | Hatch to Main Deck | | Hatch to Side Bulkhead | | Hatch to Fore and Afters | |
|-----------------------------------|--------------------------------------|-------|--------------------------------------|-------|--------------------------------------|-------|------------------------|-------|---------------------------------------|-------|
| Item. | Ship. | Rule. | Ship. | Rule. | Ship. | Rule. | Ship. | Rule. | Ship. | Rule. |
| COAMING. Height above top of DECK | 2-6 | 2-6 | 2-6 | 2-6 | 2-6 | 2-6 | 2-6 | 2-6 | 2-6 | 2-6 |
| Thickness | Sides | 44 | 44 | 44 | 44 | 44 | 44 | 44 | 36 | 36 |
| | Ends | 44 | 44 | 44 | 44 | 44 | 44 | 44 | 36 | 36 |
| SHIFTING BEAMS OR WEB PLATES. | Number | ✓ | ✓ | ✓ | ✓ | ✓ | ✓ | ✓ | ✓ | ✓ |
| | Section and Scantlings | ✓ | ✓ | ✓ | ✓ | ✓ | ✓ | ✓ | ✓ | ✓ |
| | Material | ✓ | ✓ | ✓ | ✓ | ✓ | ✓ | ✓ | ✓ | ✓ |
| * FORE AND AFTERS. | Number | ✓ | ✓ | ✓ | ✓ | ✓ | ✓ | ✓ | ✓ | ✓ |
| | Section and Scantlings | ✓ | ✓ | ✓ | ✓ | ✓ | ✓ | ✓ | ✓ | ✓ |
| | Material | ✓ | ✓ | ✓ | ✓ | ✓ | ✓ | ✓ | ✓ | ✓ |
| HATCHES Thickness | 36 W.S. Cover with 4x2x36 Stiffeners | | 34 W.S. Cover with 4x2x36 Stiffeners | | 34 W.S. Cover with 4x2x36 Stiffeners | | 34 W.S. Cover | | Wood Cover to be or Ninged W.S. Cover | |
| Remarks | Steel | | Steel | | Steel | | Steel | | | |

* The depth of Fore and Afters should be stated from the underside of the hatches in all cases.

(If the sill of the lowest side scuttle will be less than 6 inches above the Indian Summer Load Line if assigned under the tables, state vertical distance from top of deck at side amidships to lower edge of lowest side scuttle.)

The following information is to be given in all Cases of vessels dealt with under Paras. 11, 12 (under 15 feet Moulded depth) and under Shelter Deck Rules.

What is the thickness of the Bridge Sheerstrake? *Strake between Main and Bridge Sheerstrakes?*
 Delete the words { The Crew are, are not, berthed in the bridge house.
 that do not apply { The arrangements to enable them to get backwards and forwards from their quarters are, are not satisfactory.

Length of Bulwarks in well


Area of Freeing Ports required by Para. 11 (e) each side of vessel = Sq. ft.

$$\frac{47 \times 50 \times 2.5}{100} = 59$$

Ft. Tenths. Ft. Tenths. No. } Freeing Ports (each side of vessel) = Sq. ft.

$$\frac{52 \times 30 \times 4.5}{100} = 80$$

Total deficiency or excess = " Sq. ft.

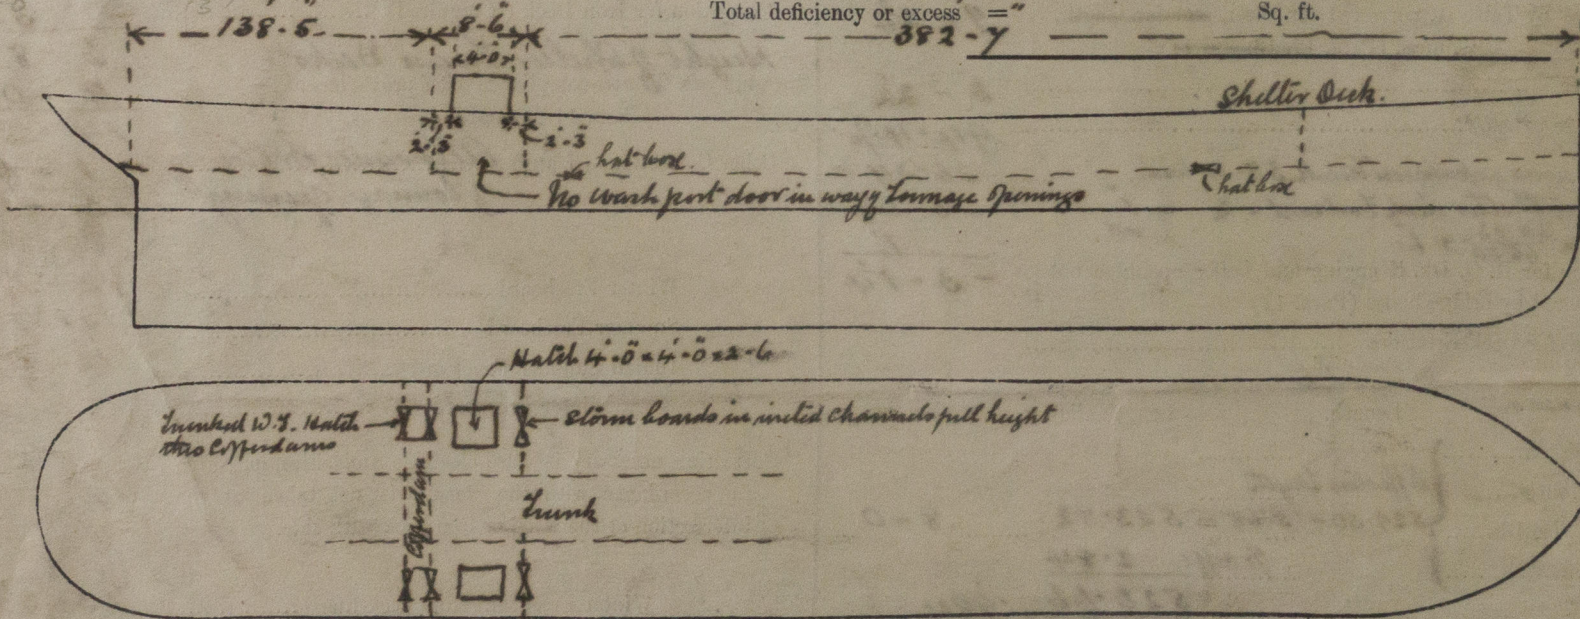

Show hereon line of Floors or Tank Top with position of any Breaks in same; also height of Peak Tank tops, &c., &c.


State any special features in the construction of the Vessel *Scupperns from upper deck thru ship's sides have been closed up with riveted plates. A steam pump has been fitted in the Pump room to pump from two hat boxes on each side of shelter deck (one forward & one aft.) The approved plans are also forwarded for reference.*

Owners

Address

Fee £ 18 : 8 : Received by me 1-1-18

2-1-18

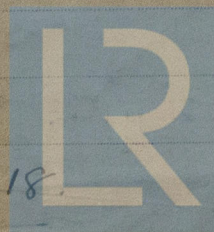

© 2021

Lloyd's Register Foundation