


8.8.14  
19.10.14  
7.10.14  
9.8.14

The lower flanges of transverse stiffeners to be plated excluding floor plate & C. Green to be increased in thickness where that of increased depth due to stress. Stiffeners to be increased in length 5ft. are required in view of increased depth. Also bottom stiffeners to be increased from top of floor. Be a additional stiffening to be increased above size of lower flanges shown on Machinery Section, 2 in depth or 2 1/2 in thickness for each additional one.  
The height to land deck to be measured at a point 5' 0" below upper deck.

No 848.  
Profile and Deck Plans  
Dimensions: Length 83' 0" Breadth 8' 66' 6" Depth 42' 0" to Shelter Deck.  
Ischerwood System (Patent)  
Scale 1/8" = 1 Foot

 

W870-0054



RETAIN

S S SARANAC

NEWCASTLE ON TYNE.




Report No. 70987

RETAIN


Galmers, J.B. & Co. Ltd.

No 848 + 863

Profile & Deck Plans

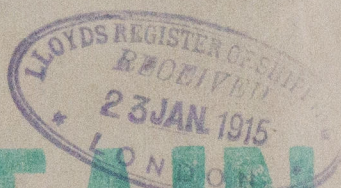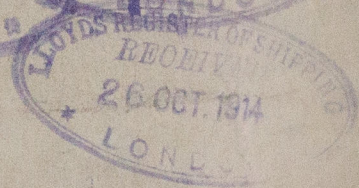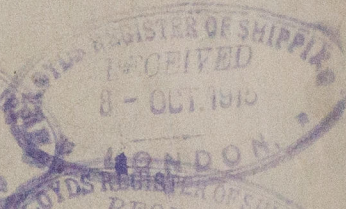


RETAIN

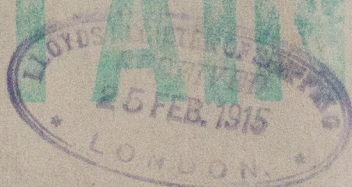

S. S. CADILLAC

NEWCASTLE ON TYNE.

Report No. 70543

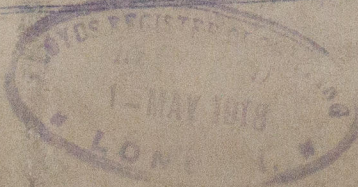


Profile

By Taffin

6-6-34

7500-013M

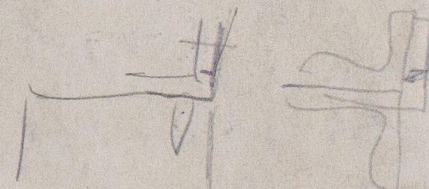

© 2021

Lloyd's Register  
Foundation