


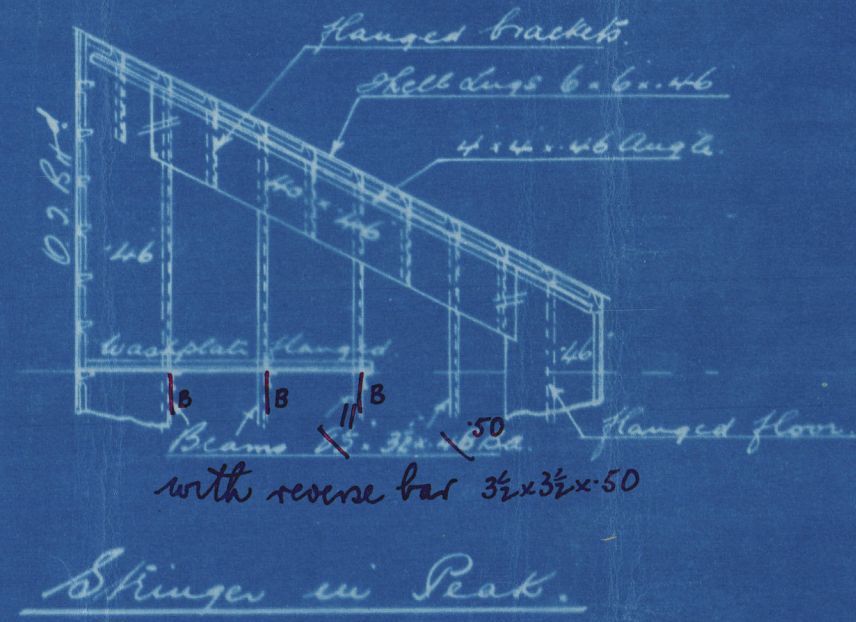


Position of Longitudinals as in Oil Tanks.

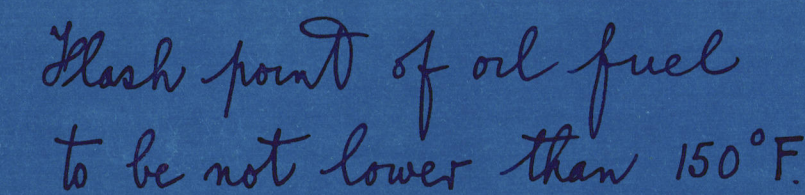

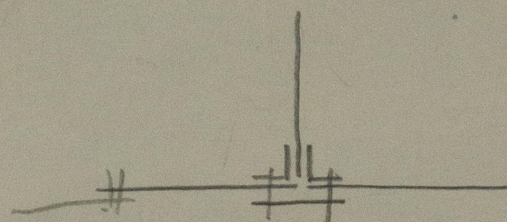

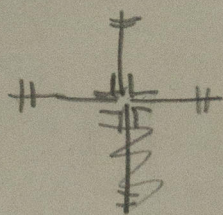

© 2021


Lloyd's Register  
Foundation



RETAIN




848

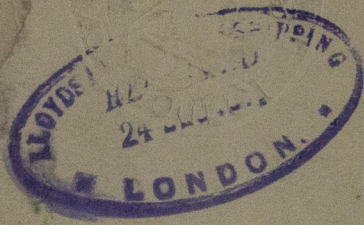

Palmer, S. B. & Iron Co. Ltd.  
N<sup>o</sup> 848 ✓

Approved plan of Iron end

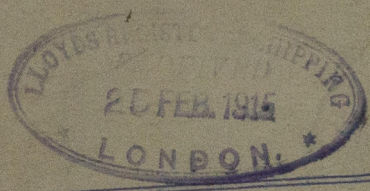


S. S. CADILLAC  
NEWCASTLE ON TYNE.

Report No. 70543

RETAIN

1900-17-3  
15597-11-8  
12-12-10 1640  
22-10-0 7277  
2930-0 6  
7277-11-8  
4930-0-6  
12207-12-12

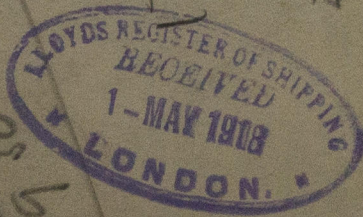

W370-005b

S. S. SARANAC  
NEWCASTLE ON TYNE.

Report No. 70984