


12/1/15

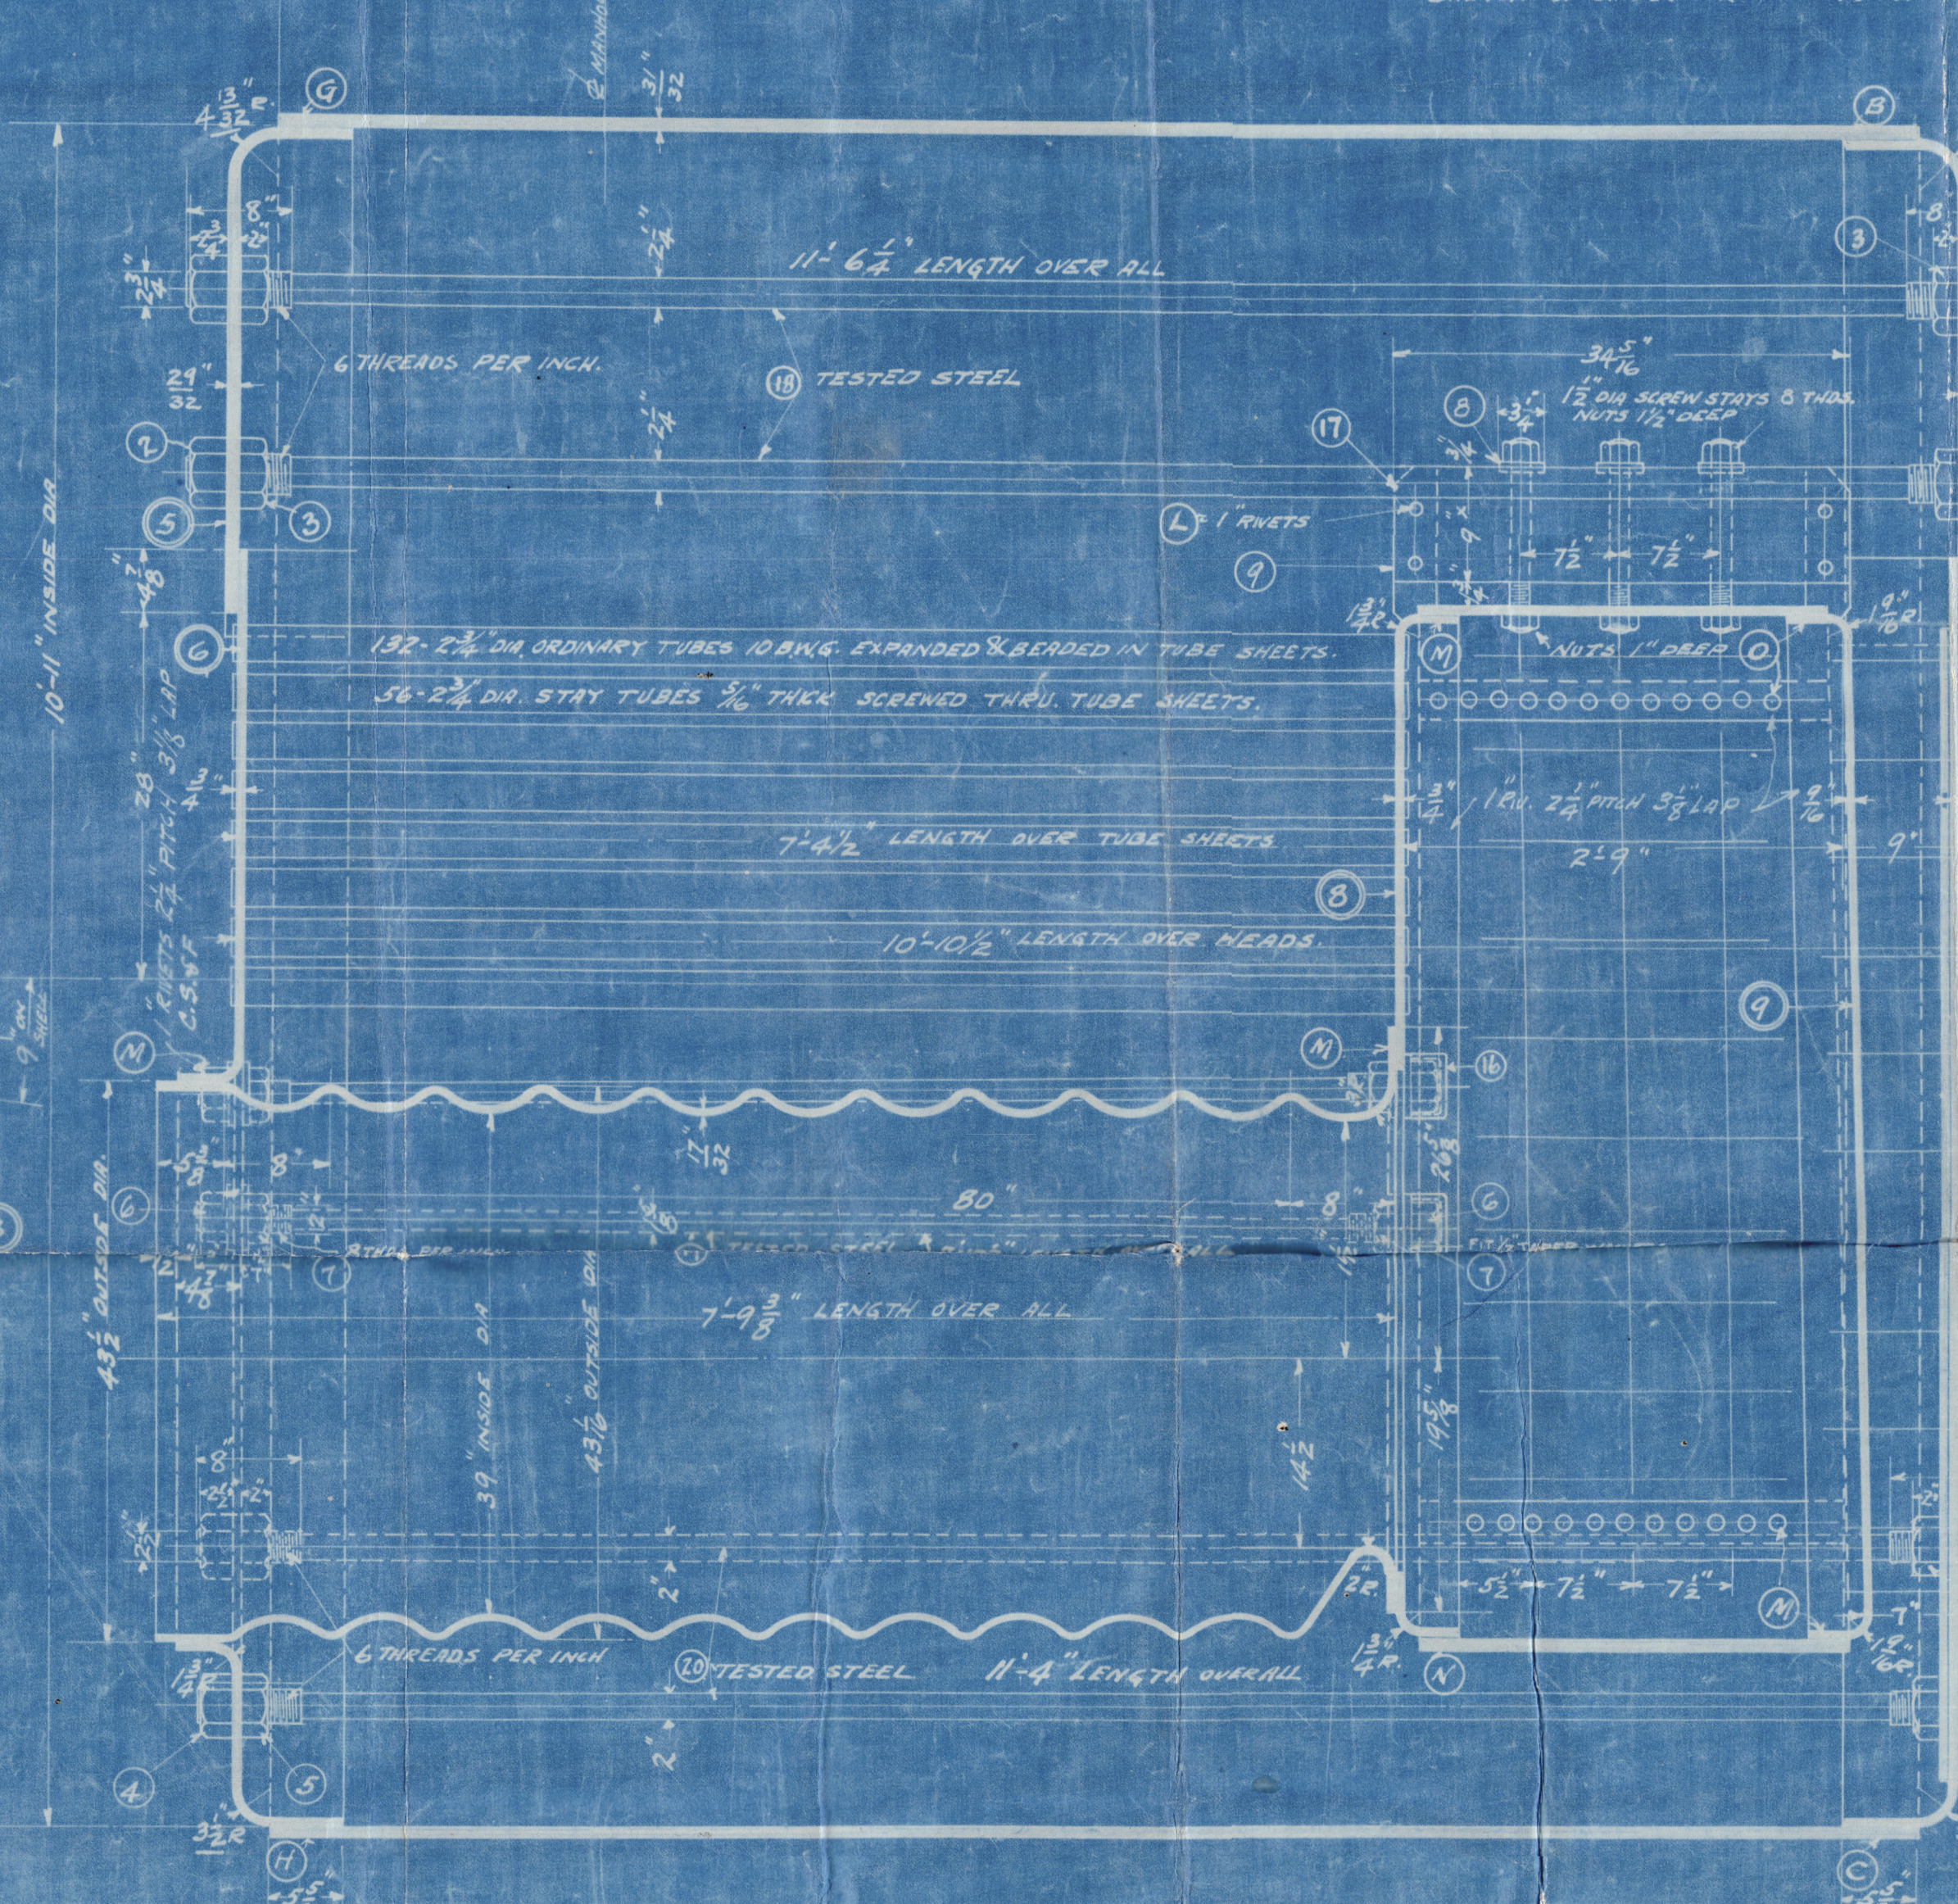

P. R. "CHARLES TRATT"		MACHINERY DIVISION	
1775 RT 884		DONKEY BOILER	
10" 11" INSIDE DIA 10" 10 1/2" LONG		150 LBS WORKING STEAM PRESSURE	
66	187	✓	APR 15, 1918
66	186	checked	Good 4-1-18
66	177	OK	
66	170		
60195		7/11/18	
PAID	ALTERATIONS	ALTERATIONS	DATE CHECKED

[illegible]

12. 1. 15
JLM

17 BATTERY PLACE
NEW YORK

mm
29-12-11

Newport News District

Donkey Boiler

Vessels Nos 186 and 187.
for Standard Oil Company
of New Jersey.


29th Dec. 1914

"Charles Pratt." NNS. 884.



RETAIN

W373 - C196

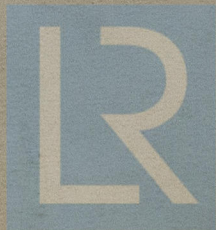

© 2020

Lloyd's Register
Foundation

RETAIN



© 2020

Lloyd's Register
Foundation