

Nos 490-1-2 & 3. PROFILE & DECK PLANS

Scale 8" = 1 Foot

DIMENSIONS:- 415'0" P x 53'3" B.M x 28'0" D.M. TO UPPER DECK
 TO CLASS 100A1. SHUTTER DECK AT LLOYD'S SPECIAL SURVEY.
 ANNEXE.

APPROVED
 LLOYD'S REGISTER OF SHIPPING
 H. J. G. J. G.
 DATE 1/4/20

RETAIN

Ayrshire Dockyard Yard No. 490.

GLASGOW REPORT No. 42308

"Clan Macfarlane"



Profile & Deck Plans ✓

RETAIN

Yard No 491

"Clan Macfadyen"

GLASGOW REPORT No. 42743.

RETAIN


RETAIN

W374-0080



© 2020

Lloyd's Register
Foundation

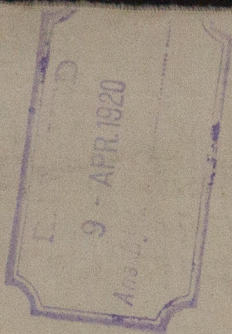

W374-0080



© 2020

Lloyd's Register
Foundation