
 


"CYMBELINE".
S.S. No 399.
PROFILE and DECKS.
 Scale $\frac{1}{8}" = 1 \text{ Foot.}$

DIMENSIONS: Length 420' 0" B.P., x 54' 3" Mld x 32' 8 1/2" Mld to Upper Dk.
 419' 0" on L.W.L.

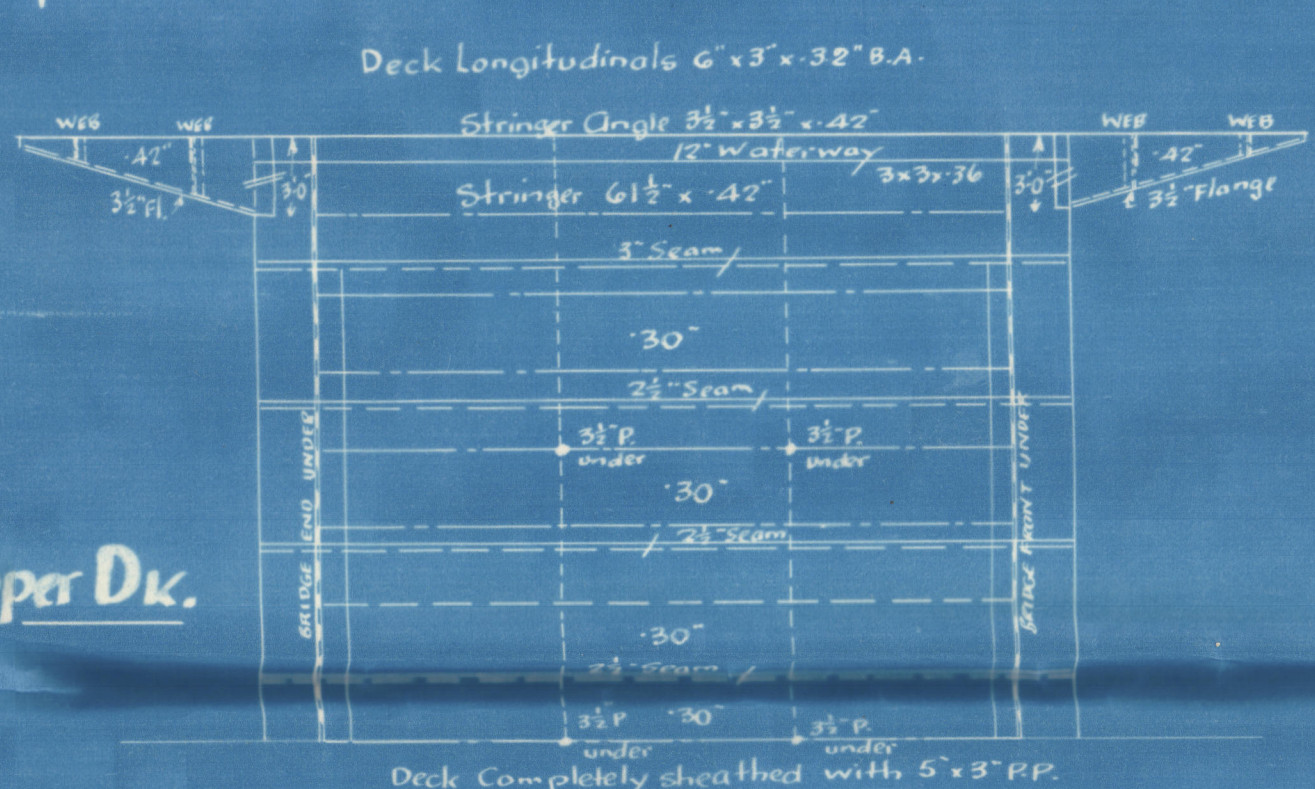

Wm. Hamilton's N^o. 399.

Profile & Decks
(as Built) ✓

S. S. "Gymbeline"

Greenock First Entry Report N^o. 18800

RETAIN

RETAIN

W381-0119



© 2020

Lloyd's Register
Foundation