

Nº 1.227



PLAN SHOWING POSITION OF BUTT STRAPS & MANHOLE DOORS.

DETAIL OF SHELL RIVETTING.
SCALE:- $1\frac{1}{2}" = 1\text{ FT}$

2.S.E. BOILERS FOR №4S2.

SCALE :- 1" = 1, FOOT.

4\$2 ~~490~~

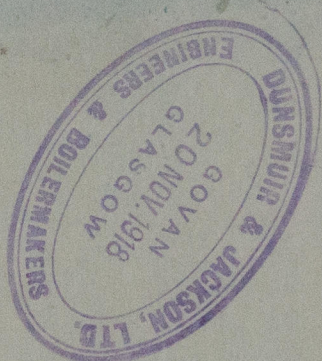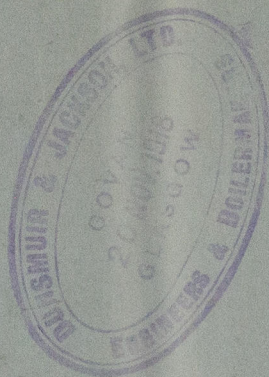

W382-0058



© 2021

Lloyd's Register
Foundation

482

Single ended

200 lbs


Single ended boilers

No 482.

No 15525.

LLOYD'S TEST

350 LBS

W.P. 200 LBS.

6 — 10 — 20

J. E. S.

S-S. "Diplomat"

GLASGOW REPORT No.

H1392.

Lloyd's Register
Foundation
W382-0058