
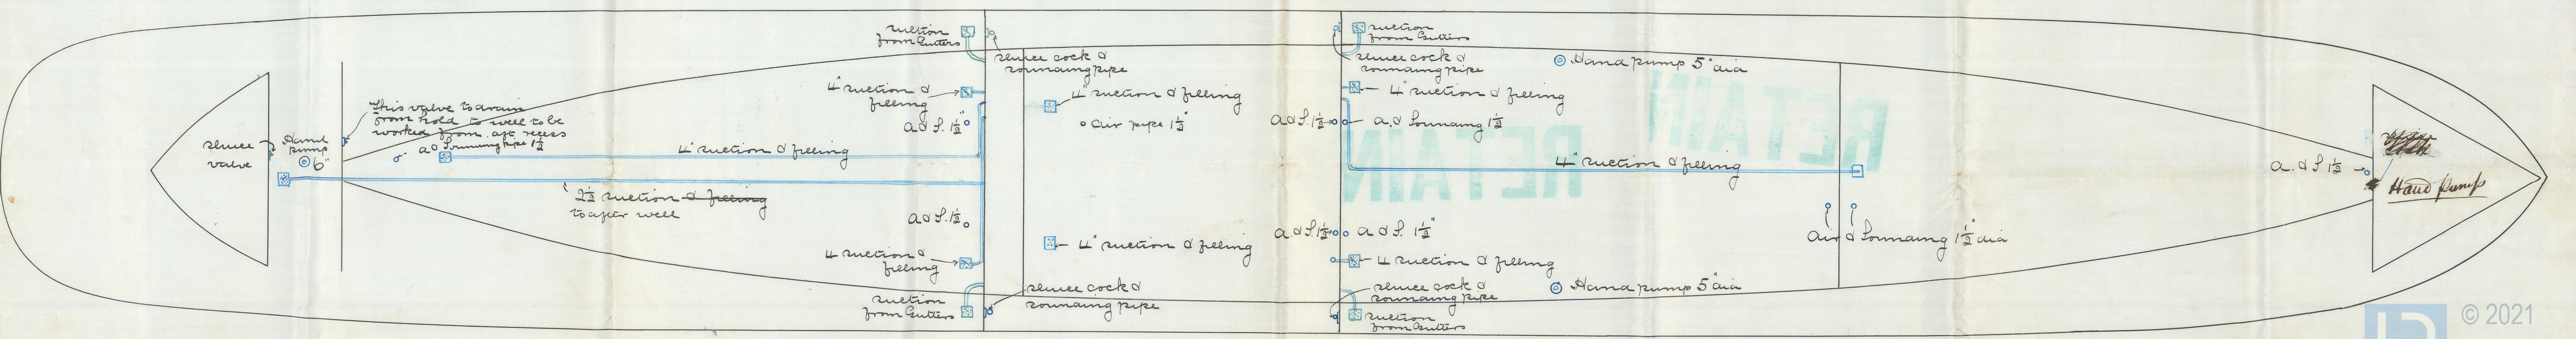


Lk. 23.1.90

S.S. Kaparima Inc. Safety Report No 23875  
PIPE PLAN N° 90

SHIP  
SCALE 1/8" = 1'-0"

No. 20.1.90  
M.N. 20.1.90

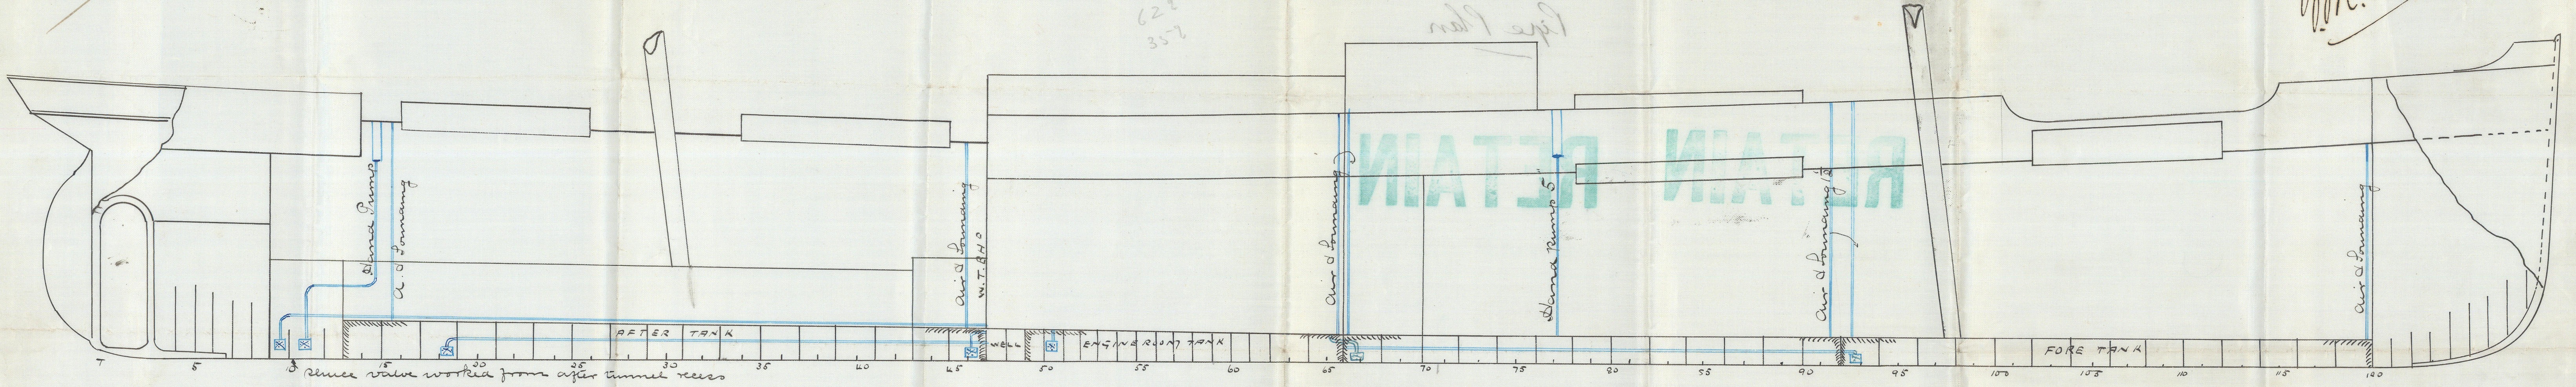

W.A.  
22.1.90

W382-0187



n/n "Daphne"

"<sup>ex</sup> 600" Wwc. 23845.

Pipe Plan

RETAIN

RETAIN

RETAIN

RETAIN



© 2021

Lloyd's Register  
Foundation

W382-0187