

Ct

Lloyd's Register
Foundation

Bottom strengthened for to as per rule. and
to Surveyors satisfaction

C. J. QUADRA
27. 10. 14

Irvine S.B. & D.D. Co. L^d

T.S.S. N^o 555.


MIDSHIP SECTION. ✓

DIMENSIONS, 430' x 61' x 38'-3 $\frac{1}{2}$ " SHLT^r DK.
30' UP^r DK.

NOV^R 1914.

T.S.S. "DUQUESA"


Report- No 15499.

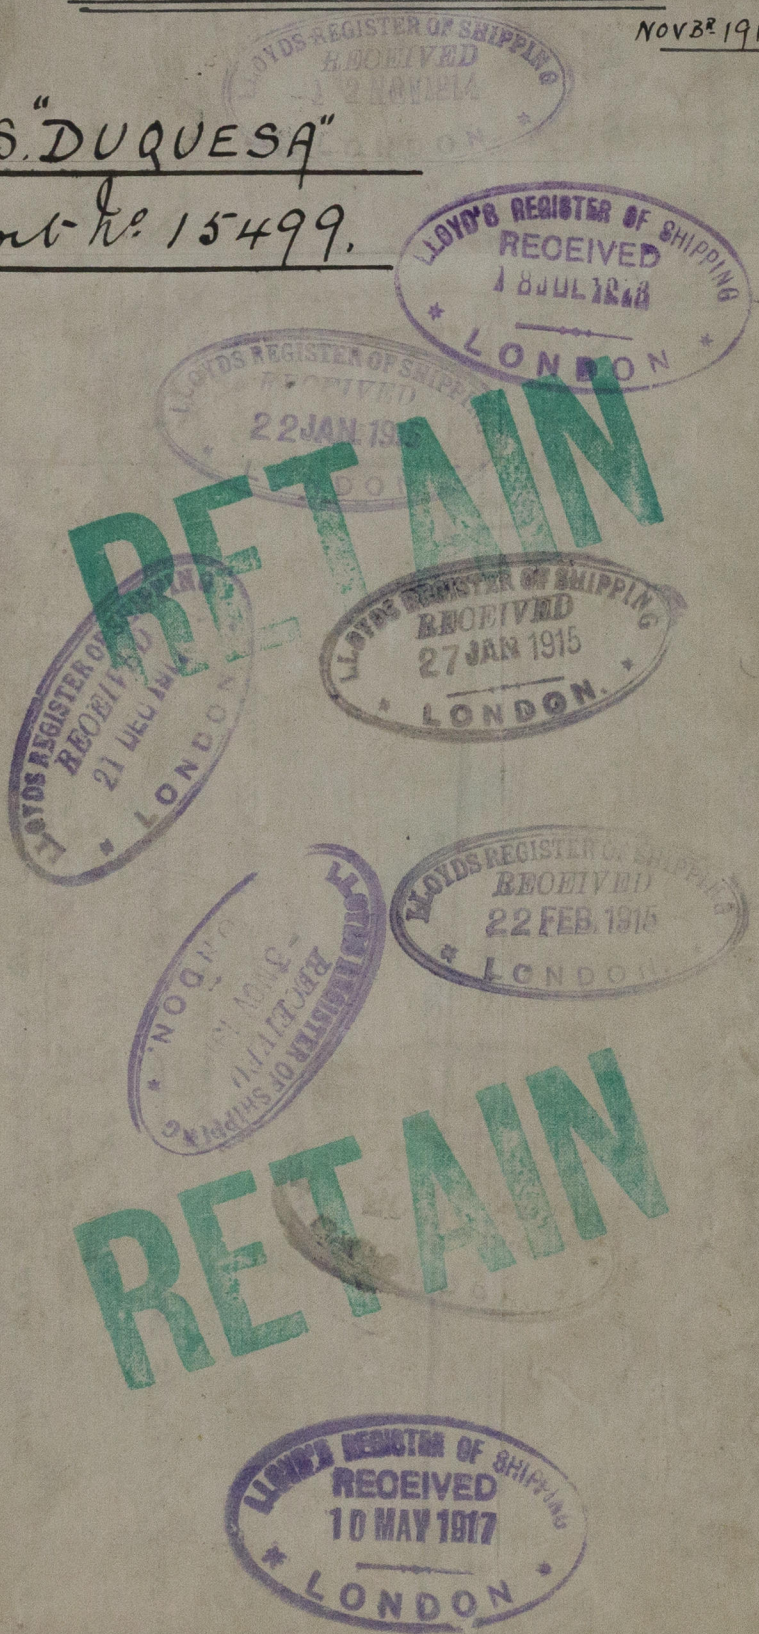

© 2020

Lloyd's Register
Foundation

RETAIN

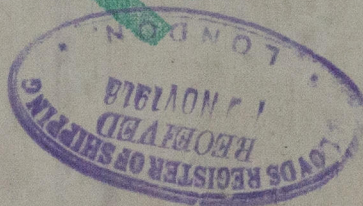

W383 - 0131



© 2020

Lloyd's Register
Foundation