
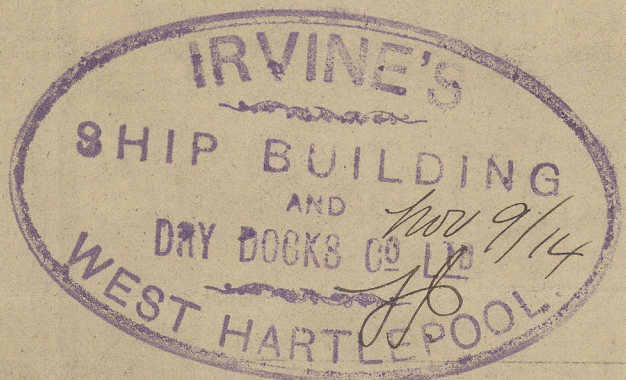


# MIDSHIP SECTION


Scale  $\frac{1}{2}$ " = 1 FOOT.

13.11.14

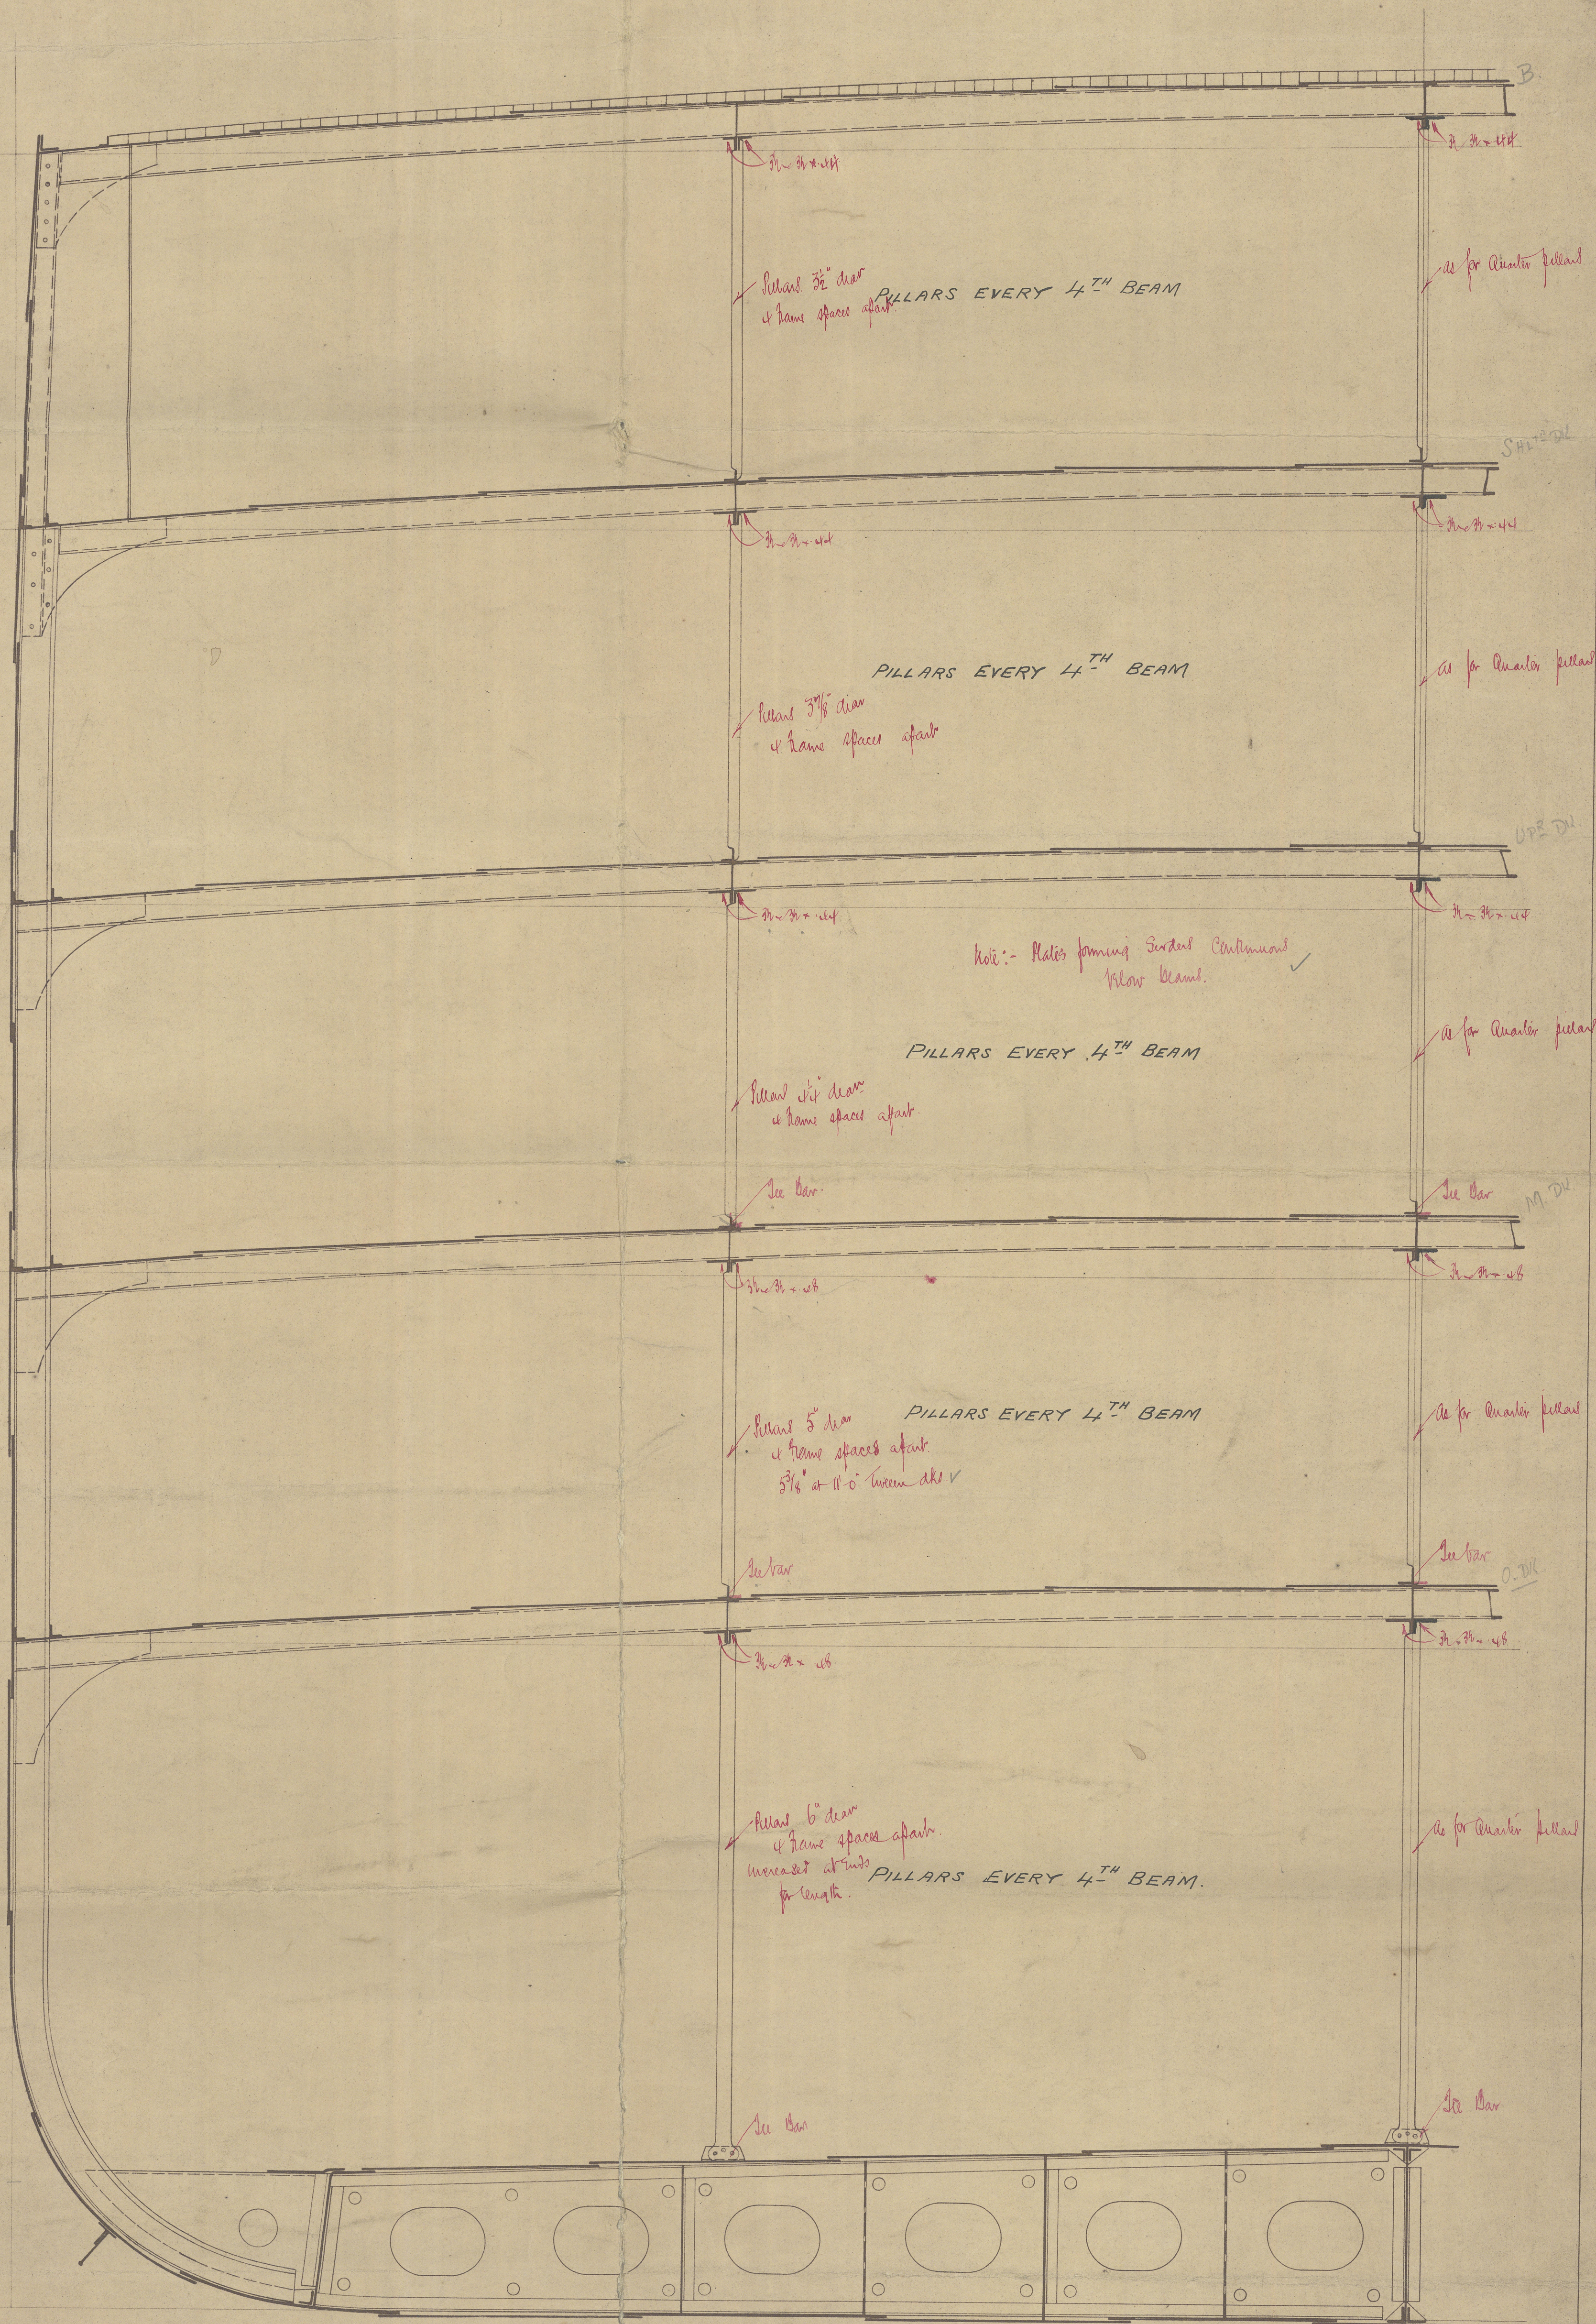

N<sup>o</sup> 555.

Cf.  
13.11.14

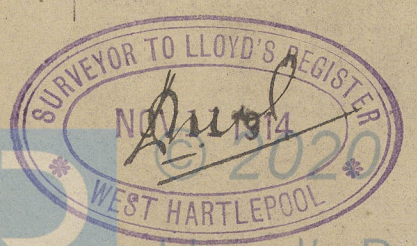

W383-0133



Innes S.B. & D.D. Co

T.S.S. N° 555.

Midship Section

showing Pillars ✓

T.S.S. DUQUESA.



REMAIN

REMAIN

W383



© 2020

Lloyd's Register  
Foundation