

VERIFICATION REPORT

Index No. 13 JAN 1926
(For London Office only.)

Lloyd's Register of Shipping.
SURVEYS FOR FREEBOARD.—STEAM SHIPS.

31929
No. 29210

PARTICULARS RELATING TO ALL STEAM SHIPS EITHER FLUSH DECKED, OR WITH GALLANT FORECASTLE, SHORT POOP AND BRIDGE HOUSE DISCONNECTED, OR WITH GALLANT FORECASTLES HAVING LONG POOPS, OR RAISED QUARTER DECKS CONNECTED WITH BRIDGE HOUSES, OR OTHERWISE.

Port of Survey Sunderland
Date of Survey 11-26 while building
Name of Surveyor T Shaw

COPY

Ship's Name. "DEMETERTON"	Port of Registry and Nationality. <u>Newcastle British</u>	Official Number. <u>149406</u>	Gross Tonnage. <u>44700</u> <u>5251.23</u>	Date of Build. <u>1926</u>	Particulars of Classification. <u>*100A1 Contemplated</u>
Number in Register Book					

Registered dimensions from Ship's Register.	LENGTH. <u>397.25</u>	BREADTH. <u>54.0</u>	DEPTH. <u>28.6</u>	UNDER DECK TONNAGE. <u>4791.55</u>
Length on LOADLINE.	<u>397.25</u>	Frame Depth <u>14.5</u> Rule " <u>7</u> <u>7.5 x 2 = 1.25</u> Span ceiling fitted	Ceiling fitted Sheer <u>+1.16</u>	Peak Tanks <u>included</u> <u>2.0 rise in after tank</u> <u>32.50</u>
CORRECTED DIMENSIONS.	<u>397.25</u>	<u>52.75</u>	<u>29.76</u>	<u>4824.05</u>

Moulded Depth as measured..... 31'-6"
Addition for Keel below base line for draught record..... 2 inches.

NOTE.— If the depth is measured when vessel is afloat, the details of measurement should be reported.

Co-efficient of fineness..... .7734
Any modification necessary [Para. 4 (a) to (e)]* .02 C.D.B.
Co-efficient as corrected..... .75

CORRECTION FOR LENGTH.

Length of Ship on Loadline.....	<u>397.25</u>
Length in Table	<u>378.00</u>
Difference	<u>19.25</u>
Correction for 10ft., Table A.	<u>1.6</u>
× Difference divided by 10	<u>3.08</u>
If $\frac{1}{10}$ ths length covered divide by 2	<u>+3"</u>

Sheer { Stem..... 120"
at { Sternpost... 66" } $186 \div 2 = 93$...Mean 36/42.08
1.16

Sheer at $\frac{1}{2}$ of the length from { Stem 67.5"
Sternpost 33.5" } $101 \div 2 = 55.5$...Mean 91.81
91.81

Gradual mean Sheer

Standard mean Sheer [Table, Para. 18]

Difference..... 42.08 $\div 4 = 10.52$

§ If limited as Para. 18 (f)

CORRECTION FOR IRON DECK.

Proportion covered, if less than $\frac{1}{10}$ ths length covered	<u>.4789</u>
Thickness of usual wood deck, less stringer	<u>3.2"</u>

Rise in Sheer { At front of bridge house.....
from amidships { At after end of forecastle

¶ Fall in Sheer {
Para. 18 (d) } $\div 2 =$

Length uncovered

CORRECTION FOR ROUND OF BEAM.

Breadth at Gunwale amidships.....	<u>53'-2"</u>
Round of Beam	<u>1-1/2</u>
Normal round.....	<u>1-1/4</u>
Difference	<u>1/4</u> $\div 2 = 1/8$
Proportion of Deck uncovered (Para. 19)	<u>✓</u>

ALLOWANCE FOR DECK ERECTIONS:—

Freeboard, Table C.....	<u>4-11/2</u>
Correction for Length, if required (Para. 12, 18, and 19)	<u>+ 1 1/2</u>
Freeboard by Table A, corrected for sheer, and for length, if required (Para. 12, 18, and 19) }	<u>7-5/2</u>
Difference	<u>2-4 1/2</u>
Percentage as below.....	<u>30.523</u>
	<u>= 8.698</u>
	<u>- 8 3/4</u>

Freeboard, Table A	<u>8-1</u>
Correction for Sheer	<u>10 1/2</u>
Correction for Length	<u>+ 3</u>
Allowance for Deck Erections	<u>7-5 1/2</u>
Correction for Round of Beam.....	<u>- 8 3/4</u>
Correction for fall in Sheer (if any).....	<u>✓</u>
Correction for Iron Deck (if required)	<u>- 1 3/4</u>
Additions for non-compliance with provisions of Para. 11 (d) and (e) †	<u>6-7</u>
Other Corrections (if any)	<u>✓</u>

Correction for R. Q. Dk. if engine and boiler openings not covered by bridge house (Para. 11)	<u>✓</u>	
Allowance for Deck Erections	<u>- 8 3/4</u>	
Length.	Length allowed.	Height.
Forecastle..... <u>38'-6" + houses</u>	<u>39.5</u>	<u>8-0</u>
Bridge House..... <u>121-9 including overhang</u>	<u>118.5</u>	<u>8-0</u>
† Raised Qr. Dk.....		
Poop..... <u>32-3</u>	<u>32.25</u>	<u>8-0</u>
Total	<u>190.25</u>	<u>4789.479</u>
Length of Ship	<u>397.25</u>	
Corresponding percentage (Para. 12, 18, or 19) }	<u>30.52</u>	

WINTER FREEBOARD

Winter Freeboard	<u>6-7</u>
Summer Freeboard	<u>6-1 1/4</u>
Indian Summer Freeboard	<u>5-7 1/2</u>
N.A. Winter Freeboard	<u>-</u>
Correction necessary because clearside amidships, measured in accordance with the Statute is not taken at the intersection of the wood or steel deck with side. }	<u>1 3/4</u>
Winter Freeboard from deck line	<u>6-8 3/4</u>
Summer " " " "	<u>6-3</u>
Indian Summer " " " "	<u>5-9 1/4</u>
N.A. Winter " " " "	<u>6-3</u>

FREEBOARD recommended amidships from centre of Disc to top of Statutory Deck Line, Wood (Steel) Deck:—

Fresh Water Line above centre of Disc	
Indian Summer Line " " " "	
Winter Line below " " " "	
Winter North Atlantic Line " " " "	

13 JAN 1926

† If the frames, skin planking, or ceiling are of unusual thickness the breadth of vessel to inside of ceiling should be reported if possible.
‡ In vessels obtaining an allowance for deck erections under Para. 11 where the sheer drops abaft amidships the height of the R.Q.D. is to be taken from the level of the top of the amidship beam.
§ In flush-decked vessels the total standard mean sheer means the sheer measured at the stem and sternpost. In vessels having poops and forecastles, it means the sheer measured at points distant one-eighth of the vessel's length from stem and sternpost.

† State dimensions of freeing port area on back of this form.
‡ The Surveyor should state whether the fall in sheer as reported is measured relatively to the straight line of keel or to the water line. If measured relatively to water line the percentage of deck area to be deducted should be reported, and also the usual load draft forward and aft should be reported.

RETAIN

RECEIVED
Lloyd's Register
16 JAN 1926
Foundation


W383-0207

Do all the Frames extend to the top height in the Poop? Yes Raised Quarter Deck? — Bridge House? Yes Forecastle? —
 To what height do the Reverse Frames extend? channel framing
 Has the Poop or Raised Quarter Deck an efficient Iron Bulkhead at the fore end? Yes
 Give particulars of the means for closing the openings in Bulkhead boards full height in riveted channels
 Is the Poop or Raised Quarter Deck connected with the Bridge House? no Has the Bridge House an efficient Bulkhead at the fore end? Yes
 Give particulars of the means for closing the openings in Bulkhead no openings
 What is the thickness of the Bridge Front plating? .40 and Coaming plate? .44
 Give scantlings and spacing of the Stiffeners 9x3 1/2 x 48 Bull Angles - 30" apart
 Are bracket plates fitted at each end of the Stiffeners? lugged Are hor'l. brackets fitted connecting Bridge Bulk'd. with Bulwarks? Yes
 Has the Bridge House an efficient Iron Bulkhead at the after end? Yes
 How are the openings closed? boards full height in riveted channels
 Is the Forecastle at least as high as the main or top-gallant rail? Yes Has the Forecastle an efficient Iron or Wood Bulk'd. at after end? Yes
 Are the Engine and Boiler openings covered by a Bridge, Poop, Raised Quarter Deck, or enclosed by a Strong Iron or Steel Deckhouse? by a bridge
 If the openings are not so protected are the exposed parts of the Casings efficiently constructed? —
 Give thickness of plating; scantlings and spacing of Stiffeners —
 What is the height of the exposed Casings? 7'-9" Are suitable means provided for closing all openings in them in bad weather? Yes
 Are the Weather Deck Hatchways efficiently constructed and at least equal to the requirements of Section 28 of the Rules for 1904-5? Give particulars below:— Yes

Position and Size.	No 1 for 2 31'-6" x 20'-0"		No 2 33'-0" x 20'-0"		No 3 24'-9" x 26'-0"		No 4 33'-0" x 26'-0"		No 5 30'-0" x 26'-0"	
	Ship.	Rule.	Ship.	Rule.	Ship.	Rule.	Ship.	Rule.	Ship.	Rule.
COAMING										
Height above top of DECK	43"	24"	53"	24"	30"	18"	43"	24"	38"	
Thickness	Sides.....	.44	.44	.44	.44	.44	.44	.44	.44	.44
	Ends.....	.44	.44	.44	.44	.44	.44	.44	.44	.44
SHIFTING BEAMS OR WEB PLATES	Number.....	five	five	five	five	five	five	five	five	five
	Section and Scantlings.....	19-14 1/2 x 36	do	19-14 1/2 x 37	do	2 beams + one web	do	19-14 1/2 x 37	do	19-14 1/2 x 37
	Material.....	4 x 3 x 44	do	4 x 3 x 44	do	17 1/2 - 13 x 36	do	4 x 3 x 44	do	4 x 3 x 44
* FORE AND AFTERS	Number.....									
	Section and Scantlings.....									
	Material.....			no fore and afters						
HATCHES	Thickness..... all 3" thick									
Remarks.....	good.									

* The depth of Fore and Afters should be stated from the underside of the hatches in all cases.
 (If the sill of the lowest side scuttle will be less than 6 inches above the Indian Summer Load Line if assigned under the tables, state vertical distance from top of deck at side amidships to lower edge of lowest side scuttle.)
 The following information is to be given in all Cases of vessels dealt with under Paras. 11, 12 (under 15 feet Moulded depth) and under Shelter Deck Rules.

What is the thickness of the Bridge Sheerstrake? — Strake between Main and Bridge Sheerstrakes? —
 Delete the words — The Crew are, are not, berthed in the bridge house.
 that do not apply — The arrangements to enable them to get backwards and forwards from their quarters are, are not satisfactory.
 Length of Bulwarks in well 210 ft ~~207 7/8~~ Forward 97.91 ~~112.75~~ Forward 40.85 ~~22.55~~ Aft 41.11 Sq. ft. For Class Only
 Area of Freeing Ports required by Para. 11 (e) each side of vessel = 19.58 ~~42.13~~ 22.55 Sq. ft. For Class Only
 Ft. Tenth. Ft. Tenth. No. Freeing Ports (each side of vessel) = 19.82 ~~43.25~~ 23.66 Sq. ft. Only
 Ft. Tenth. Ft. Tenth. No. 4.0 x 1.33 x 5.4
3.83 x 1.33 x 5
2.56 x 1.33 x 4
 Total deficiency or excess = .24 ~~1.12~~ 1.11 Sq. ft.

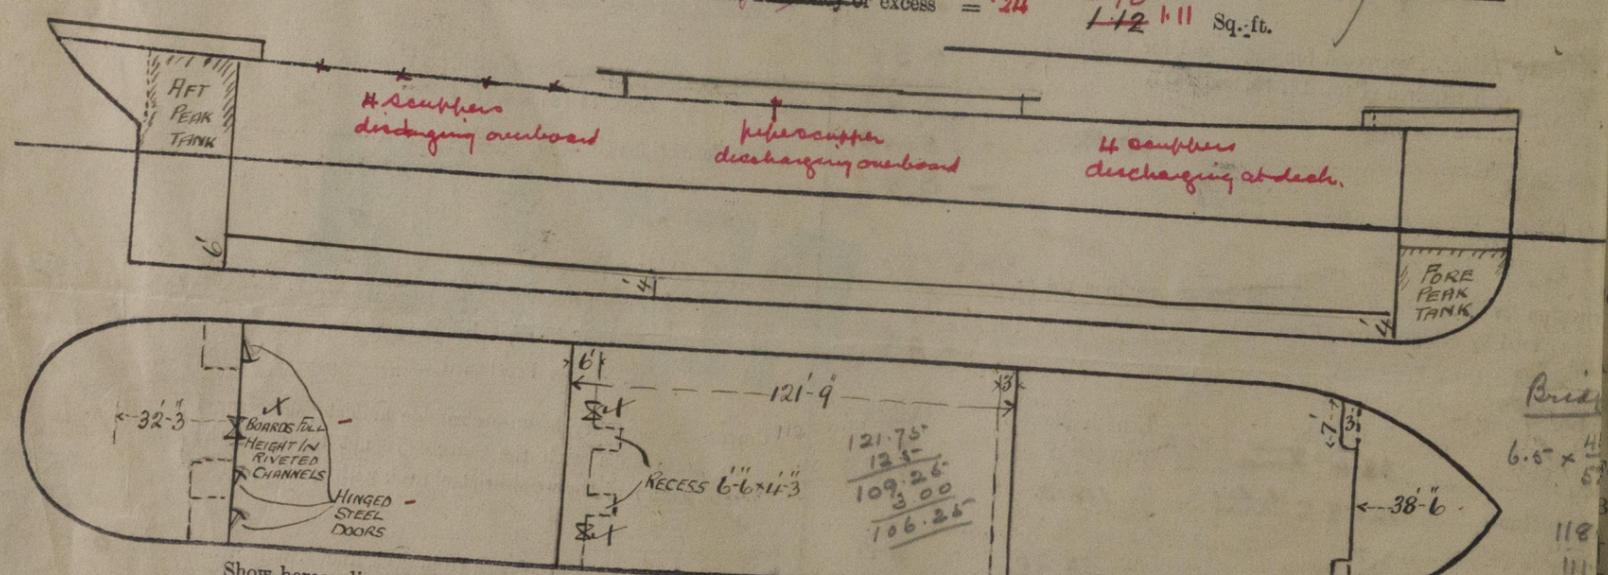

Show hereon line of Floors or Tank Top with position of any Breaks in same; also height of Peak Tank tops, &c., &c.
 State any special features in the construction of the Vessel —
 Builder's name and yard number Messrs Short Bros. Ltd. No 422 Displacement @ 25 3/4 draft 12024
 Names of sister vessels Similar to S/S Carlton 2/12/24 Tons per inch at L.W.L. 41.8 T
 Owners Carlton Steamship Co Ltd Request form 9 is forwarded here
 " Address Newcastle on Tyne

Fee £ 11 : 0 : 0 Received by me See F. L. Report
 will be charged on completion

