

Nº 664

AS FITTED MIDSHIP SECTION.

COMPLETE SUPERSTRUCTURE VESSEL.

RULE LENGTH 416'8 1/2", BREADTH MLD. 53'11 1/2", DEPTH MLD. 28'7".

CLASS: LLOYDS 100 A.1 "WITH FREEBOARD."

SCALE: 1/2" = ONE FOOT.

FORECASTLE SIDE PLATING 42

OWNERS EXTRAS.

(NOT INCLUDED IN SCANTLINGS SHOWN ON THIS PLAN)

SHELTER DECK STRINGER & SHEERSTRAKE INCREASED 10% ABOVE LLOYDS FOR 1/2 LTH. AMIDSHIPS.

SHELTER DECK PLATING INCREASED 10% ABOVE LLOYDS ALL FORE & AFT.

NUMERALS.

DEPTH FOR SCANTLINGS D:	28.58 + 8.0	=	36.58
L x D	416.71 x 36.58	=	15243
L x (B+D)	416.71 x (53.96 + 36.58)	=	37729
L/D (UPPER)	416.71 / 36.58	=	11.09
DEPTH d	24.98		



EQUIPMENT NUMERAL.

L x (B+D)	416.71 x (53.96 + 36.58)	=	38146
FORECASTLE	33.0 x 7.0 x 7.5	=	174
MIDSHIP DECKHOUSE	89.25 x 8.0 x 5.0	=	357
CAPTAIN'S HOUSE	31.5 x 8.0 x 5.0	=	126
HOUSE AFT	34.5 x 8.0 x 5.0	=	138
		=	38941

EQUIPMENT (LETTER AT)

3 BOW ANCHORS, STOCKLESS, COLLECTIVE WEIGHT	194 1/2 LBS.
1 STREAM ANCHOR, EX. STOCK	19 LBS.
270 FATHOMS 2 1/2" STUD LINK CABLE.	
90 " 5" - 1/2" S.W.R. STREAM LINE	
120 " 4 3/4" - 1/2" TONLINE	
2 @ 90 " 2 1/4" - 1/2" HANGERS	
2 @ 90 " 2 1/2" - 1/2" WARPS	

NOTE: ALL CHANNELS AND BULB ANGLES TO NEW BRITISH STANDARD SECTIONS.

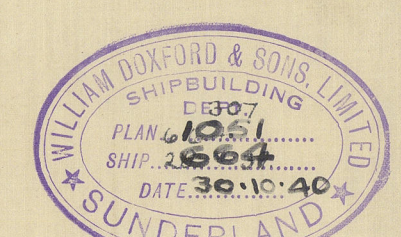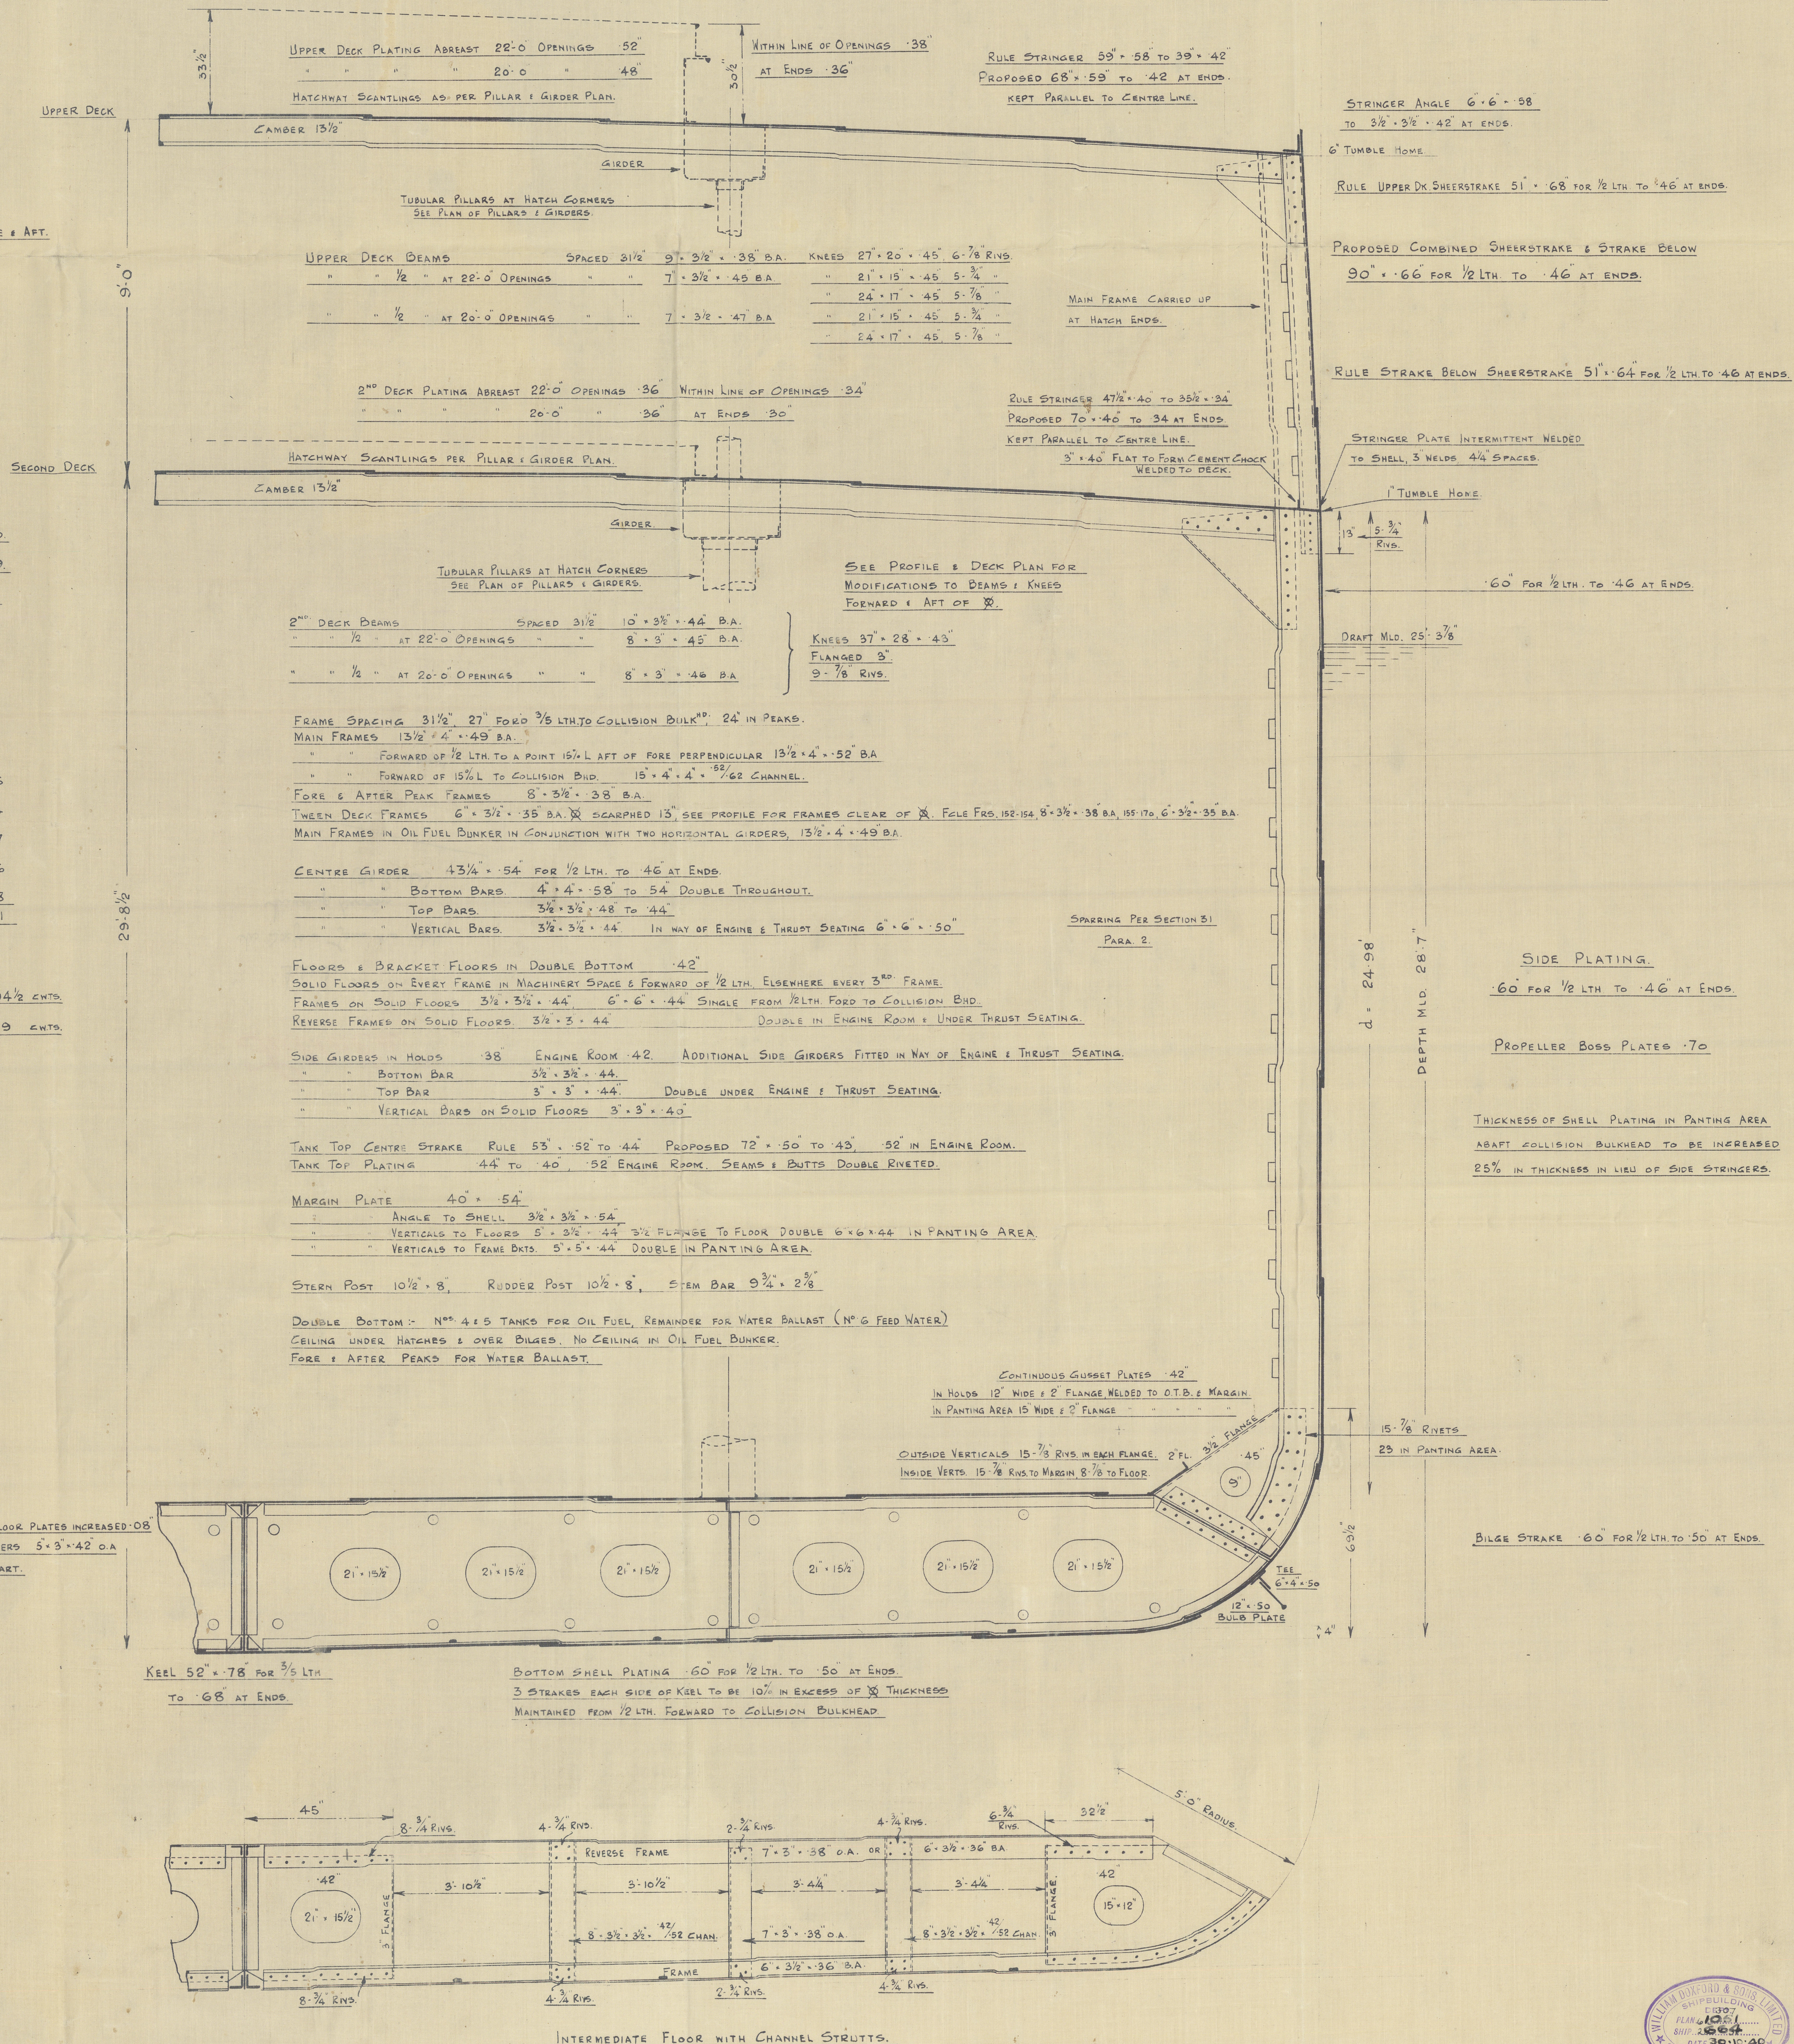

"Sultala"

"Sultala"

W. Daxford Jones' No. 664.

Friendship Section
(to Builder)

SUNDERLAND RPT. No. 32996

W39-0218



© 2020

Lloyd's Register
Foundation