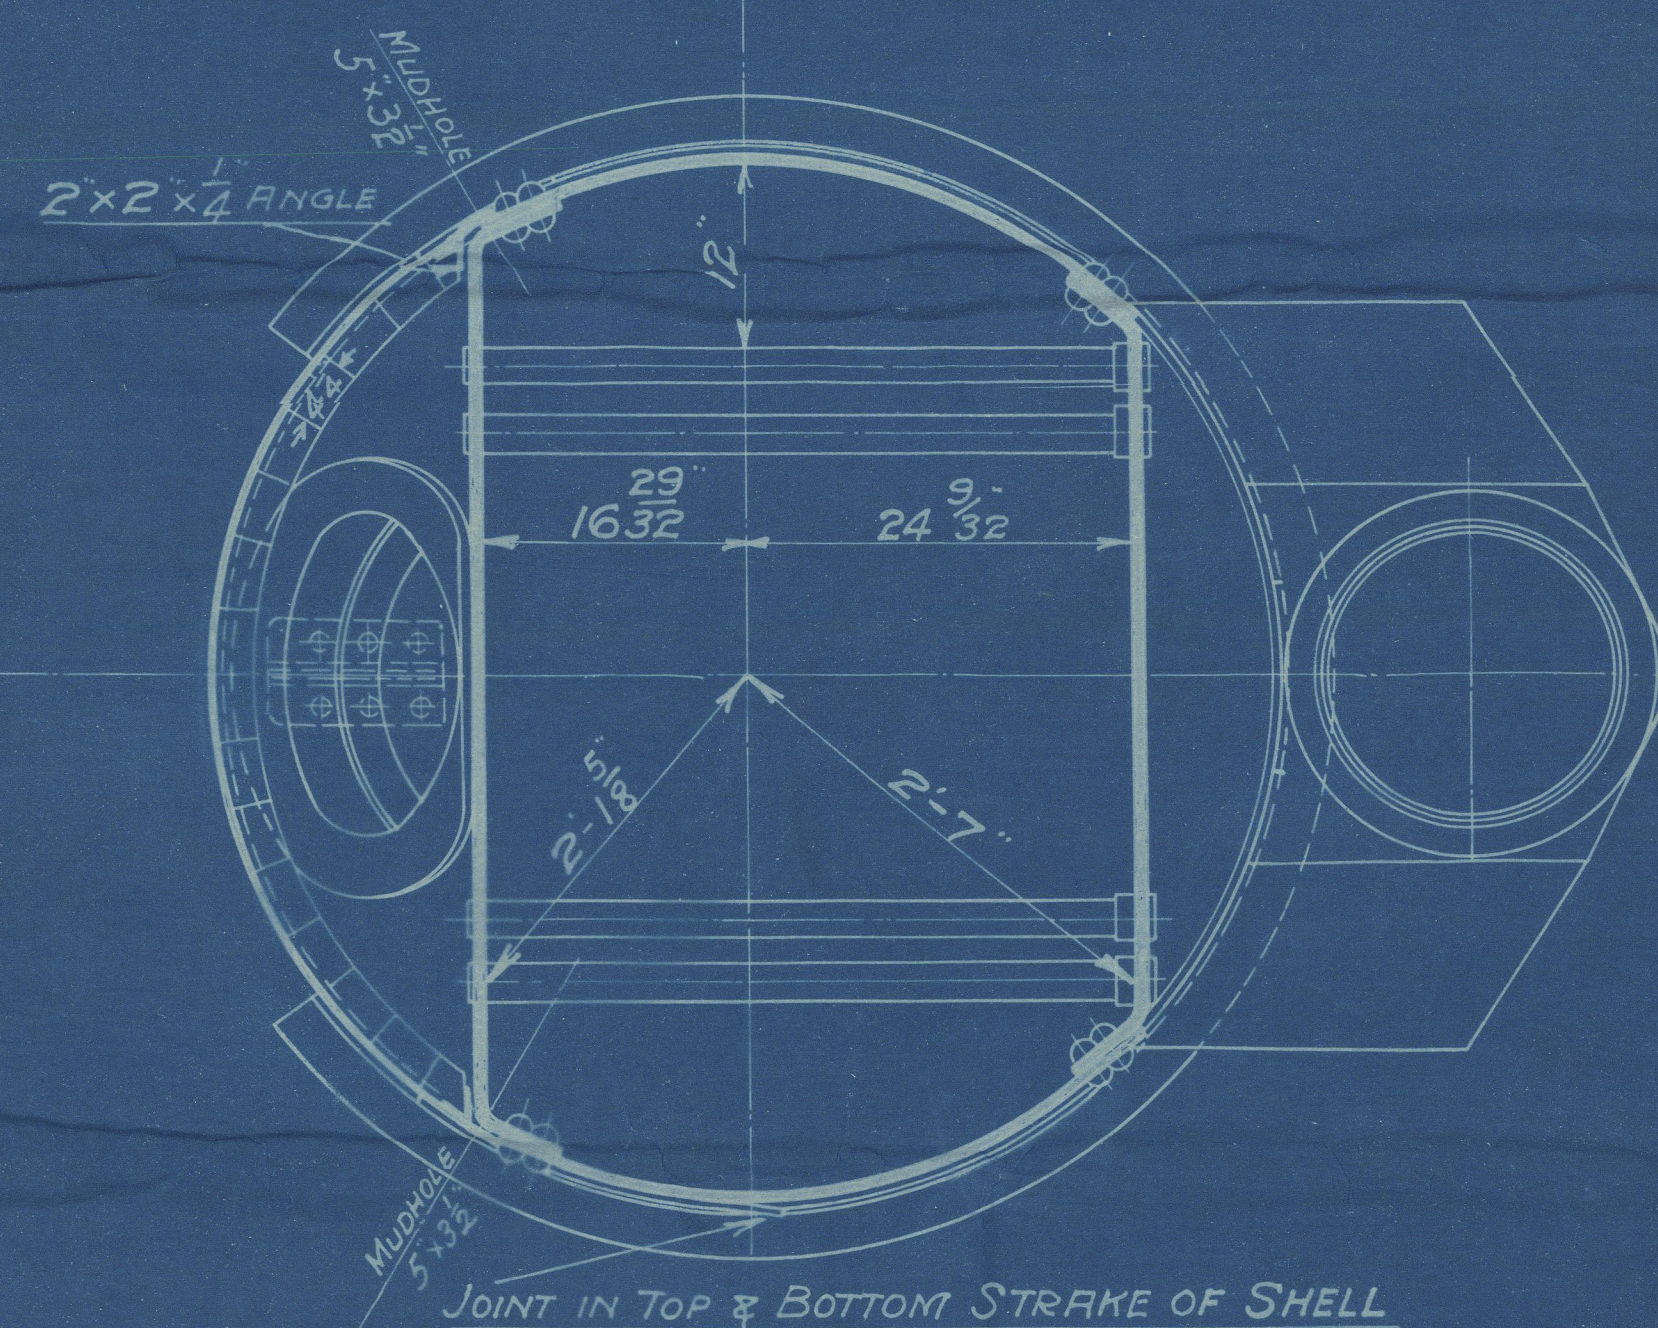


HORIZONTAL FLUE TUBES

PATENT BOILER. No 6584. *For approval*

SURVEY—LLOYDS & BOARD OF TRADE.

DRAWING N° 10644.

Cat 13566

D^BN^o 10611.

RETAIN


COCHRAN & CO., ANNAN, LD.

Boiler No. 6584

Drawing No. 10611.

Burmester & Wain 465 G

Lagarto

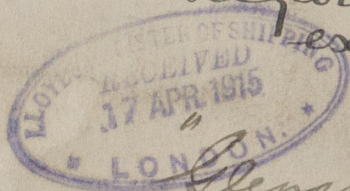

Glenary

GLASGOW REPORT No. 36376



W411-0171 © 2021



Lloyd's Register
Foundation