


21-10-13.

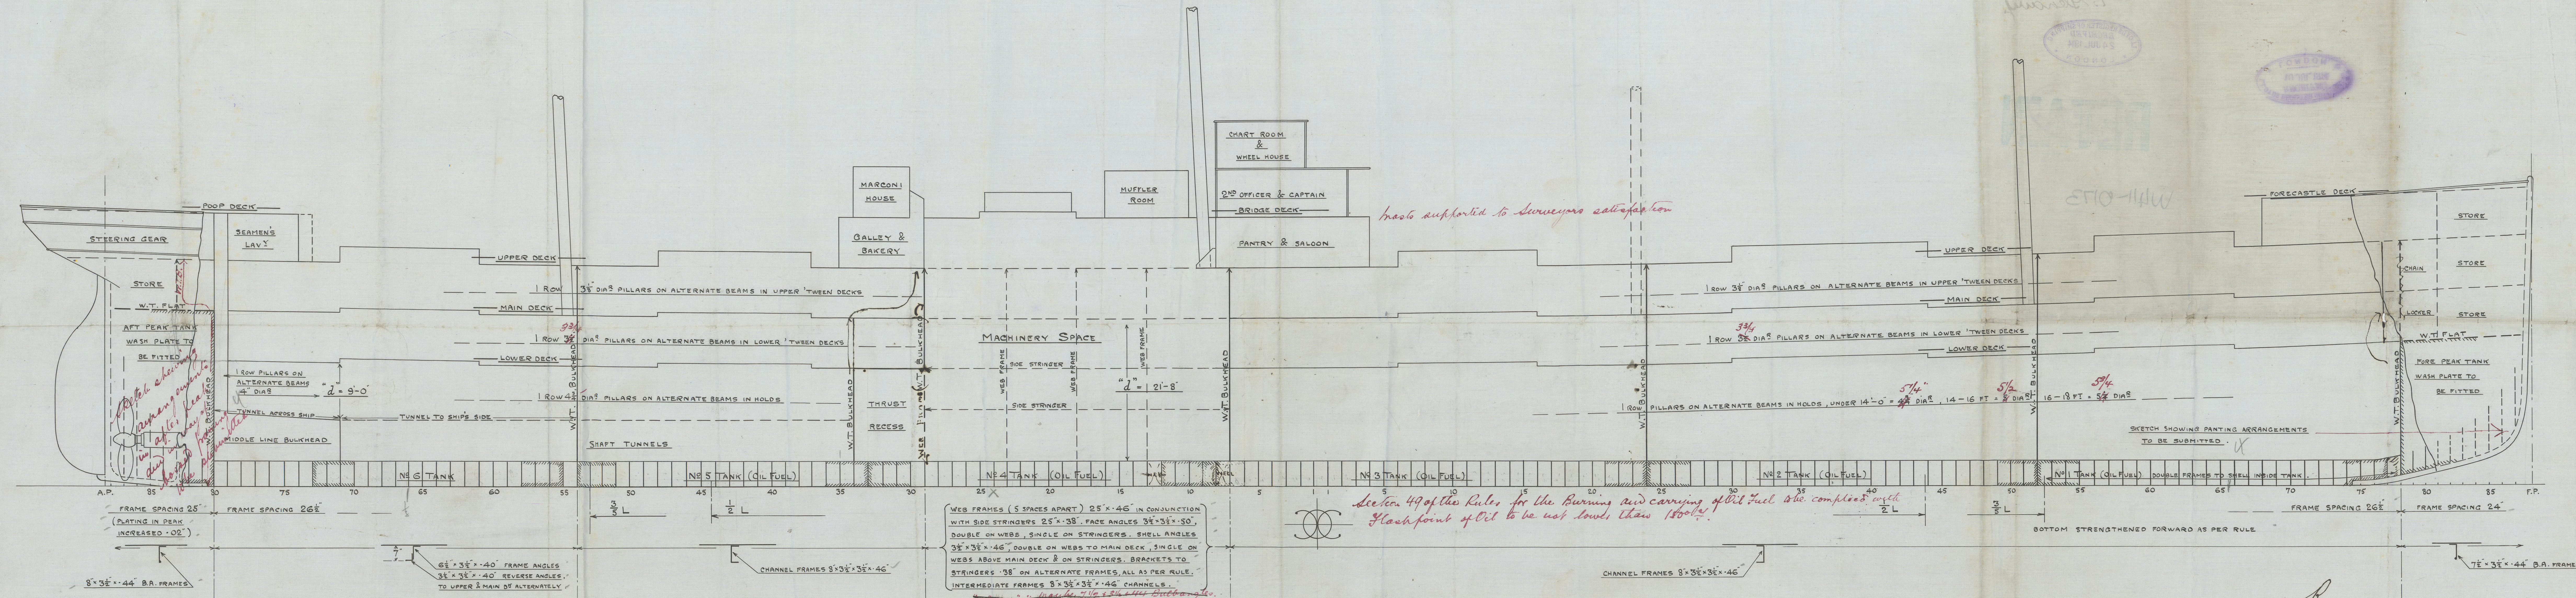

— LONGITUDINAL ELEVATION —  
 — PROPOSED T.S. MOTOR VESSEL N° 465 G. —  
 — 385'-0" x 52'-0" x 34'-6". K. to B., UPPER DECK, LOWEST POINT. —  
 — LLOYD'S 100 A.I. CLASS. —  
 — SCALE 1/8" = 1 FOOT —



Profile

Messrs. Harland & Wolff, Ltd.

No. 465 G.

Lagarto  
ex 37133  
to Glenary.



W411-0173



© 2021

Lloyd's Register  
Foundation