


M. S. "Høegh Merchant".

Messrs Buurmeister & Wain's


Yard No 582.

Midship Section (as built).

Copenhagen Lepat No 9449.

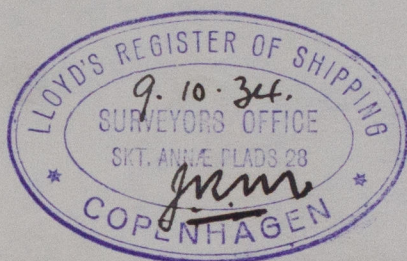

W42-0181

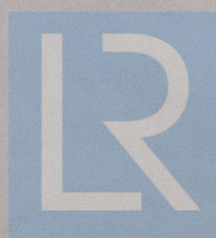

© 2020

Lloyd's Register
Foundation