

# YARD N° 582. PROFILE.



DIMENSIONS:  
LENGTH BETWEEN RP. = 385'-0"  
LOYD'S LENGTH = .96 (LENGTH BETW. RP. + CRUISERS) = 385'-0"  
BREADTH MOULDED = 54'-0"  
DEPTH ——— TO 2<sup>ND</sup> DECK = 28'-3"  
————— TO UPPERDECK = 36'-0"

SCALE: 1/8" = 1'-0"

SCANTLING NUMBERS:  
D = 36.25.  
L.D = 13956.  
L.(B+D) = 34746.  
56 + 10.48 = d = 24.11.

ALL BULBANGLE SECTIONS ARE NEW BRITISH STANDARDS.  
PILARS OF TENSILE STRENGTH 35 TONS PR. 50 INCH.

SINGLE SCREW CARGO SHIP.  
VESSEL BUILD TO CLASS: LLOYD'S 100 A.1. WITH FREEBOARD.  
AS COMPLETE SUPERSTRUCTURE VESSEL WITH TONNAGE OPENING.  
DOUBLE BOTTOM ARRANGED TO CARRY OIL FUEL & WATER BALLAST.  
OIL FUEL OF A FLASHPOINT ABOVE 150° FAHR.

  




U. S. "Hoegh Merchant"

Messrs Brunmeister & Wain's

Yard No 582.

Profile and Decks (as built).

Copenhagen Report No. 9449.

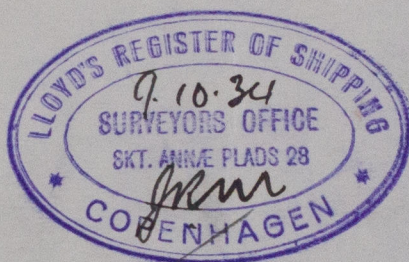

W42-0183



© 2020

Lloyd's Register  
Foundation