
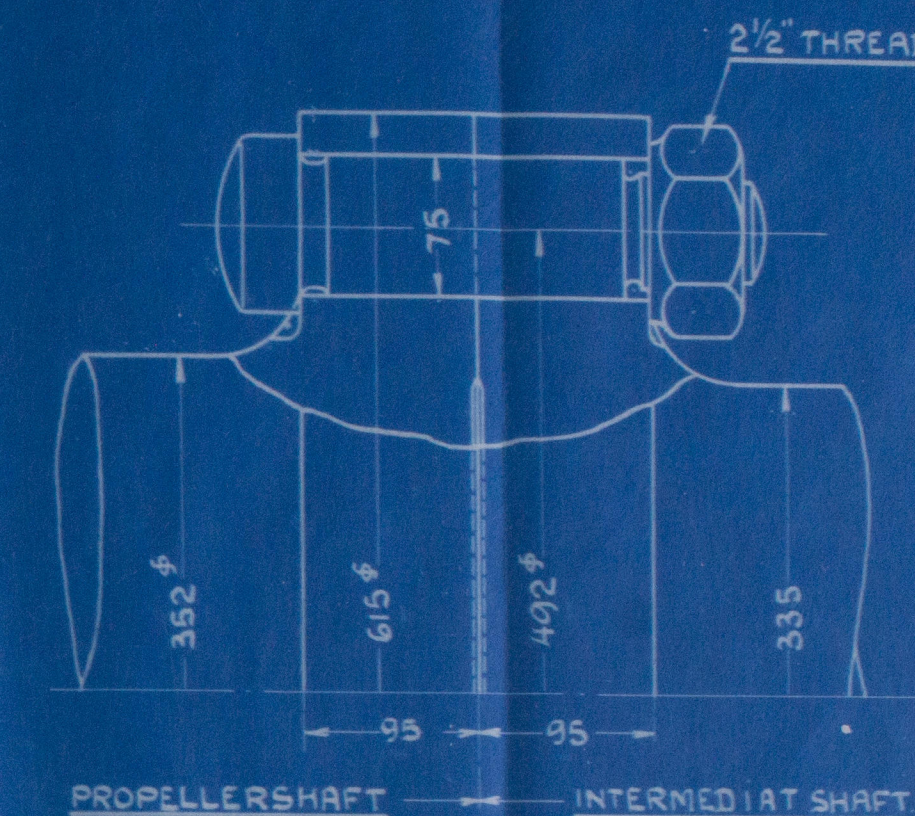


45800

A

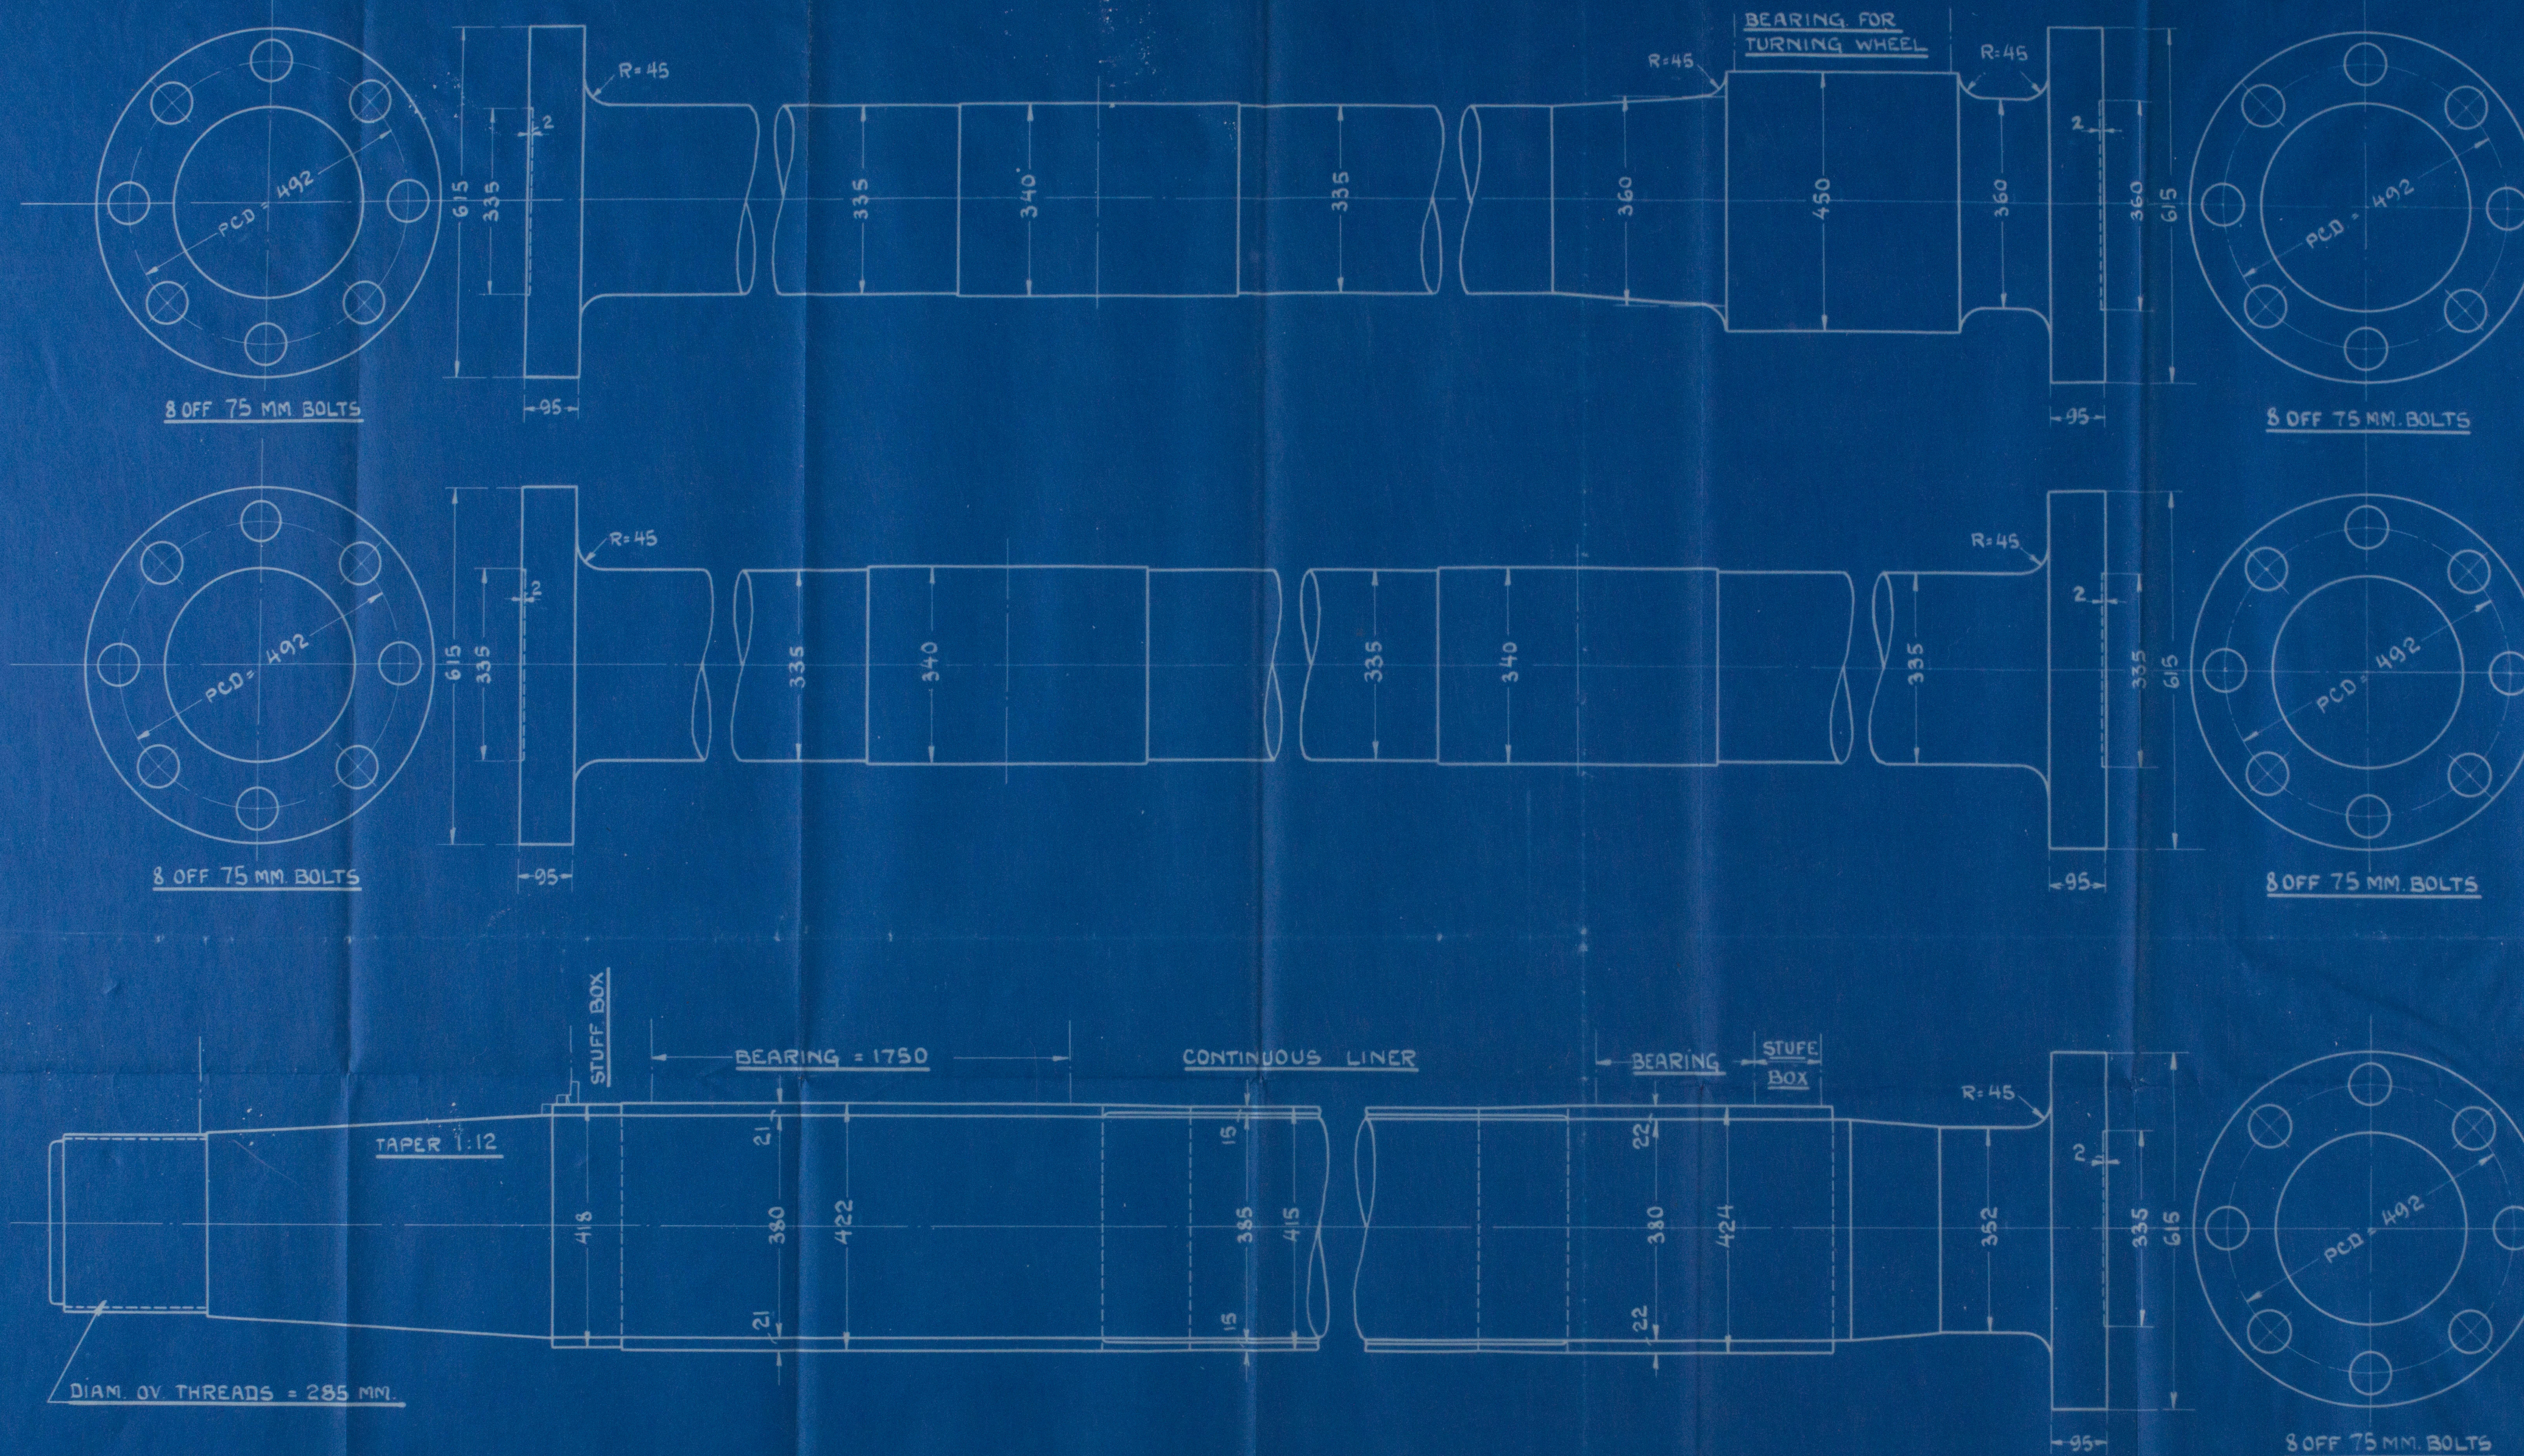

YARD N° 582

SHAFTS FOR 6 CYLINDER TWO STROKE CYCLE DOUBLE ACTING DIESEL ENGINE WITH SOLID INJECTION

CYLINDER DIAM = 450 MM

ROTATING BALANCE WEIGHT AT CRANK SHAFT = 26480 KG M²

STROKE = 1200 "

TURNING WHEEL = 2400 "

REVS. PR. MIN. = 115

TOTAL G-D² = 28880 "

DIAM OF PROPELLER = 5180 MM

G = ROTATING WEIGHTS D = GYRATIONS DIAM

BHP = 3400

Aktieselskabet
 Burmeister & Wains Maskin- og Skibsbyggeri
 København.
 16-12-1933

E.B.

W.13
22/12/33

W.13


AKTIESELSKABET
 BURMEISTER & WAIN'S
 MASKIN & SKIBSBYGGERI
 16 · 12 · 1933 N° 45800A

W 42-0185

Amended place of
intermediate & propeller shafts
for


6 cyl. 2 S. b. D. A. main diesel
oil engine for Gard No 582
being built by

AKTIESELSKABET
BURMEISTER & WAIN'S MASKIN- OG SKIBSBYGBERI
Copenhagen

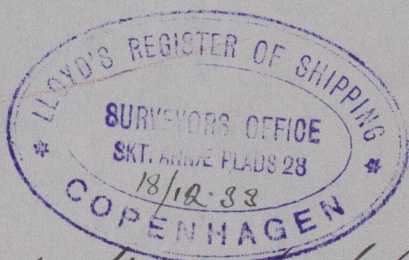

M/s. Hoegh Merchant of Oslo
Copenhagen Report No. 9449.

W 42 - 0185

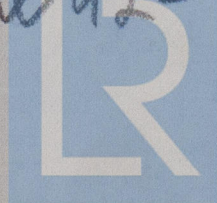

Lloyd's Register
Foundation