

CRANK SHAFT FOR YARD N<sup>o</sup> 582

AUXILIARY ENGINE

1 CYLINDER 2 S.C.S.A.DIESEL ENGINE WITH SOLID INJECTION

CYL. DIAM. 220<sup>M</sup>/M STROKE 370<sup>M</sup>/M


4 Nuvu






Crank Shaft  
for  
1. Cyl. Auxiliary engine  
for yard No 582  
being built by

AKTIESELSKABET  
BURMEISTER & WAINES MASKIN OG SKIBSREPARATION  
H. Klever

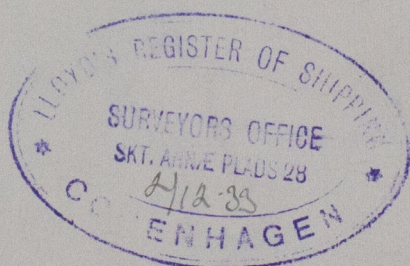

M. Hoegh Merchant of Cph.  
Copenhagen Report No 9449.

W42-0186

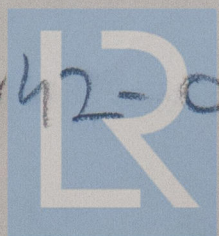

© 2020

Lloyd's Register  
Foundation