


Returned


Ayrshire Dockyard Co. Ltd.
DRAWING OFFICE
W.S.D.
8 APR 1925
No. 1164
Irvine

DIMENSIONS - 245'0" x 36'0" x 14'6" & 22'0" MLD.
TO BE CLASSED 100A1 LLOYDS (WITH FREEBOARD) 1924-25 RULES

PILLARS & GIRDERS TO BE SUBMITTED
PILLARS IN MACHINERY SPACE TO SURVEYOR'S SATISFACTION

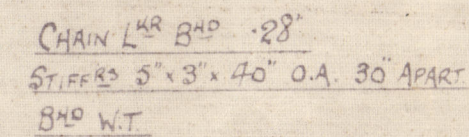

FOR HATCH-END BEAMS SEE
'PILLARS & GIRDERS'

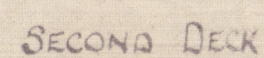

W 429-0095 Lloyd's Register Foundation

Ayrshire H-497

Profile & Backs

RETAIN

Merel
GLASGOW REPORT No. 45026

W429-0095



© 2020

Lloyd's Register
Foundation