
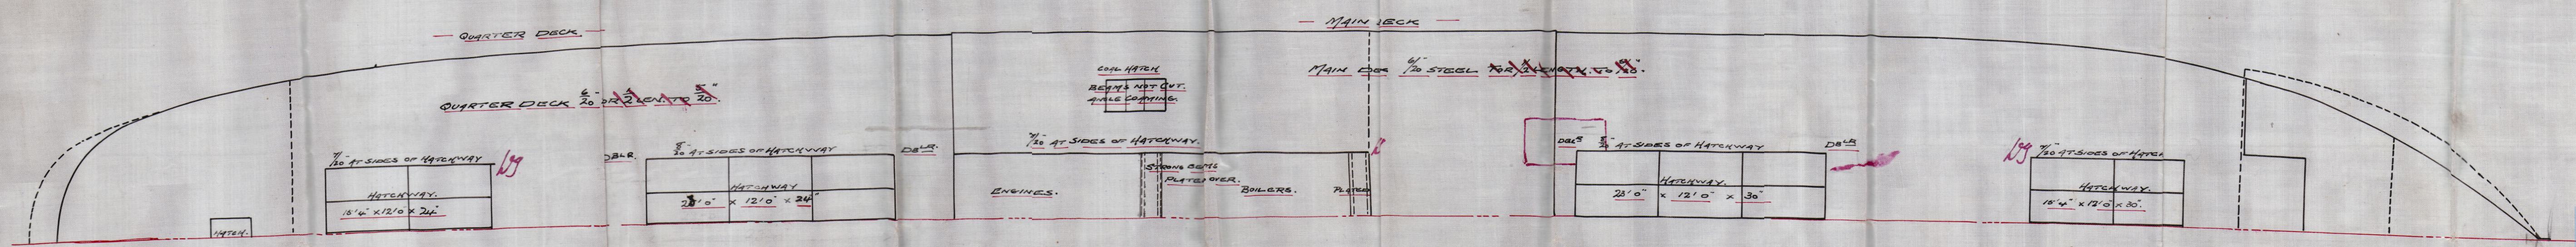
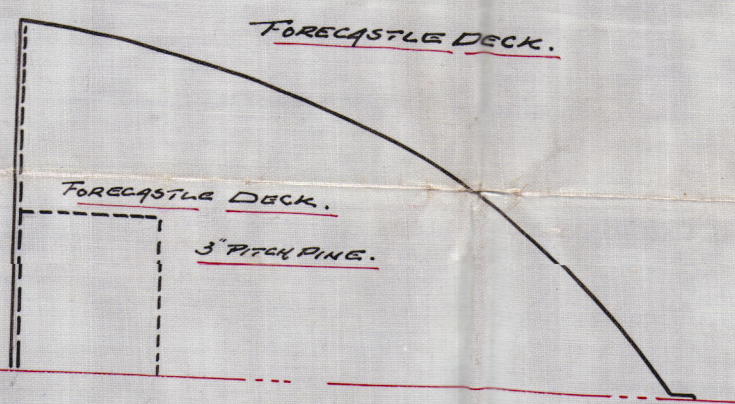
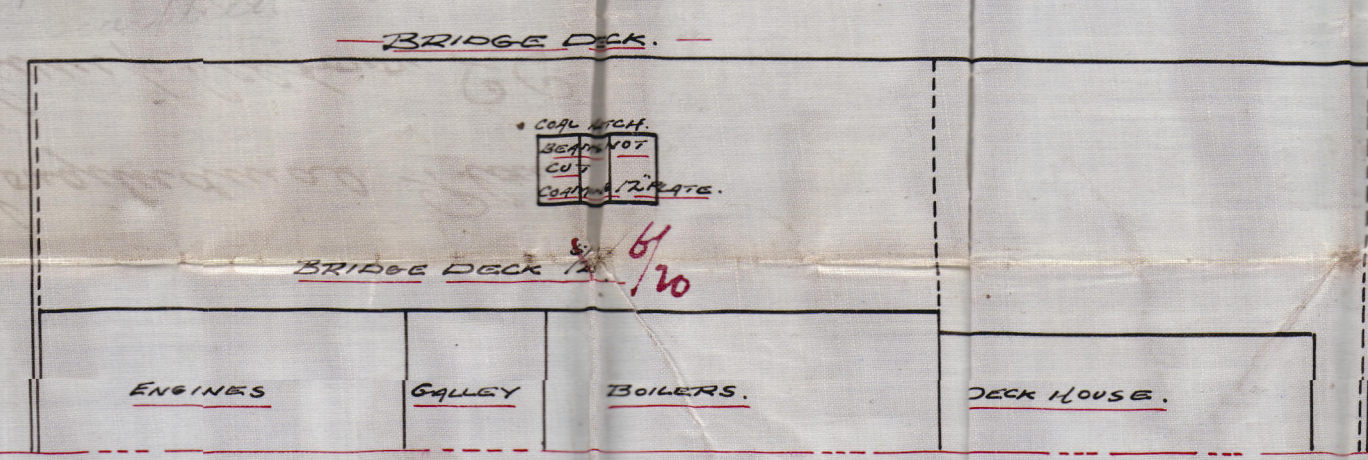
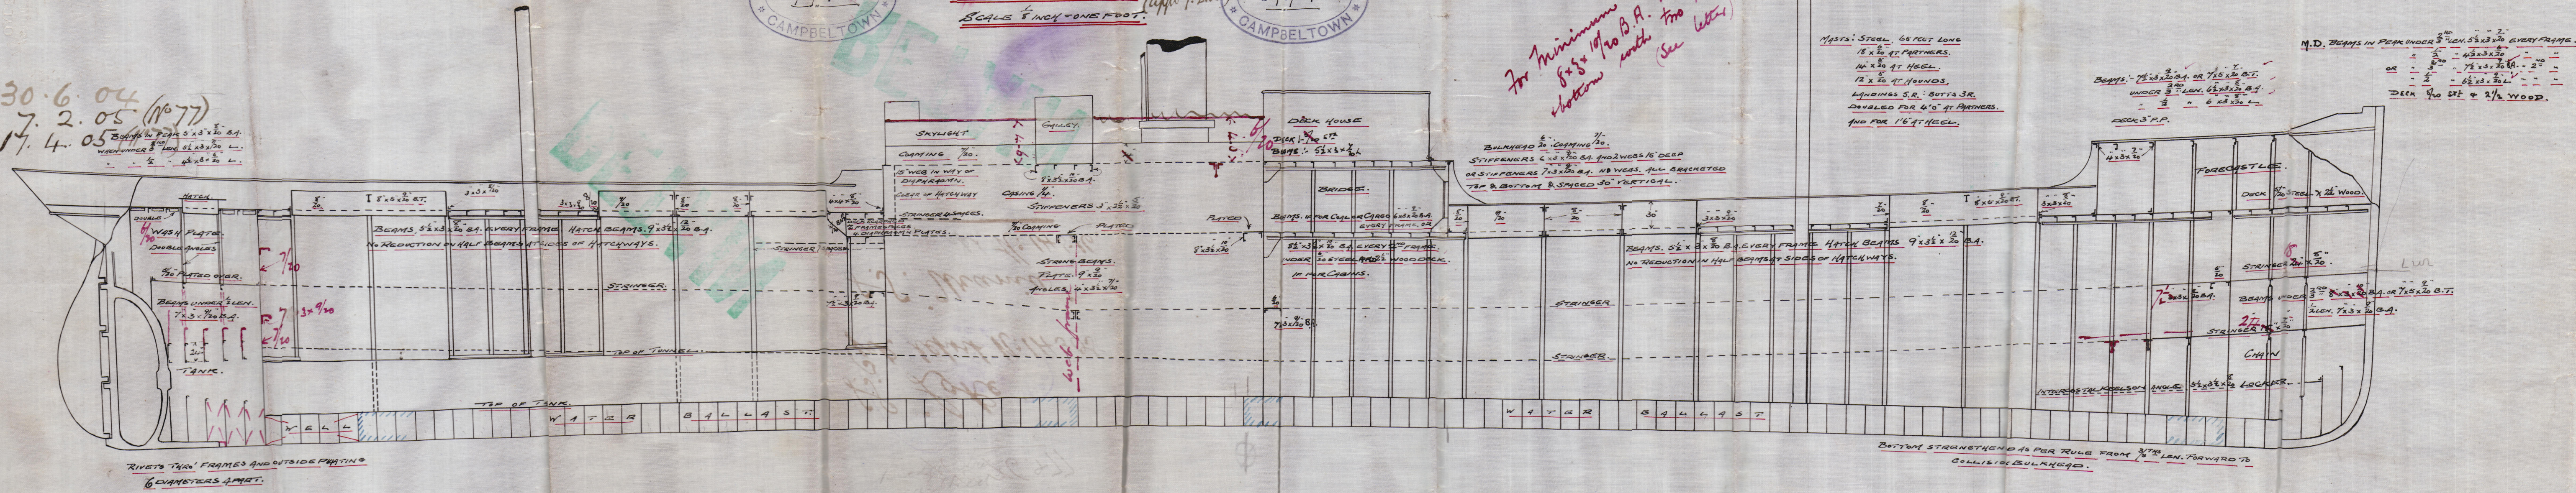


LONGITUDINAL SECTION.
S. B. No. 70. also No 71
SCALE $\frac{1}{2}$ INCH = ONE FOOT. (app'd) 7-2

For minimum
8' x 8' 10' 20 B.A.
bottom south Freeboard bracketed 1st
two webs
(See letter)

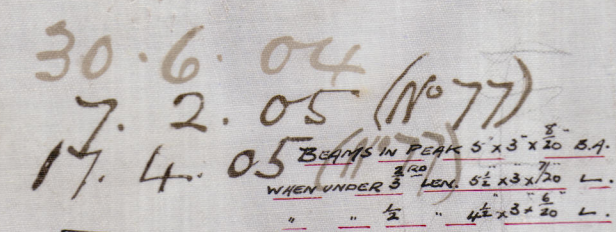

J.F.L.
29/6/04 7.2.05 17.4.05



W429-0174

Longitudinal Plan
Campbelltown SC

No 76. & 77

S.S. Loke
Grk report No: 14305

S.S. Urania
No: 14516.

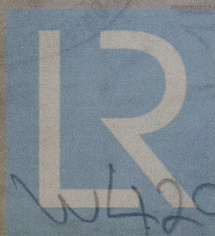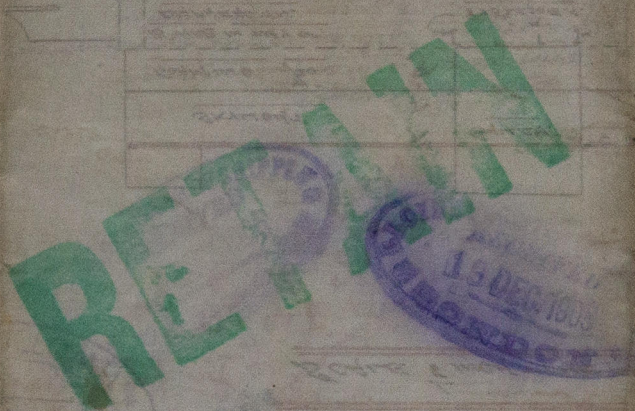

© 2020

Lloyd's Register
Foundation