


SCALE $\frac{1}{2}$ INCH = ONE FOOT.

7. 2.05 (No 77)
17. 4.05 (No 77)

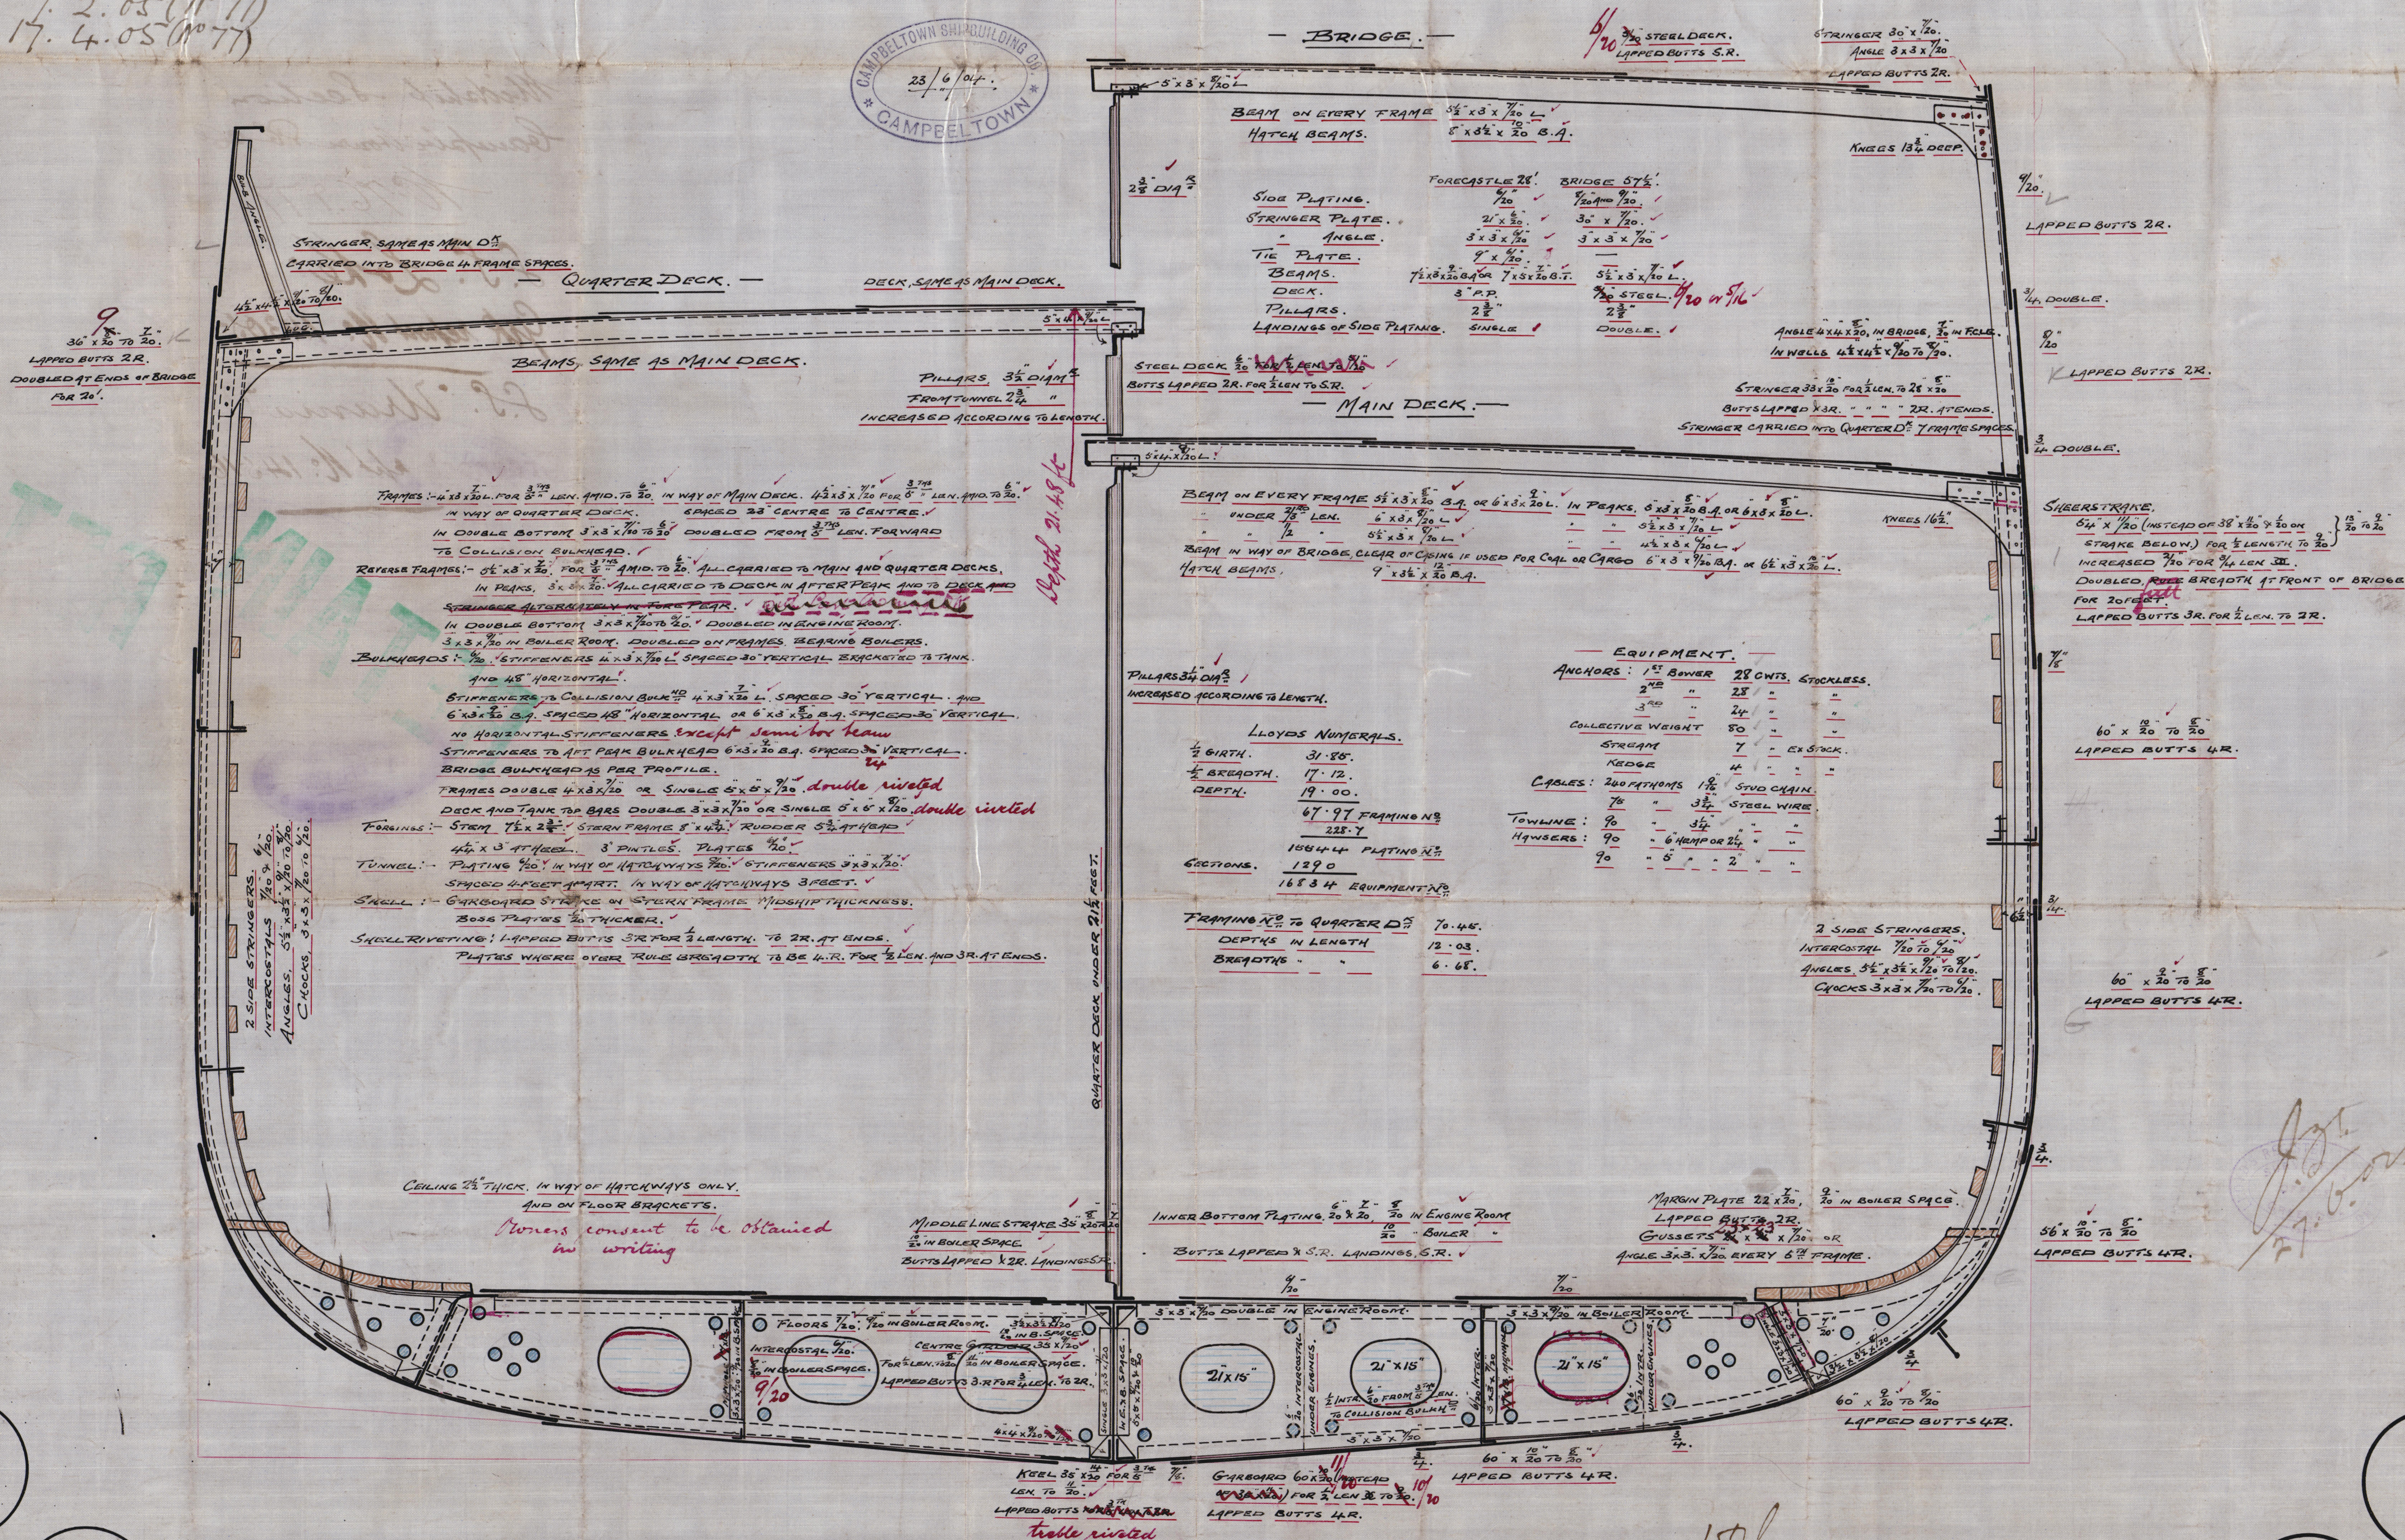

29/6/04

Midship Section
Campbelltown No 26
No 76.977

S.S. Loke.
Grk report No. 14305-

S.S. "Urania"
rpt No. 14516.

RETAIN

© 2020

Lloyd's Register
Foundation

W429-0175