





S. S. N°243 *245*
— BEAM ARRANGEMENT —

SCALE 1/8" = 1 FOOT

26.10.05
30.10.05

*red 3 1/2" x 1/2" all
if 1/4" deck.*

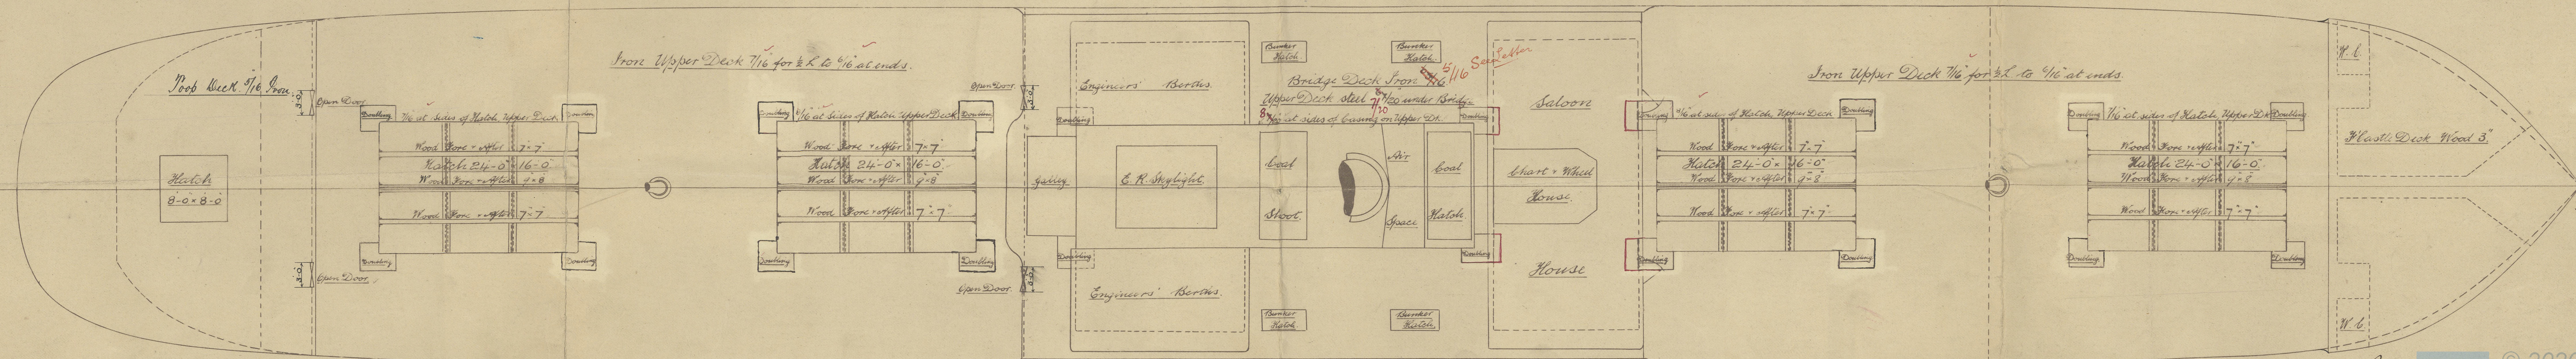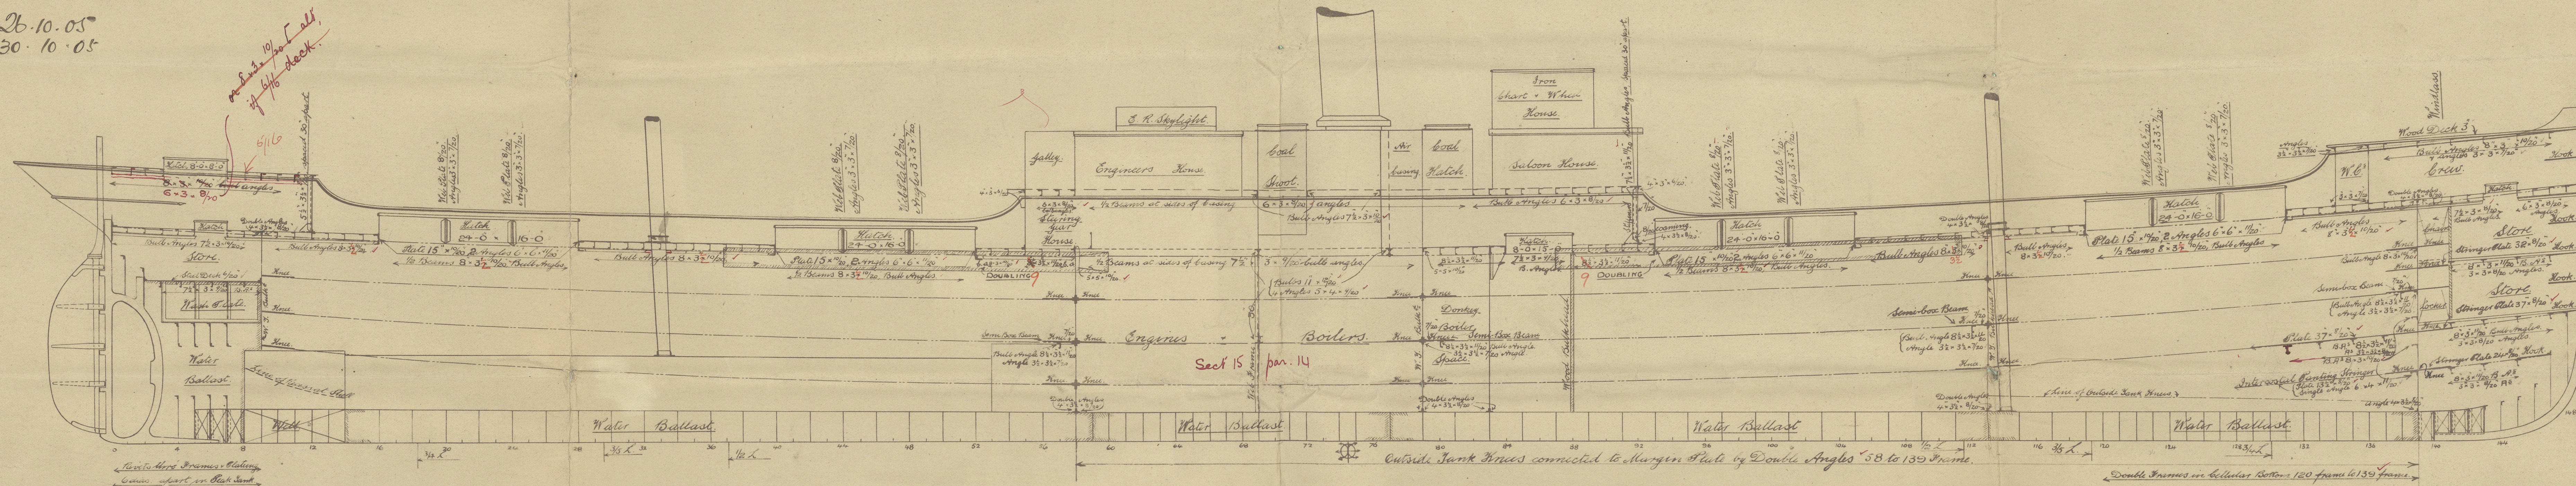

R Thompson & Sons

Profile

No 243 & 244

S.S. "Gedargrove"
Hd. S. E. No 22948

S.S. "Snestad"
Hd. S. E. No 23200

Wm. Wain

Swanton

~~Please return~~



W438-0068

Wainwright Register
Foundation