


T.S.S. "TAIROA"

PROPOSED FILTER RECESS IN BUNKER.



SCALE $\frac{1}{2}" = 1\text{ FT.}$

STARBOARD

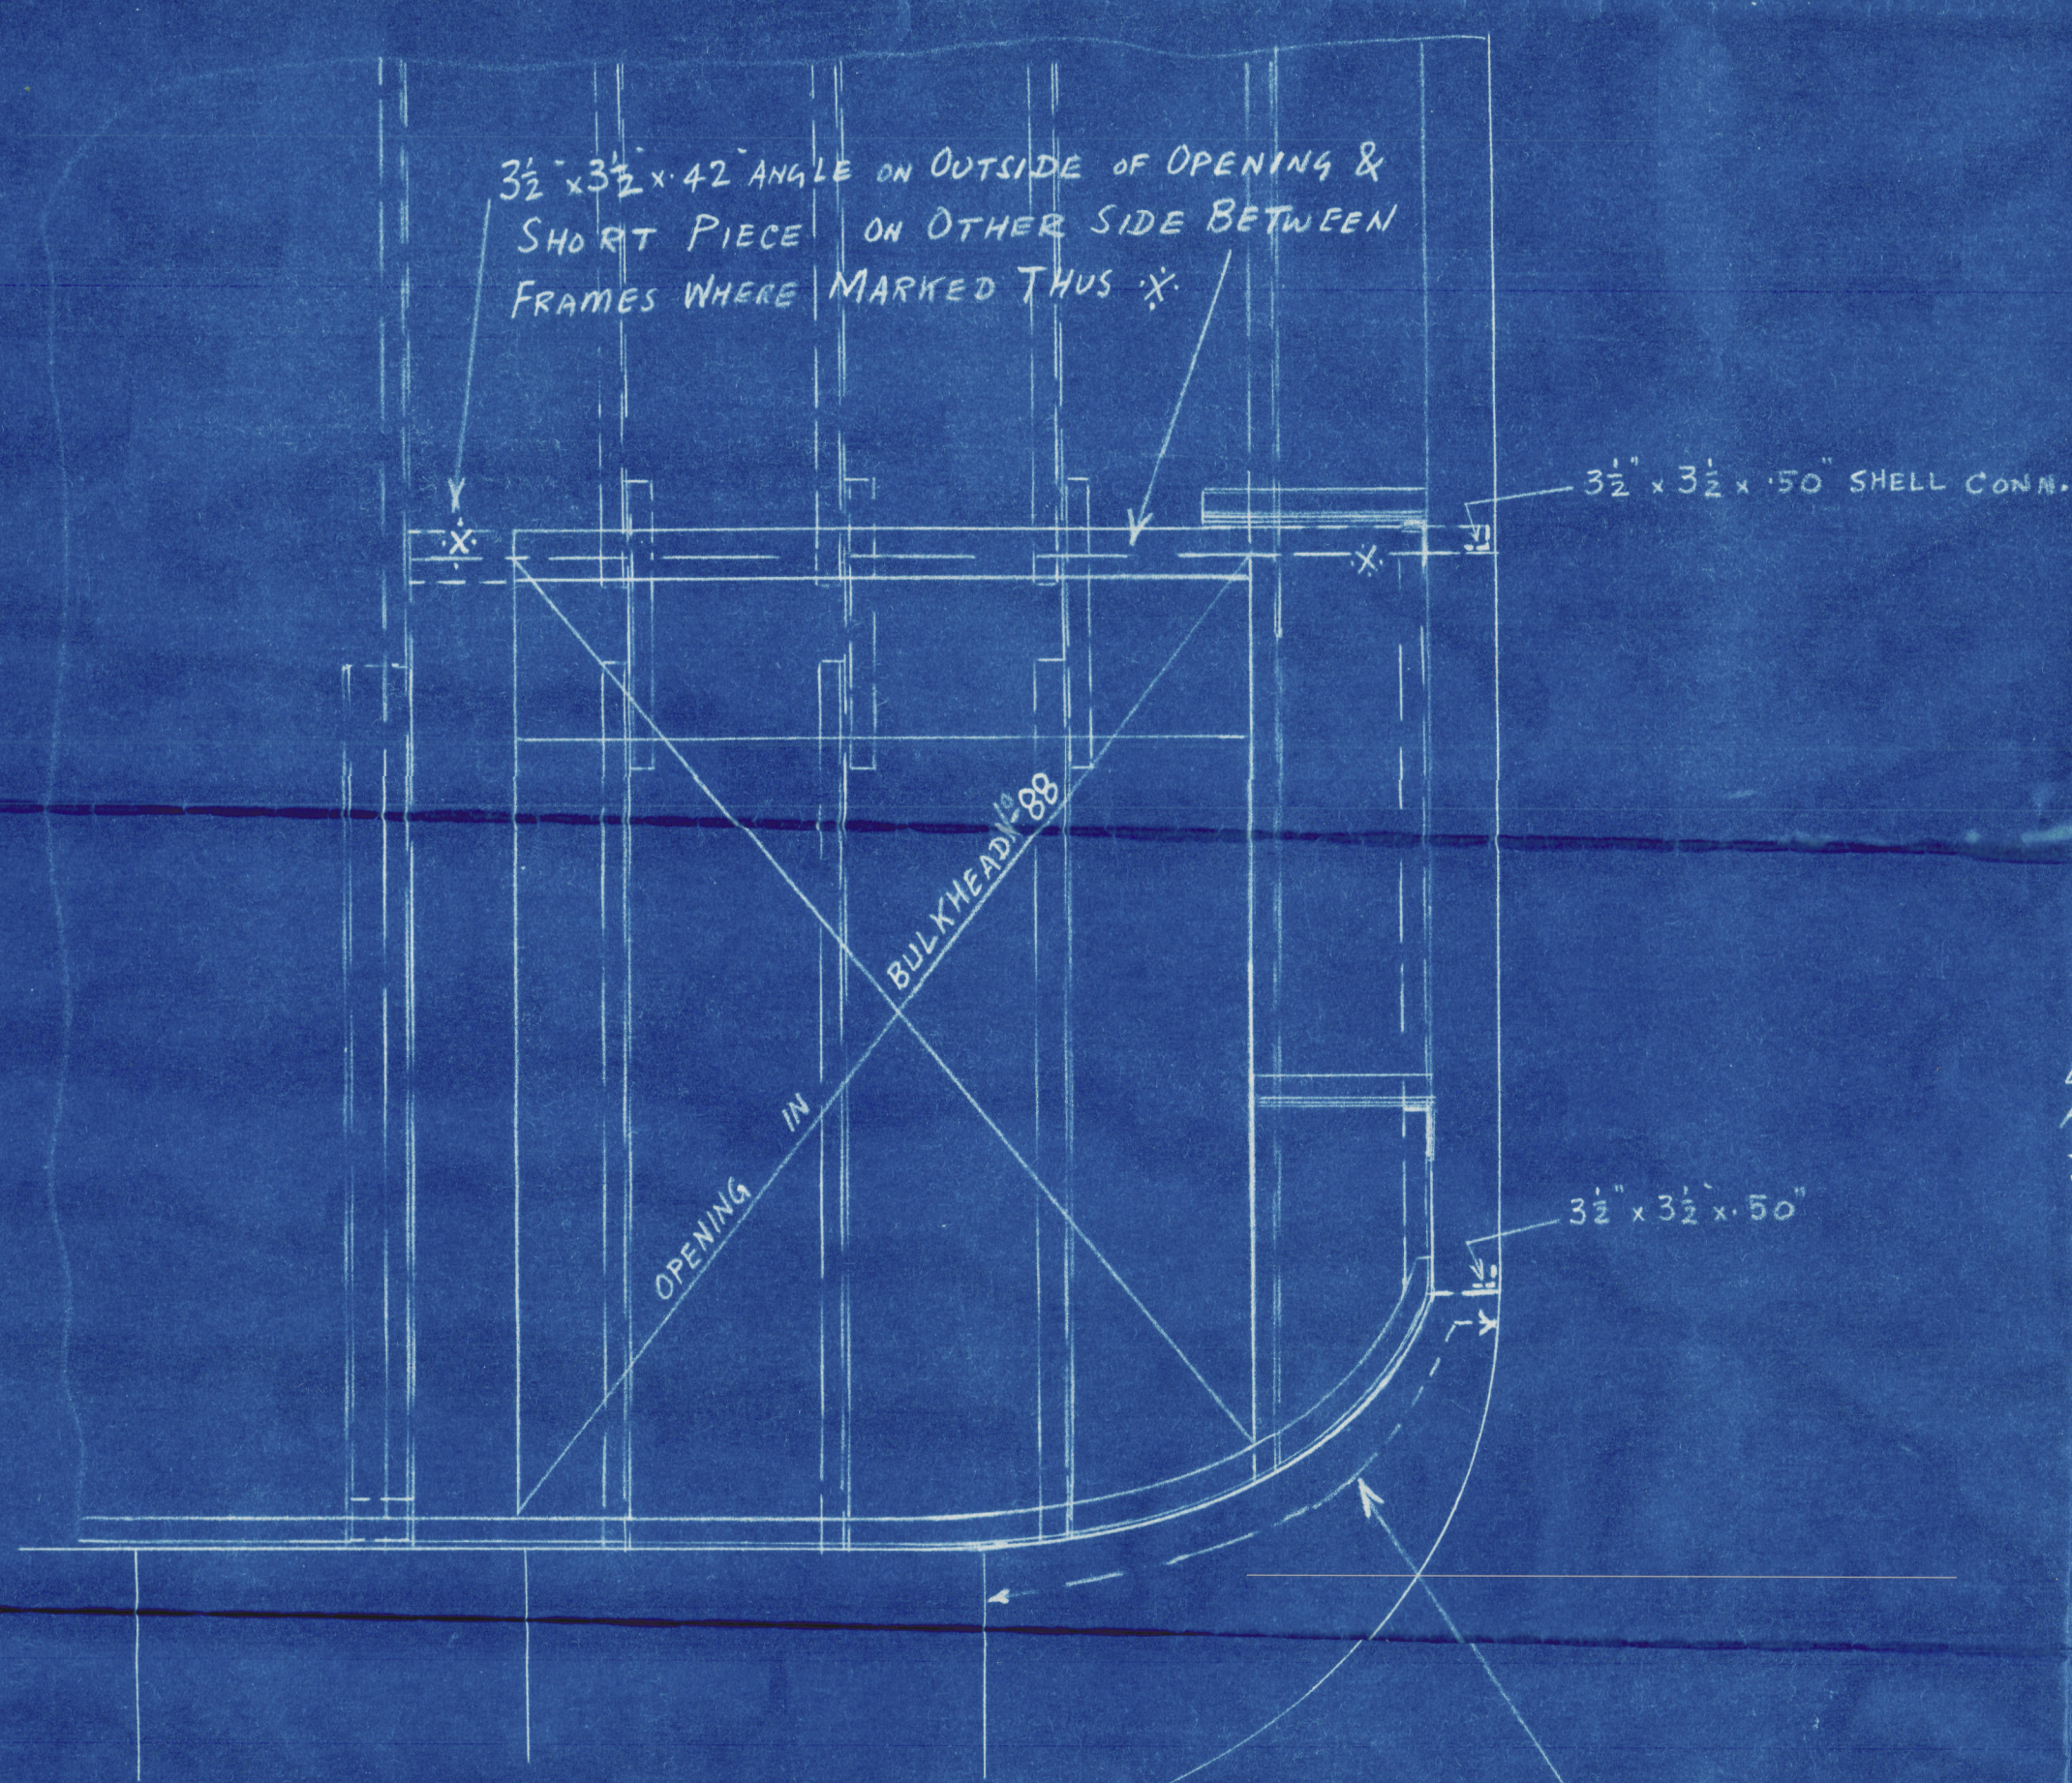


VIEW ON W.T. BULKHEAD NO 88
LOOKING FORWARD.

FRAMES TO BE PLATED OVER
FROM SHIP'S SIDE TO TANK TOP
& TO BE WATERTIGHT. PLATING $\frac{1}{2}"$ THICK.

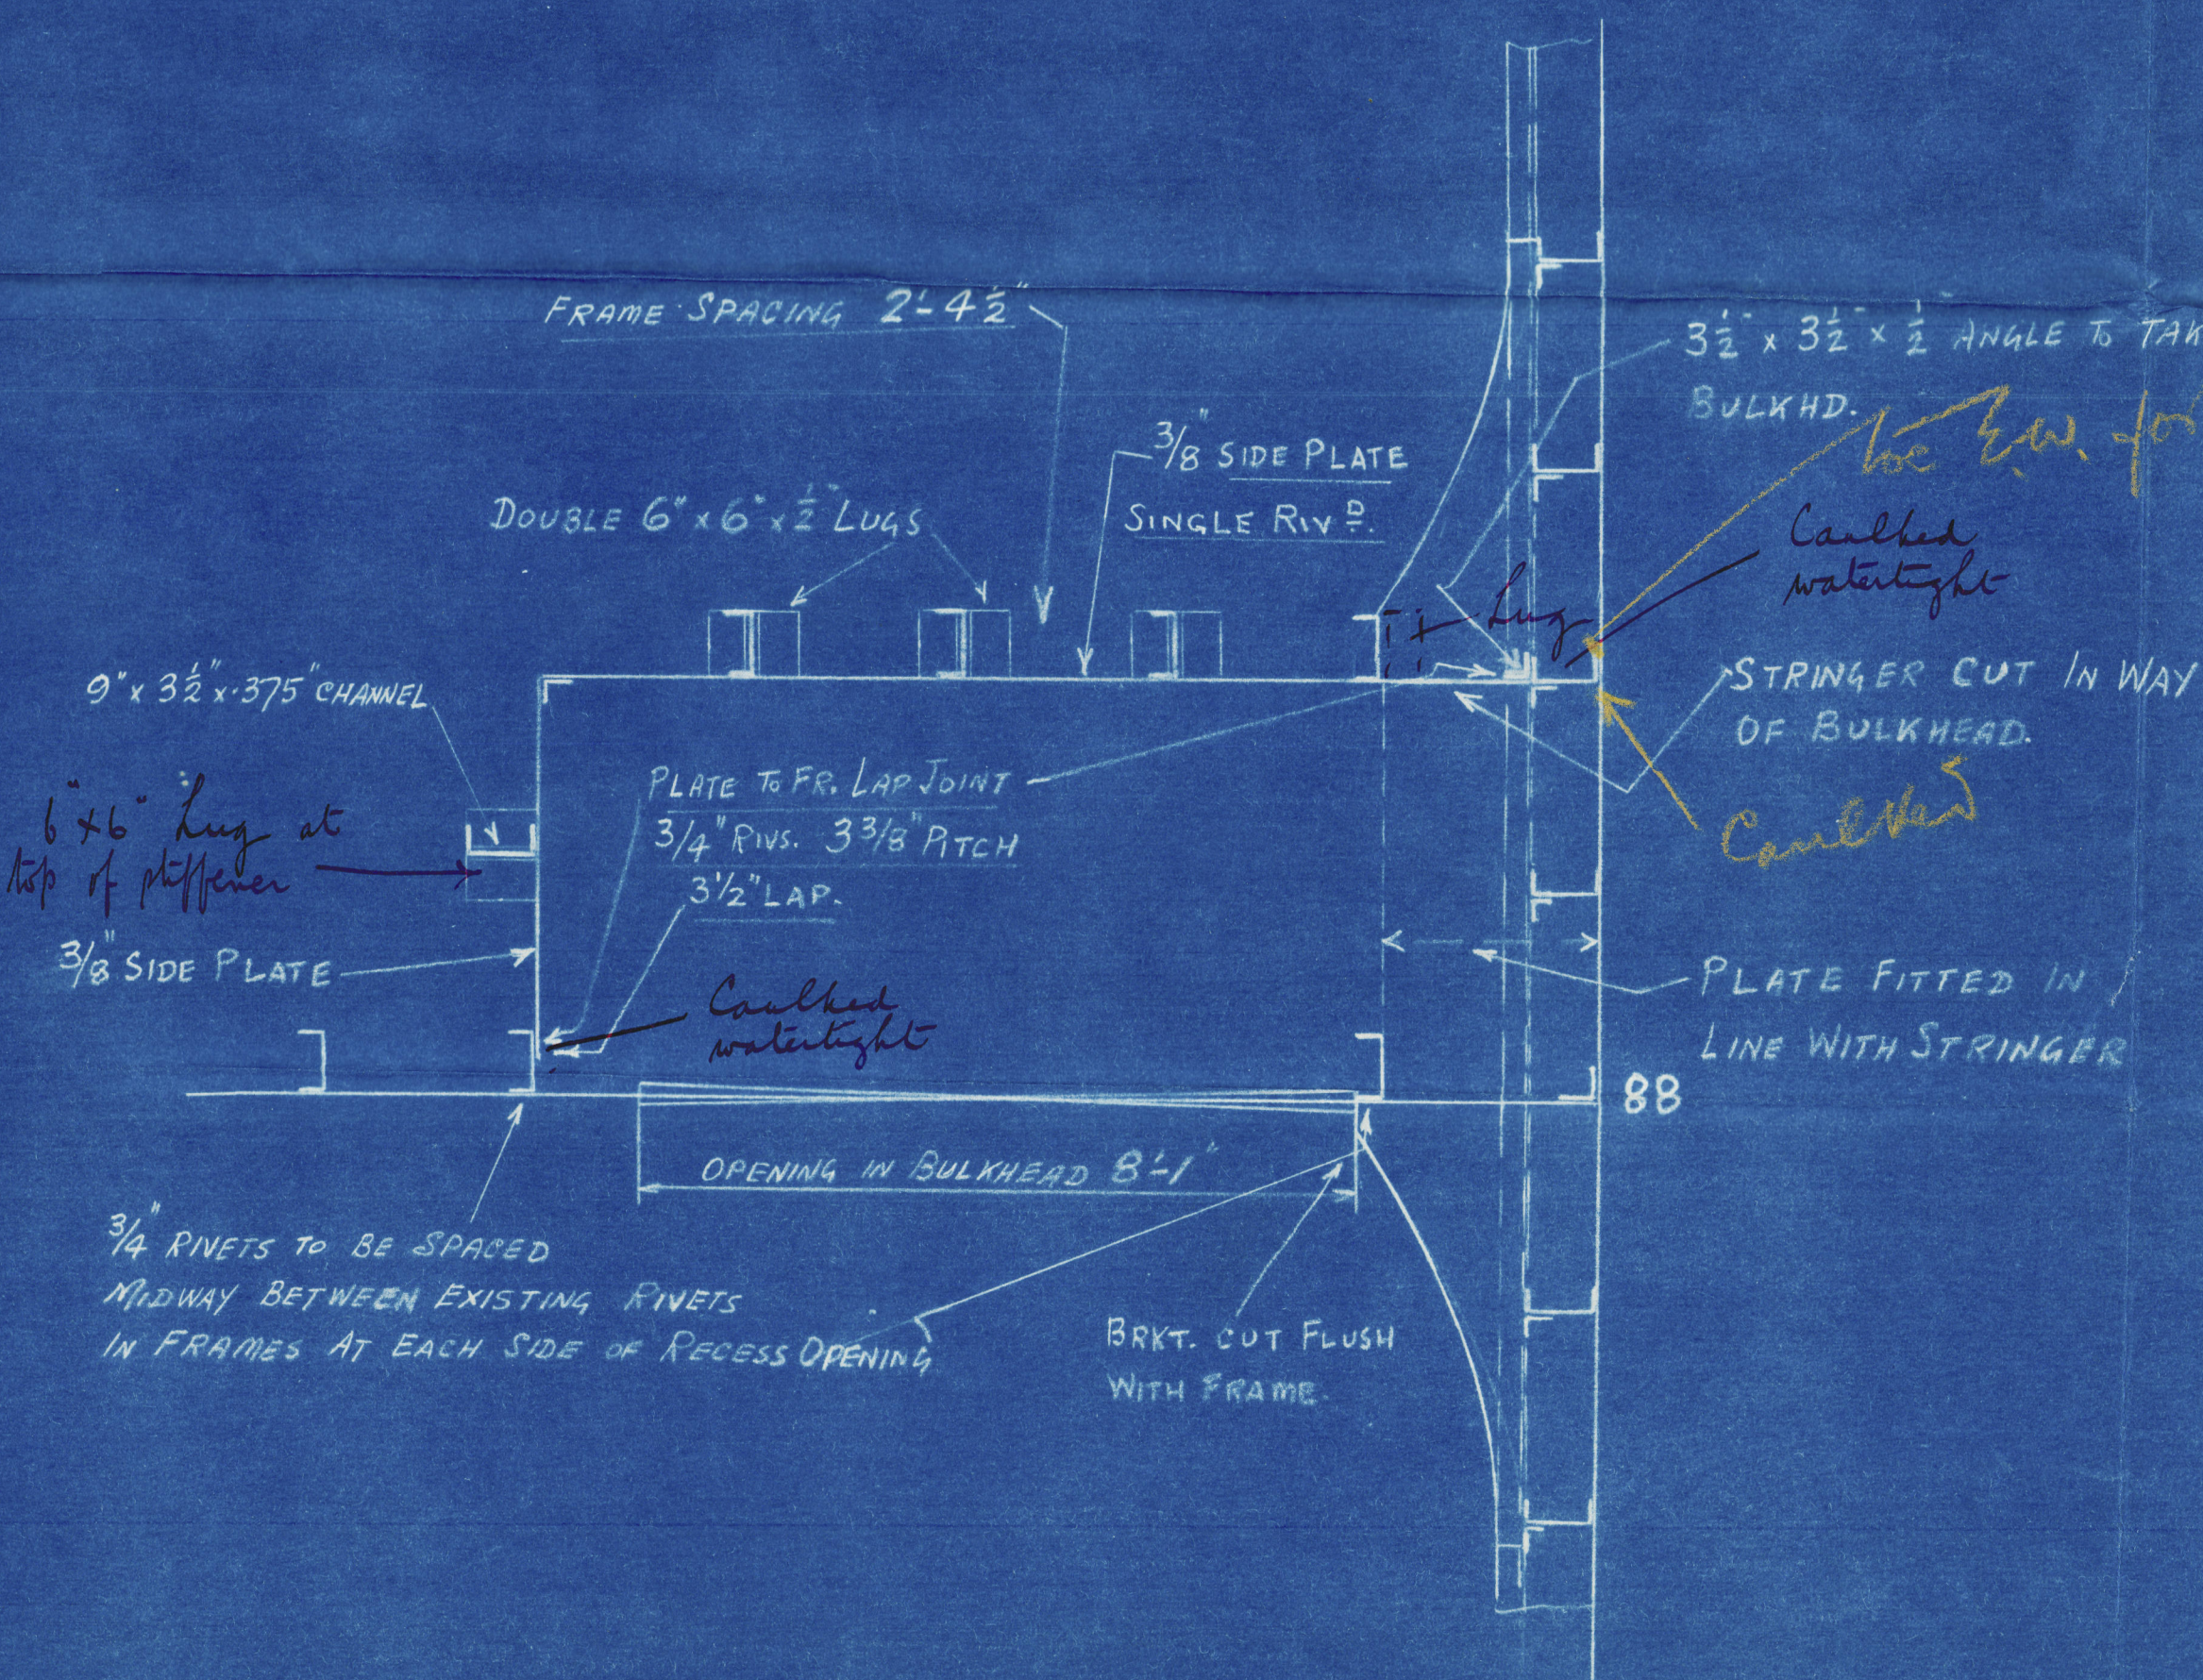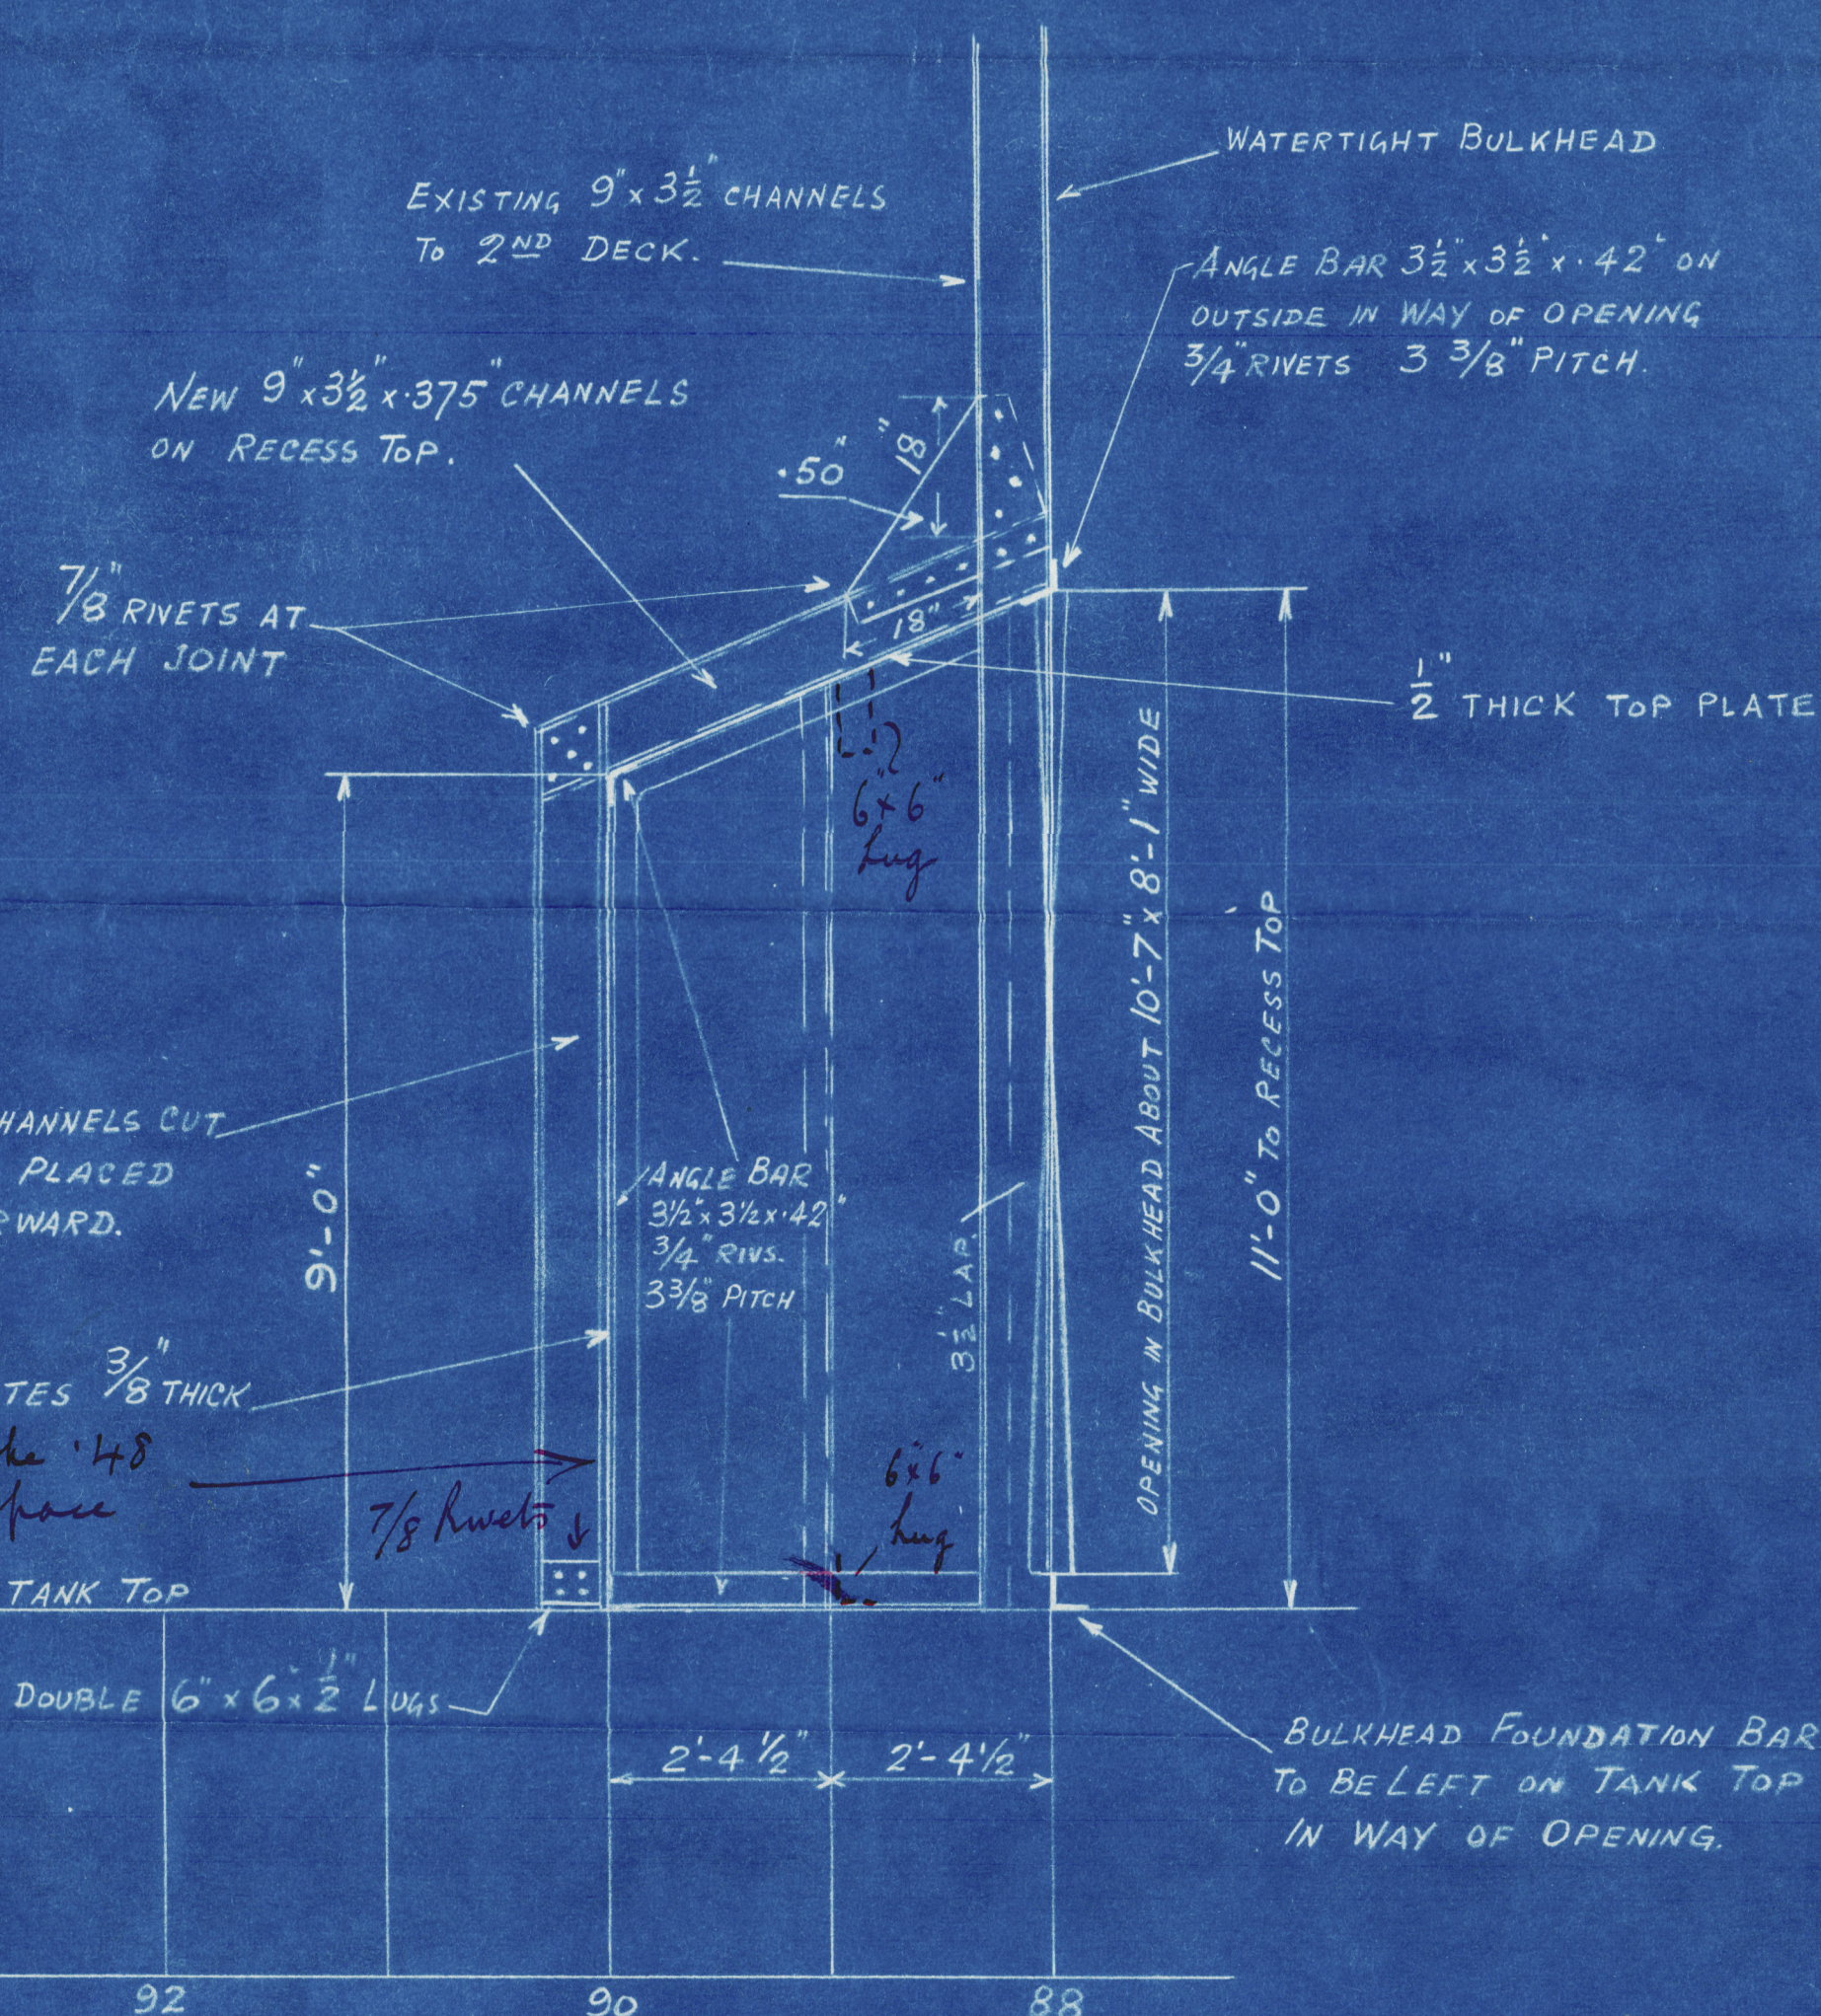

1- RECESS THUS ON STARBOARD SIDE
1- RECESS THUS ON PORT SIDE
TO BE THOROUGHLY WATERTIGHT

Approved
19/9/1933
RJS

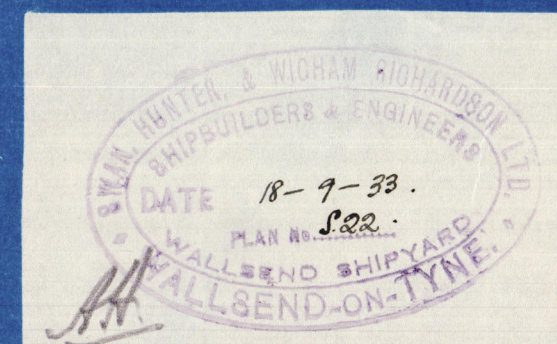

T. S. S. Tairoa

Alterations


Sept. 1933

T.S.S. "TAIROA".

NEWCASTLE ON TYNE.

Report No. 90740.

RETAIN

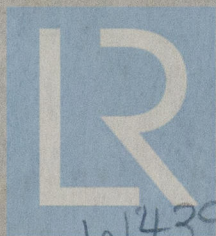

© 2020

Lloyd's Register
Foundation

W439 F0323