



DIMENSIONS:- 297' x 43.9" x 23'-6" D.M  
SCALE  $\frac{1}{8}$  = 1 FT

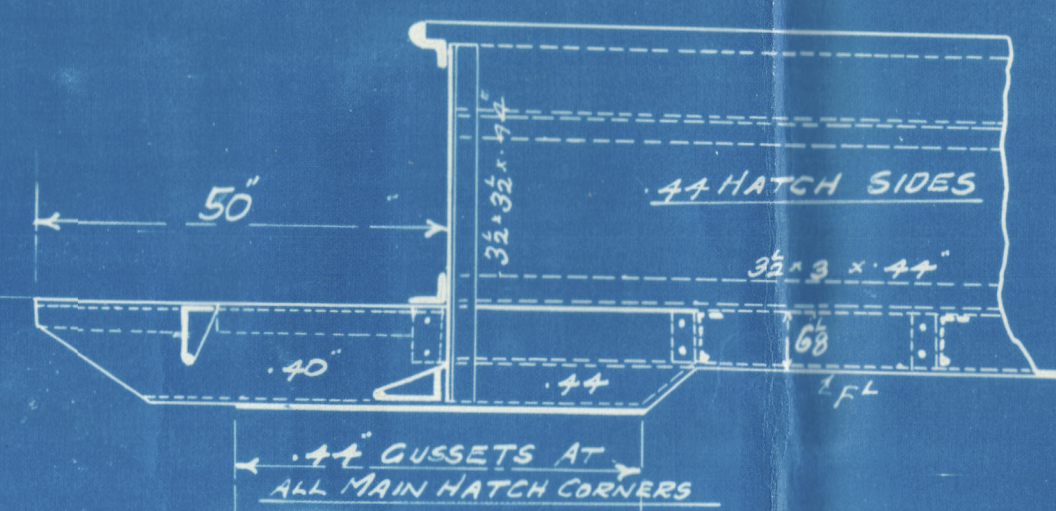



DETAIL OF HATCH SIDE GIRDERS 8C  
AT FR NOS 24, 31, 84, 93 + 105  
SCALE 1/2" = 1'-0"

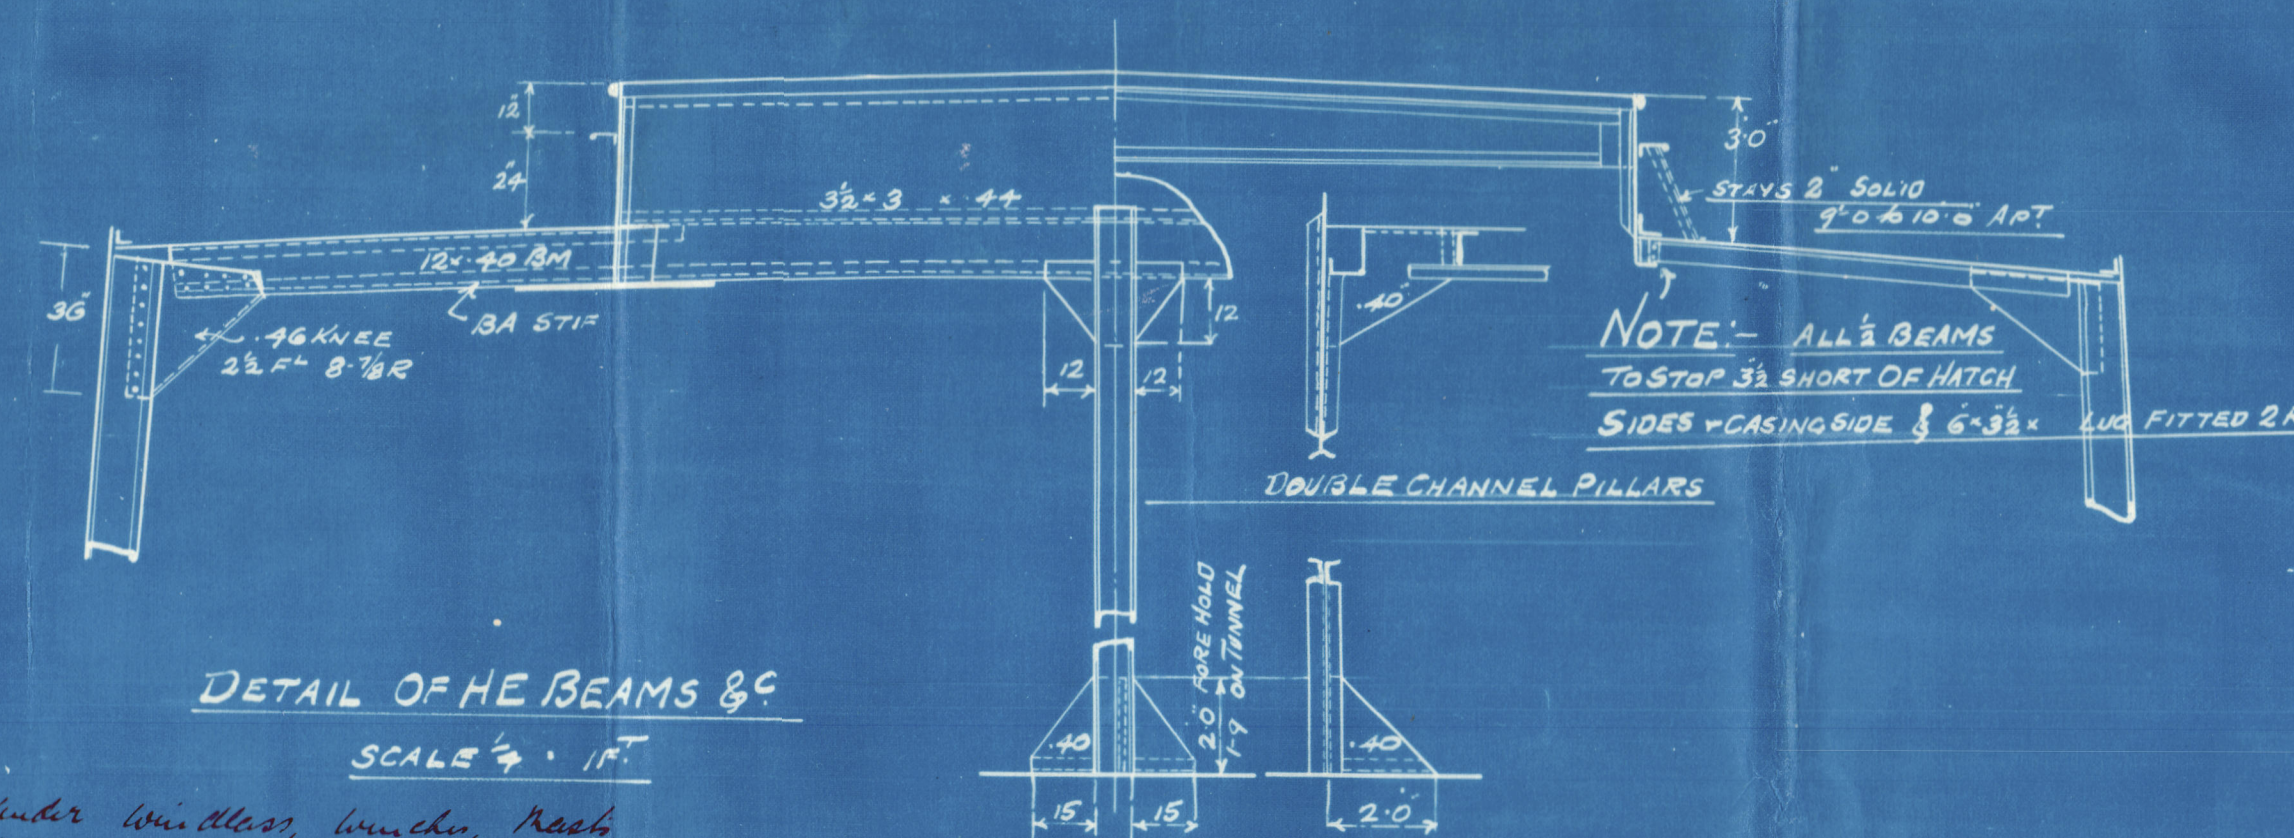

DETAIL OF HE BEAMS & C  
SCALE  $\frac{1}{4}$  IN.

Stiffening under windlass, lurches, heeds  
to the Surajors satisfaction.

ITEM	BH 10	BH 46	BH 62	BH 89	BH 111
PATING	30	26 - 31	26 - 31	26 - 32	26 - 33
COAMG.	F8 - 40	3Y	43	38	41
STIFF	10-32-1/2	9-3/4-32-1/2	9-3/4-32-1/2	10-3/8-32-1/2	10-3/8-32-1/2
SBRING	24	30	30	25	24
FRAMES	3-3-45	3-2-9-91	3-2-9-91	3-2-9-91	3-2-9-91
BEAM	3-3-36	3-1-36	3-2-36	3-2-36	3-2-36
T.T BAR	✓	3-2-3-49	3-2-3-49	3-2-3-49	✓
BRACKETS	25-36-25-1/2	23-3/4-25-1/2	23-3/4-25-1/2	25-3/8-25-1/2	20-1/2-25-1/2
RIVETS	7-3/4	6-3/4	6-3/4	7-3/4	5-3/4

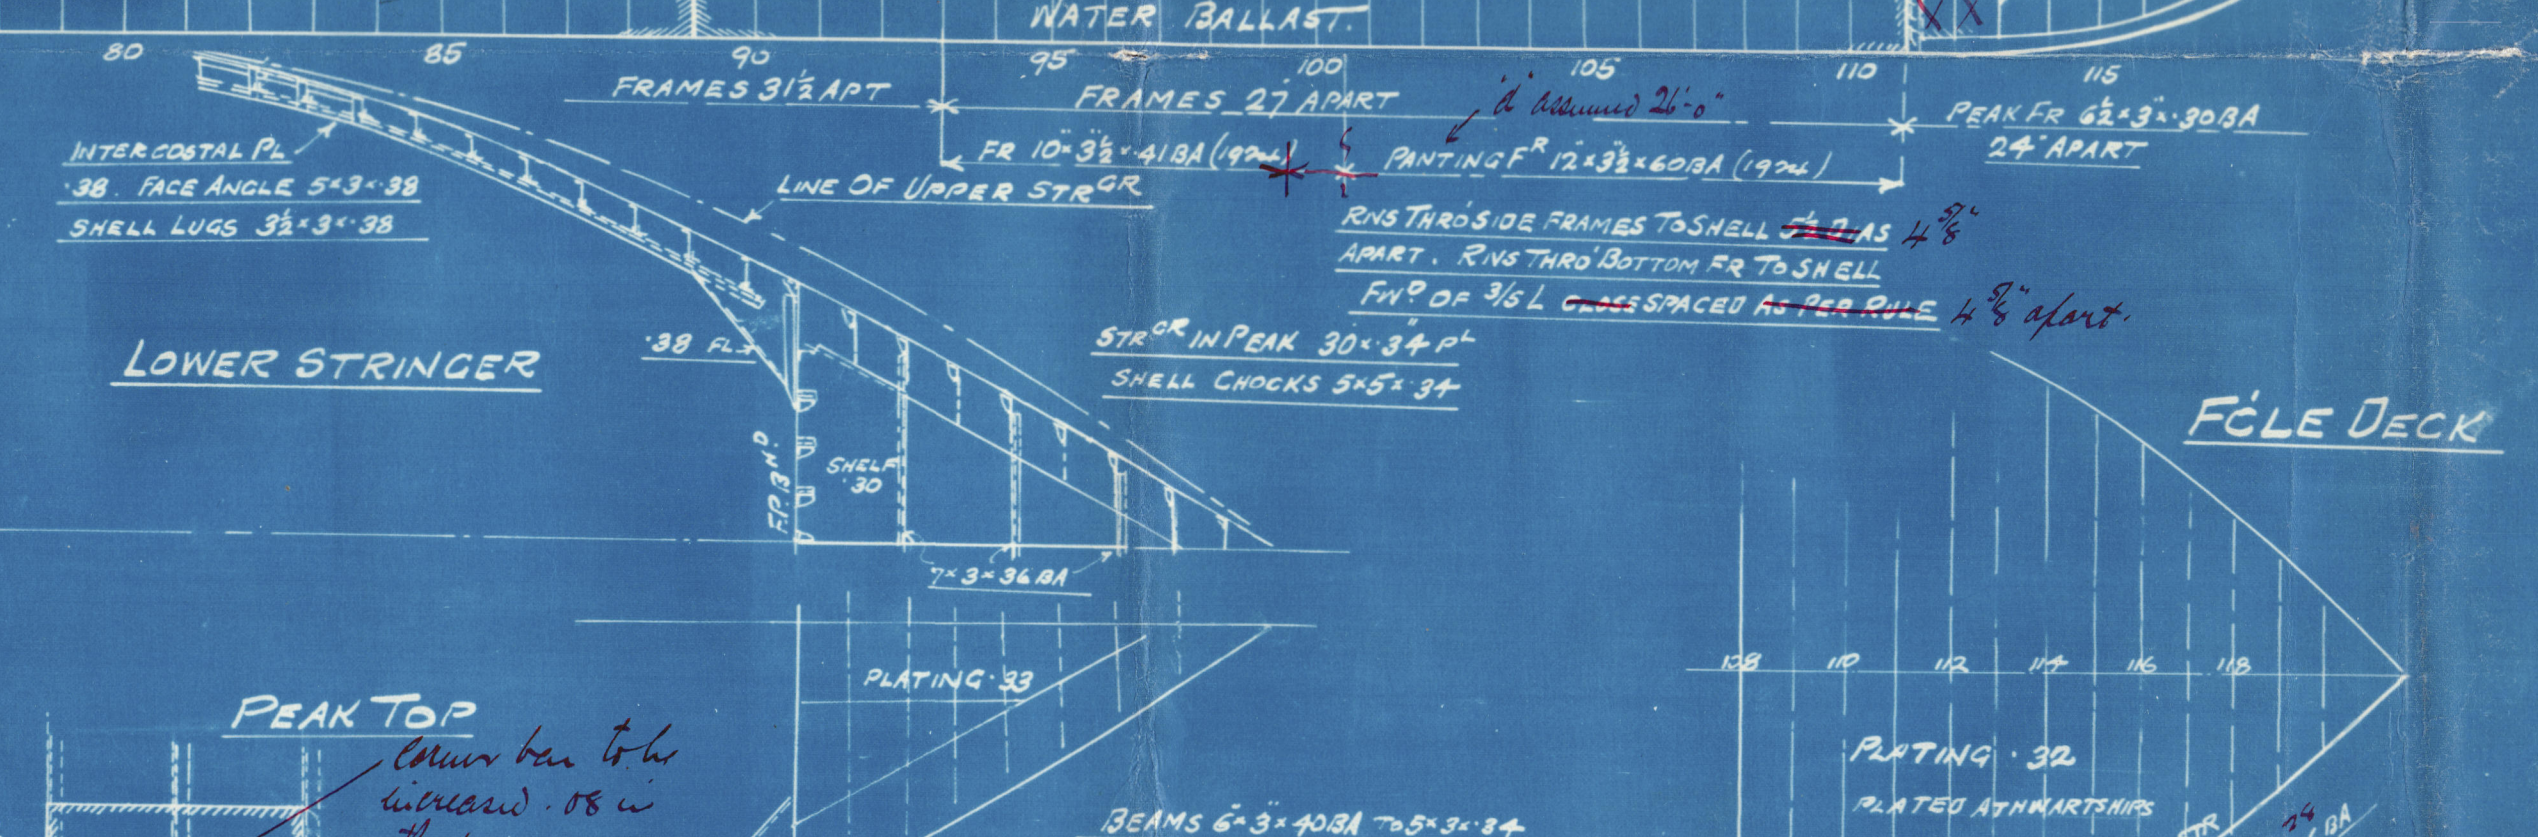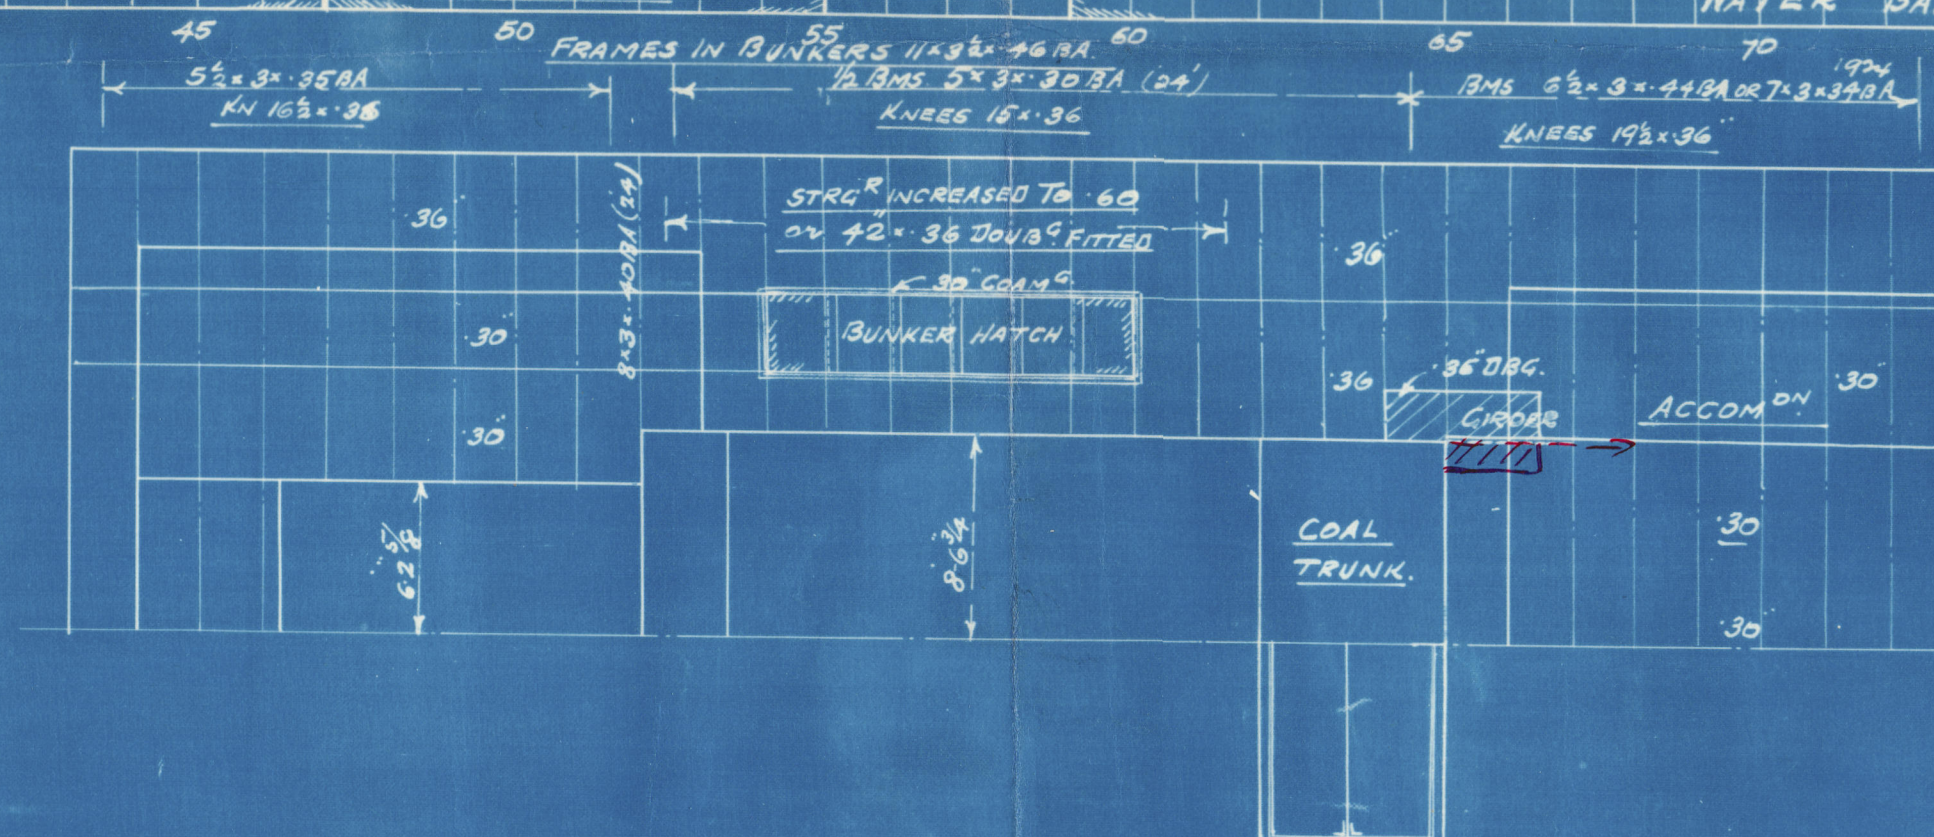

APPROVED  
LLOYDS REGISTER OF SHIPPING  
*Montgomery*  
DATE *25.11.20*



BURNTISLAND S.B. C<sup>o</sup>L<sup>a</sup>

SS N<sup>o</sup> 148

PROFILE + DECKS

*S. Viskmant*

WHS-0155

RECEIVED



© 2021

Lloyd's Register  
Foundation