


WRITTEN DIMENSIONS ONLY TO BE TAKEN.

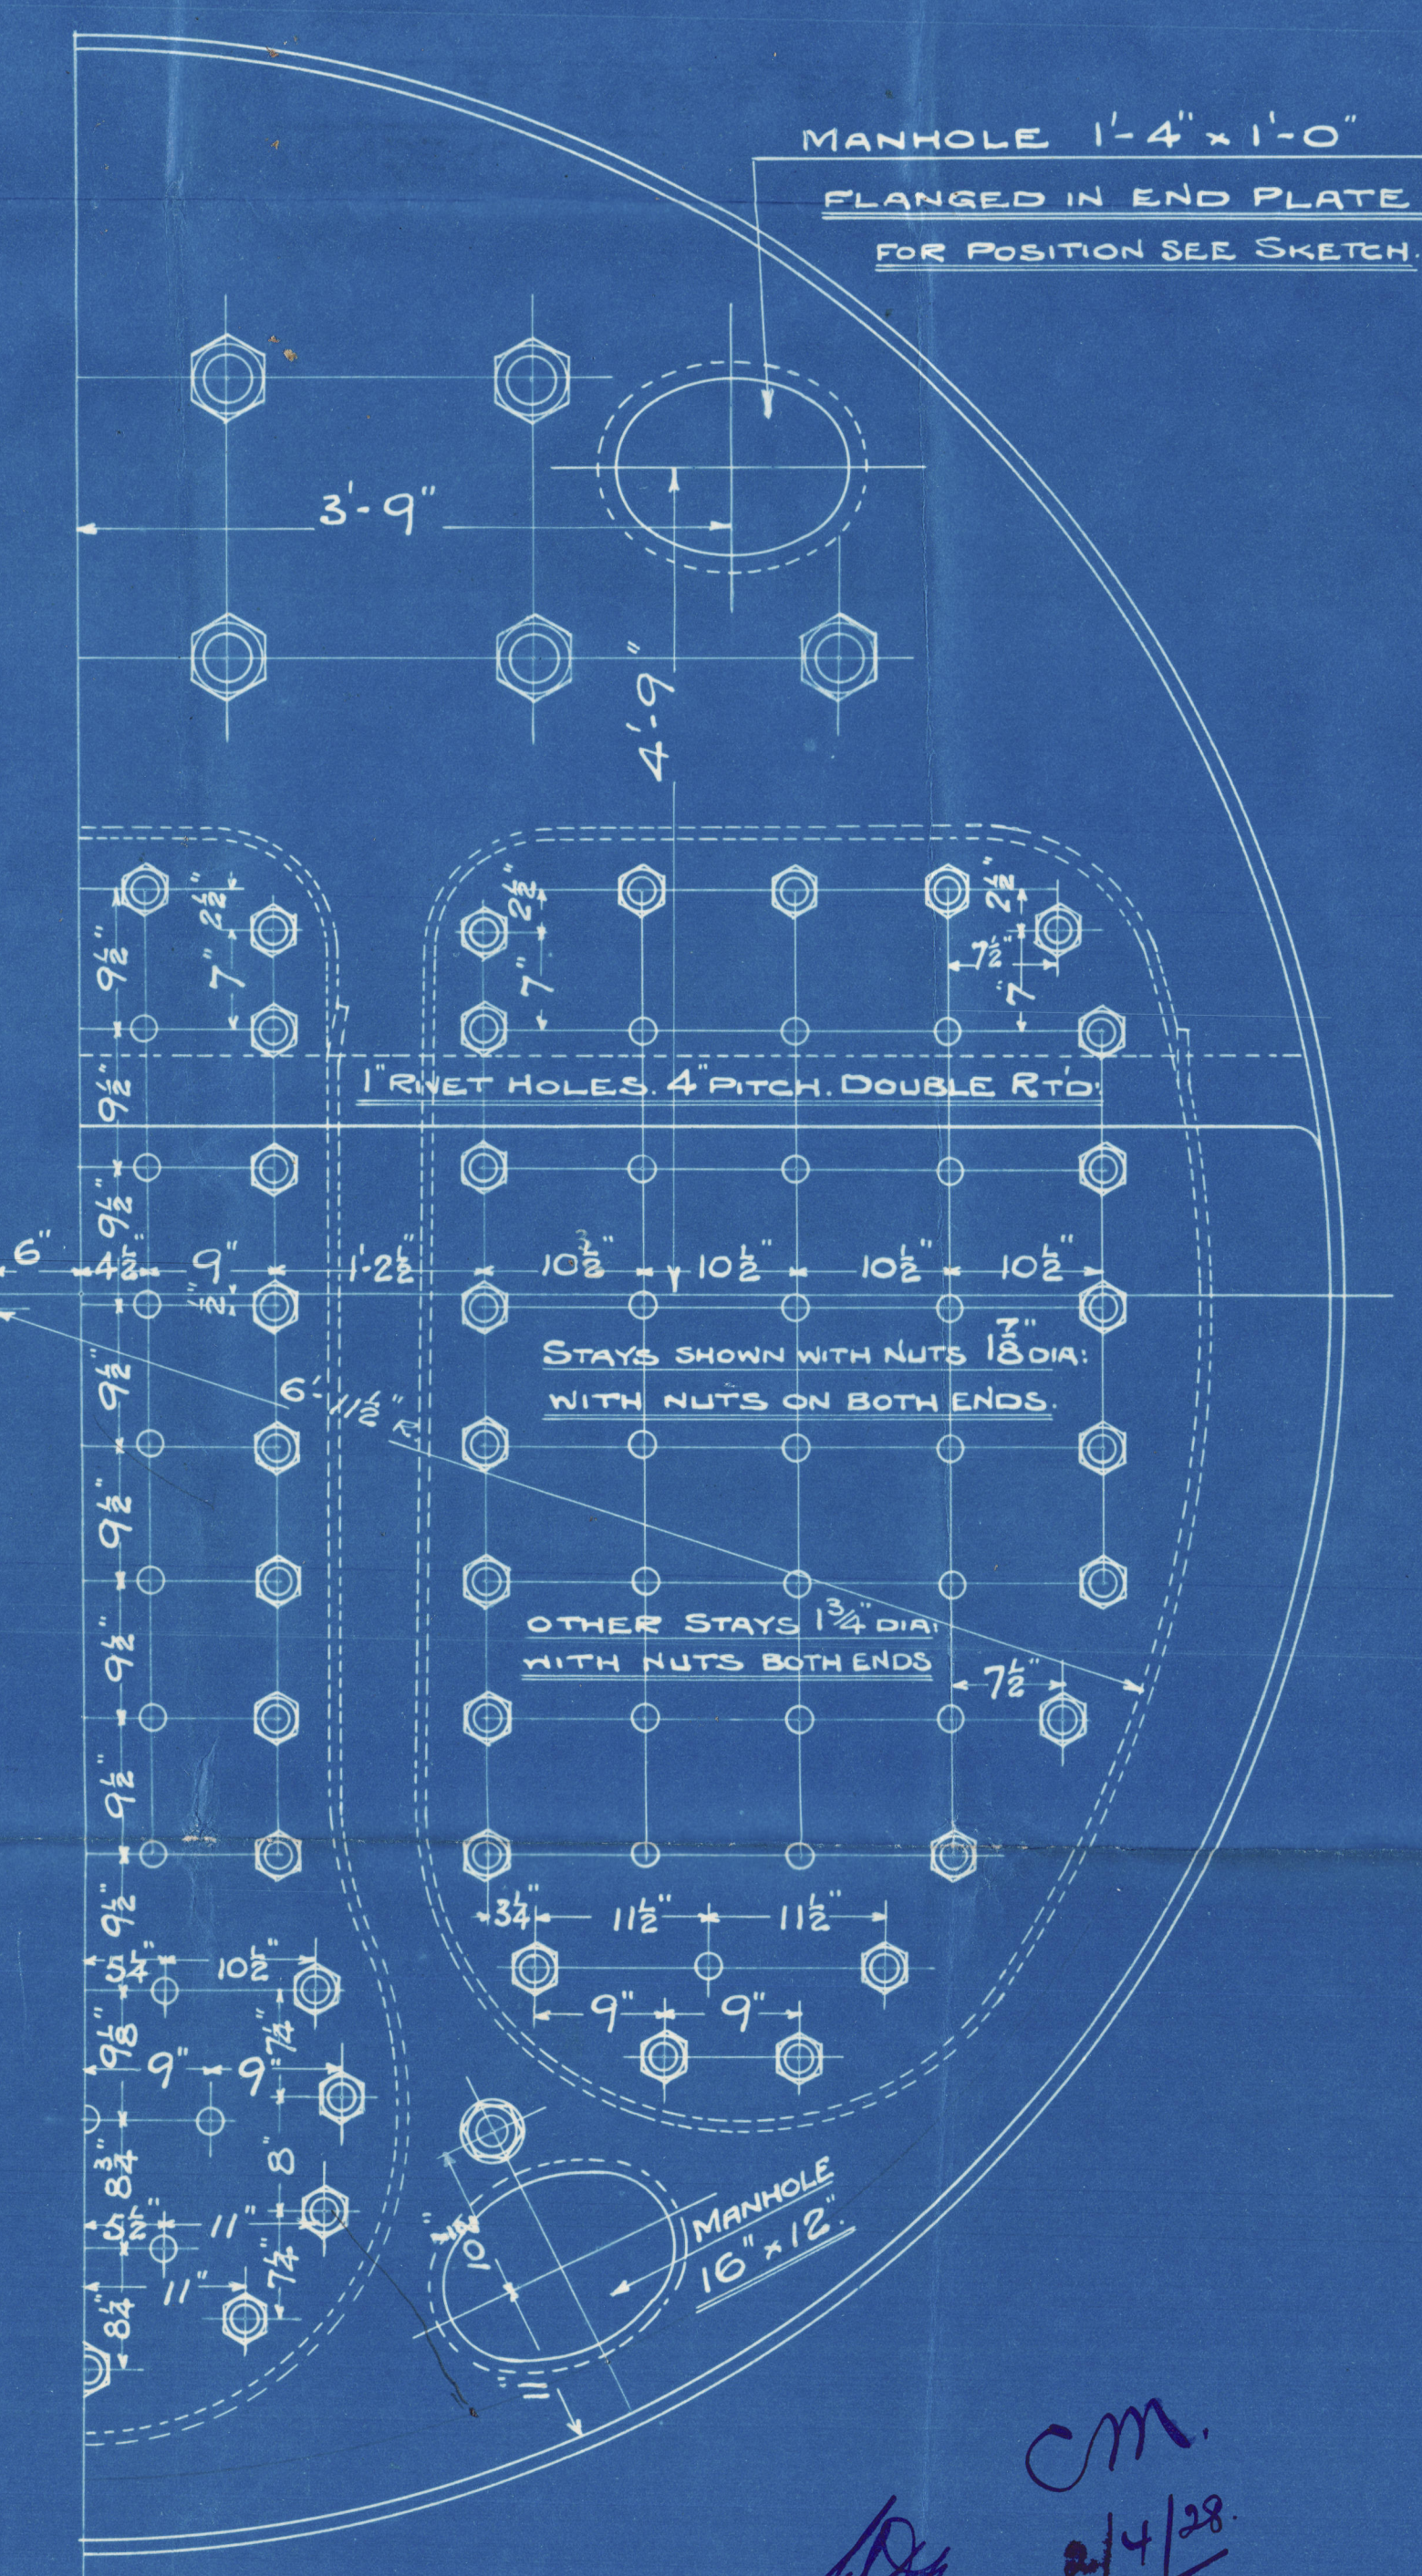

cm.
2/4/28.

SUNDERLAND.

MESSRS. THE N.E. MARINE ENG.
CO. LTD.

CON. NO. 2642

INTENDED FOR

MESSRS. SIR J. PRIESTMAN & CO'S.

S. S. No. 280

BOILER PLAN


s/s Llandale

SUNDERLAND RPT. NO.

29883

RETRACTED

No. 4009
LLOYD'S TEST
320 lbs.
W. P. 180 lbs.
A.T.G. 1-10-28.

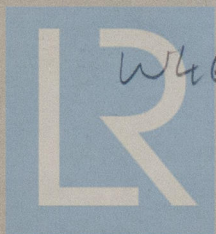

© 2020

W462-0159

Lloyd's Register
Foundation