

DIMENSIONS: 330' x 46' x 24' 6" TO UPPER DEK
TO CLASS 100. A.I. LLOYDS.

23265.0 LONGITUDINAL No:

d. ELSEWHERE 12. 11 1/2

W466-0030

(1)
Nos 238 & 239

Midship Section

Messrs Ramage & Ferguson
Leith

S/S. Chakdara

Leith 14555


S/S. Chakdina

Leith 14627

RETAKE

LR

Lloyd's Register
Foundation

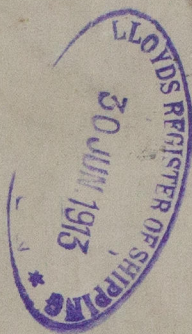

W466-0030



© 2020

Lloyd's Register
Foundation