

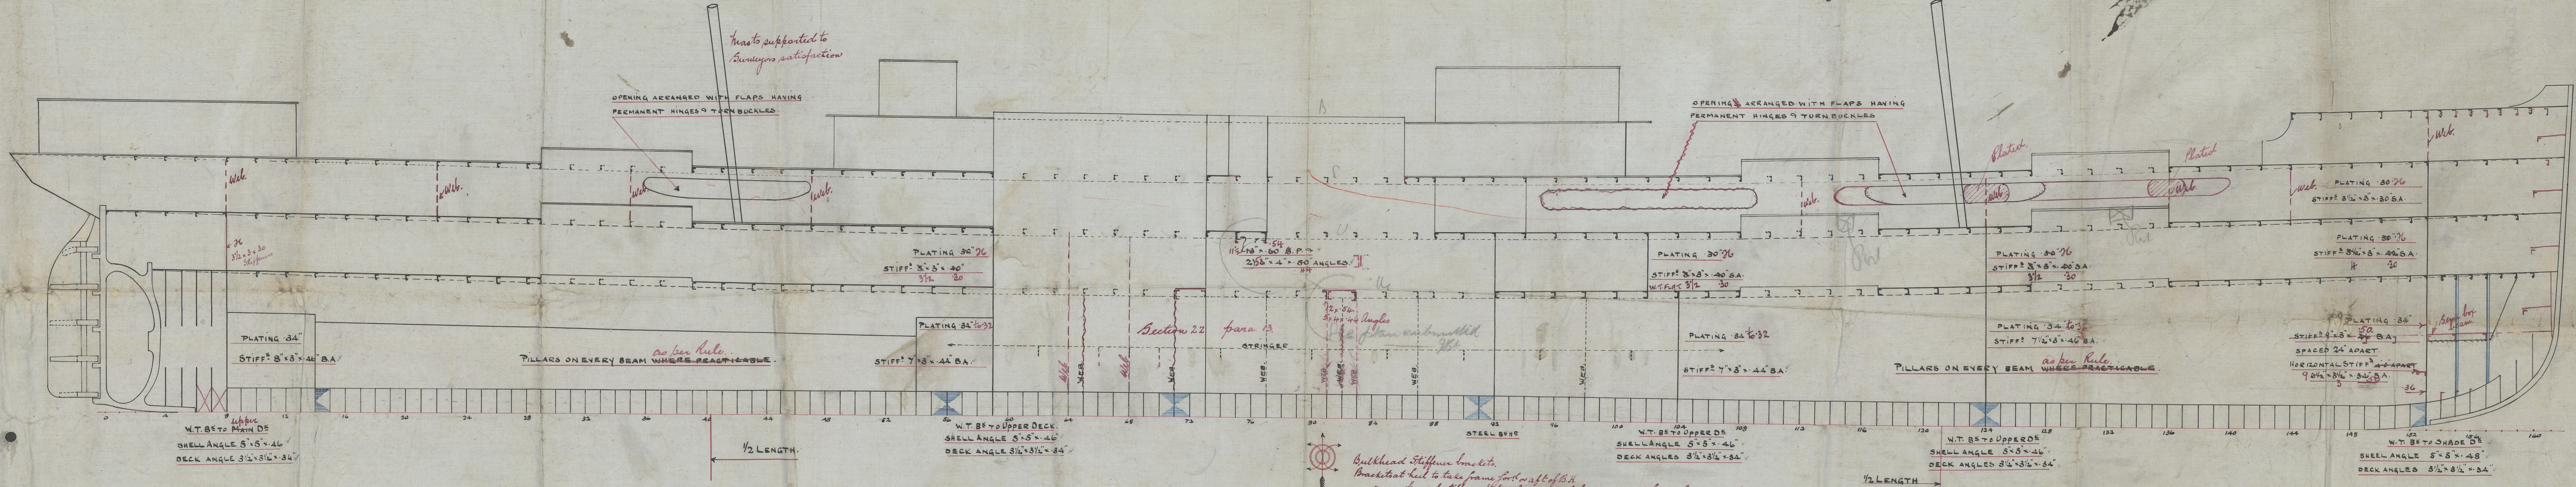
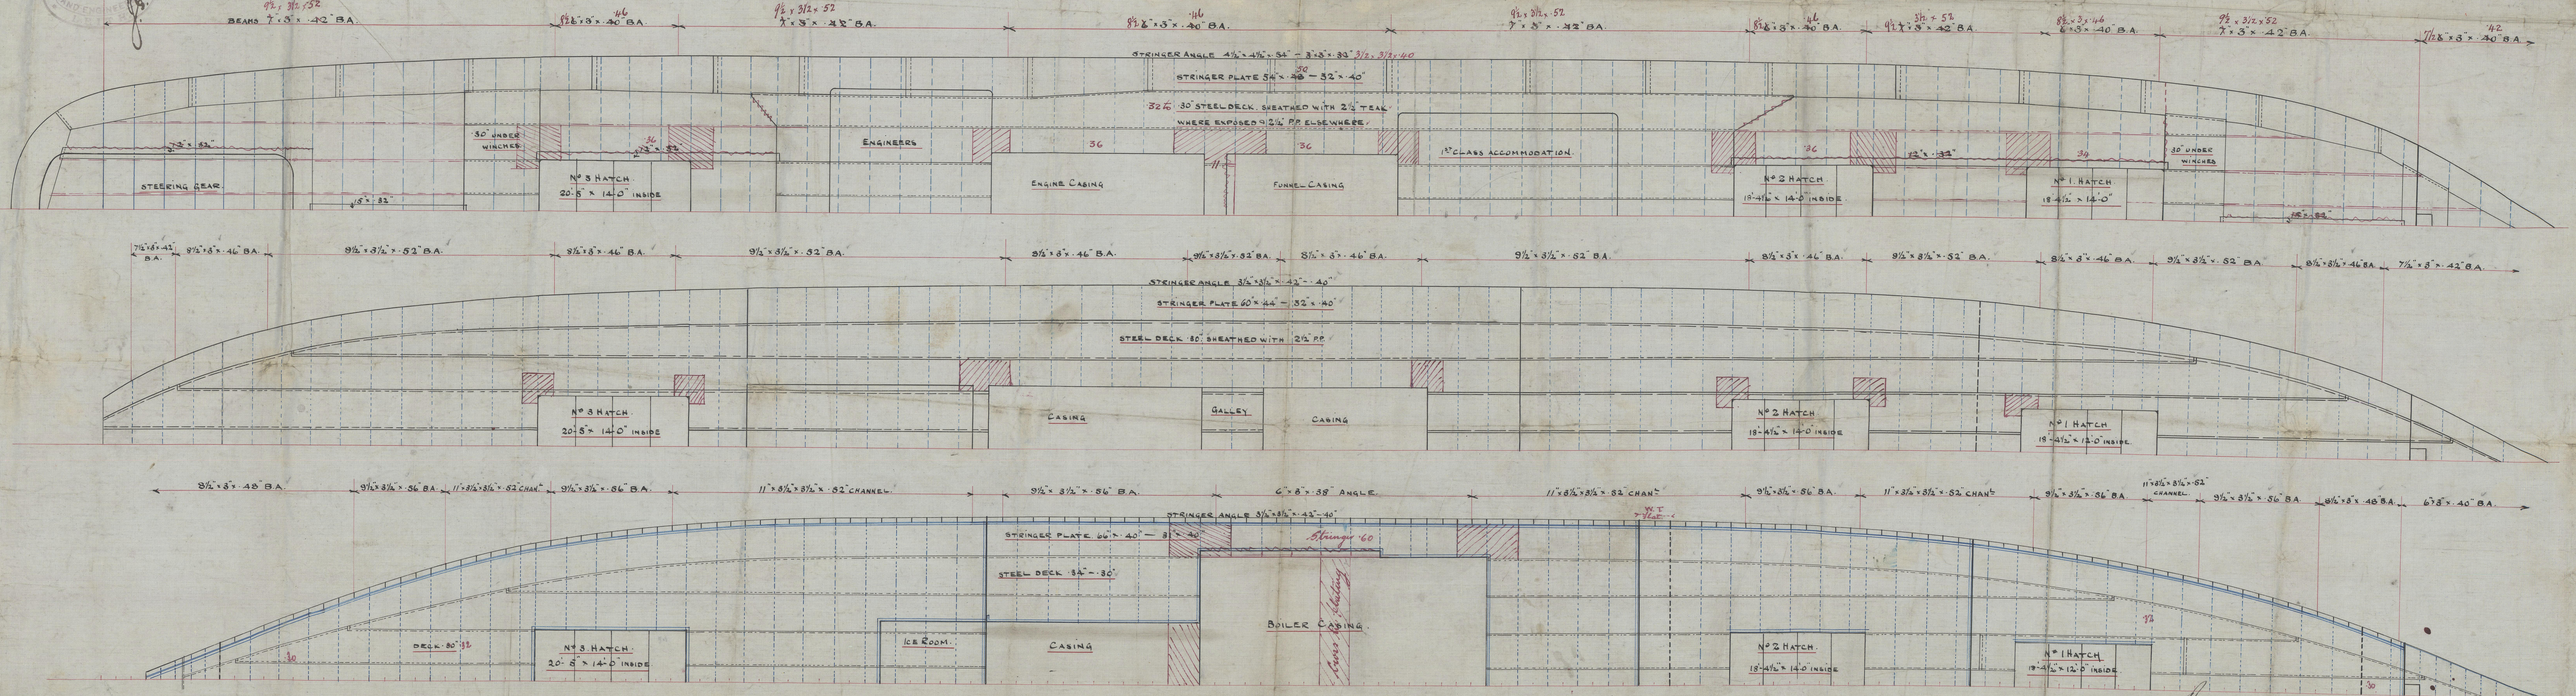
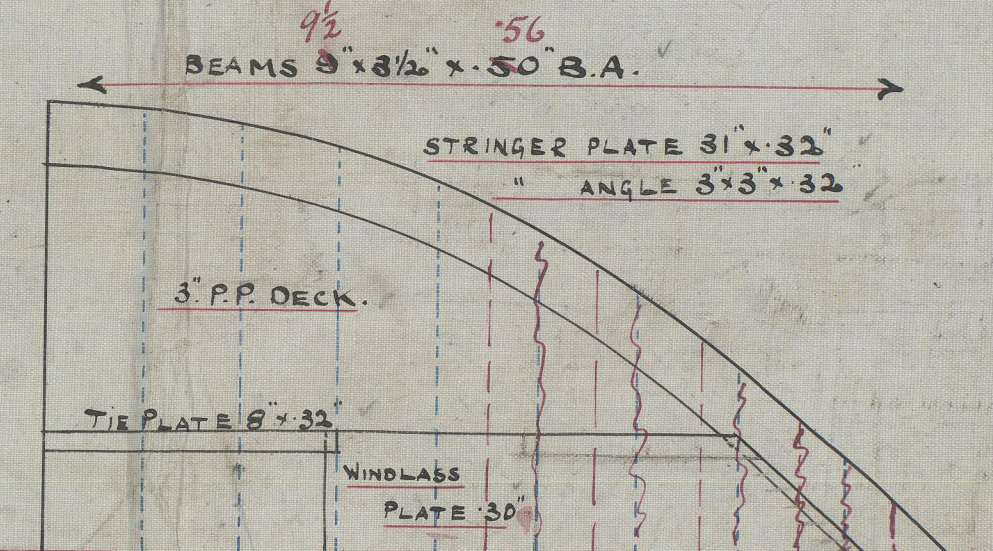
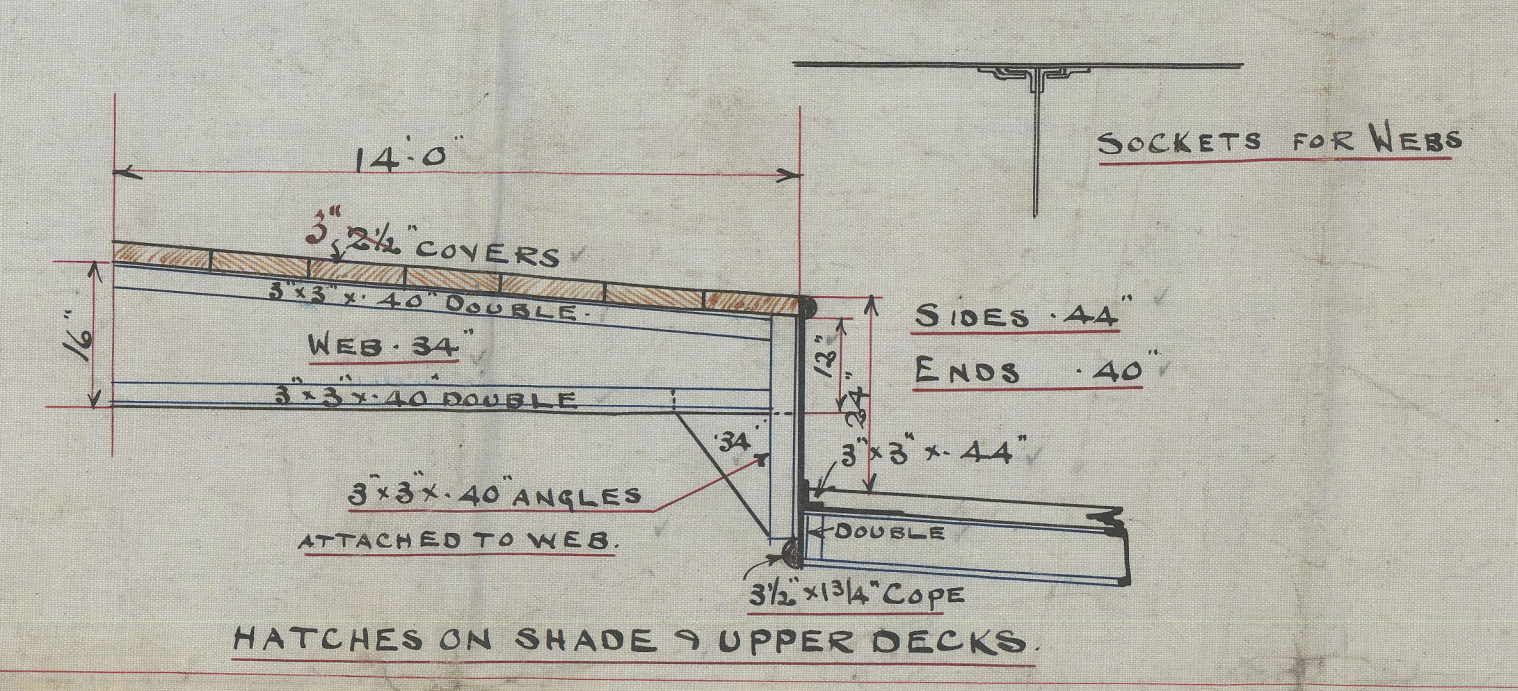


4.4.13  
2.4.13  
25.4.13  
6.5.13  
30.5.13  
6.6.13  
3.7.13  
11.9.13  
22.9.13  
11.10.13

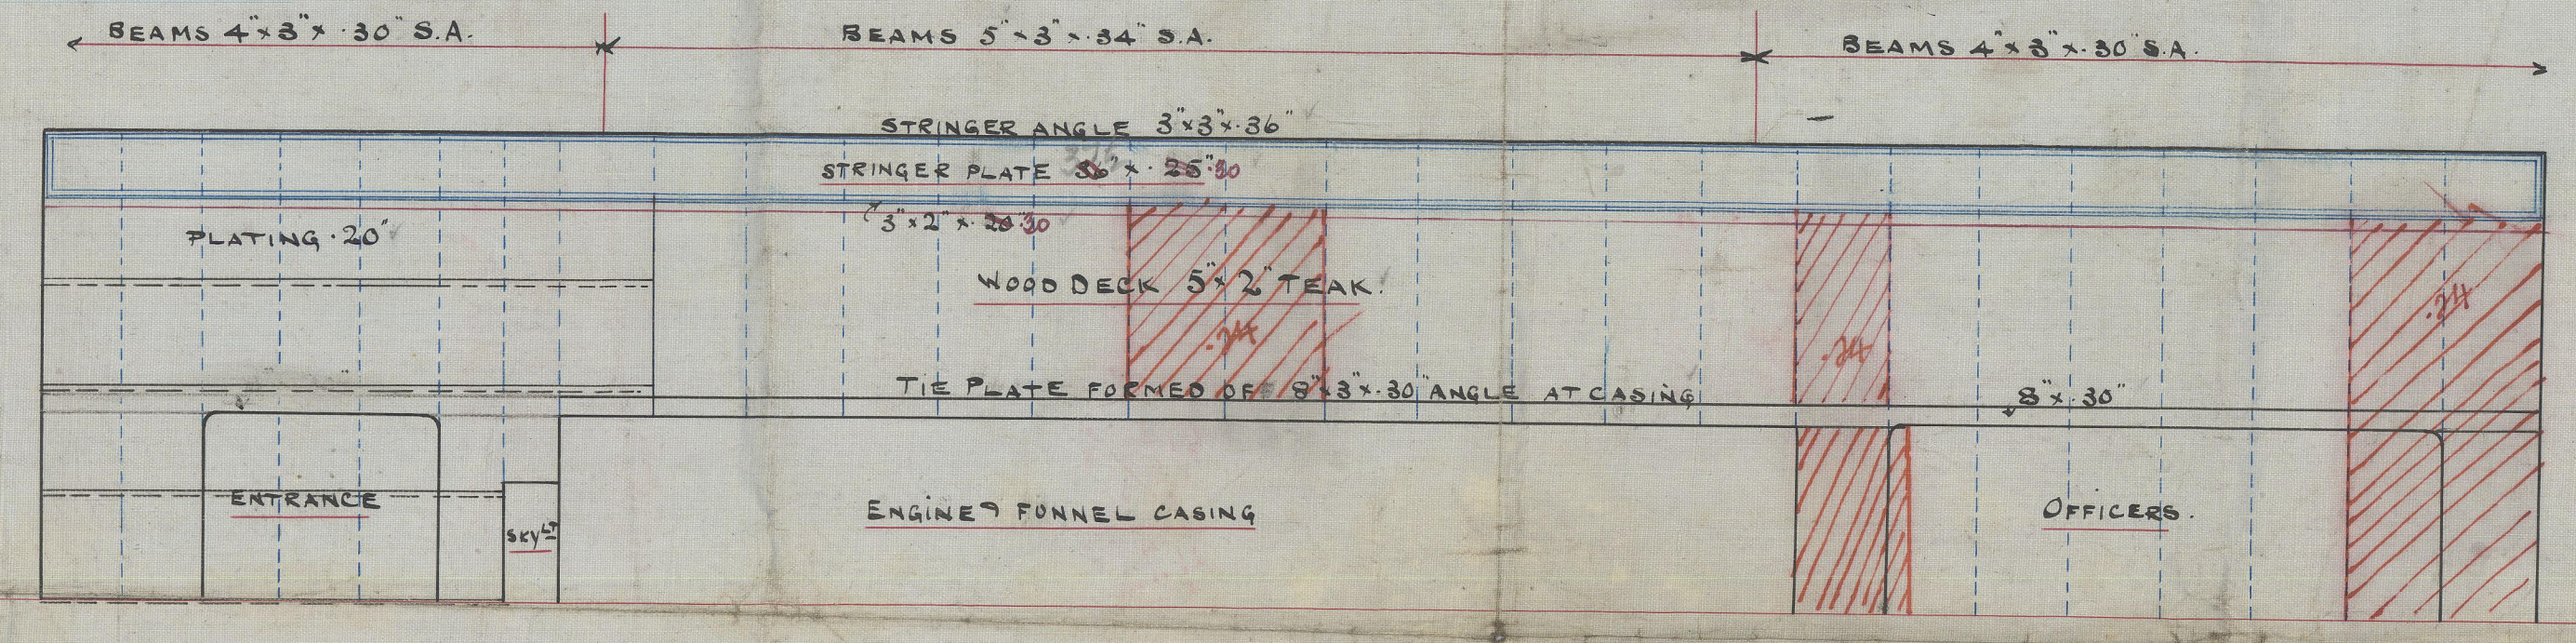

LLOYDS PROFILE.  
N<sup>o</sup> 2389.  
SCALE 1/8 FOOT.

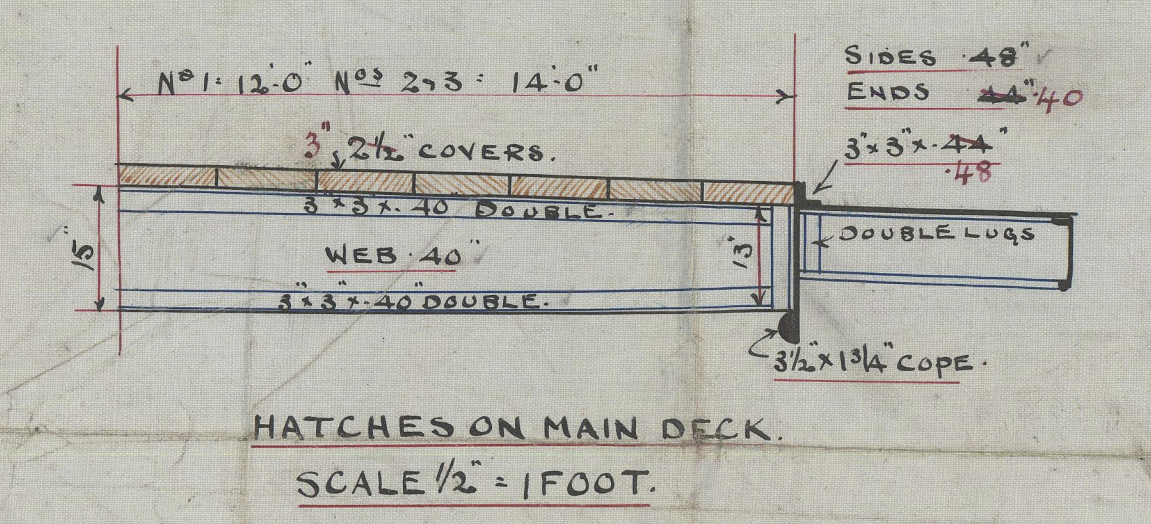

4.4.13

W466-0031





(2)  
S. S. Nos 238, 239

Profile Plan

Messrs Ramage & Ferguson  
L<sup>td</sup> Leith

W466-0031

 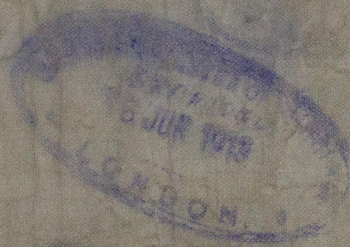

© 2020

Lloyd's Register  
Foundation