

NORTHUMBERLAND ENGINE WORKS  
TRACING NO 600 SCHEDULE L  
STEAM BOILER

g. w. A.  
7/7/16

$$\underline{\text{LLOYDS}} : \frac{23.37 \times (19.5 - 2) \times 85.6}{182.5625} = \underline{181.5 \text{ LBS.}}$$

MANHOLE COMPENSATING PLATE  $\times 2'-11\frac{3}{4}" \times 2'-7\frac{3}{4}" \times 1\frac{3}{8}"$

... LIMITED, WALLSEND.

N. E. M. E. Co., Limited,  
ENCLOSURE  
FOR  
Hoyden  
Messrs. ....

Messr

6120-79-1119

SURVEY TO "LLOYD'S" & OWNERS APPROVAL

TOTAL 2550 SQ. FT. PER BOILER.


STRIP OF  $1\frac{1}{2}$ " ANGLE BAR RIVETED ON  
BOTTOM EDGE OF MANHOLE DOORS.

NOTE: ALL SCREW STAYS SCREWED INTO PLATE & FITTED WITH NUTS

## CONTRACTS 2274-2275



N. E. Maine Eng Co 2274/  
Main Boilers 180 lbs.

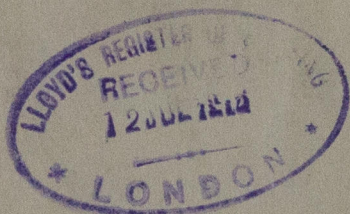

2274 S. S. "Burnhope"

---

S.S. "BURNHOPE"

NEWCASTLE ON TYNE.

Report No. 70118.

---

W467-0249

RETAIN



© 2020

Lloyd's Register  
Foundation