

No. 1470. S.S. MAYFIELD.

MIDSHIP SECTION.

LENGTH B.P. 175'-0". BREADTH MLD. 28'-0". DEPTH MLD. 13'-6".

SCALE: 1/2" = 1 FOOT.

CLASS 100 A.I. LLOYDS REGISTER.

EQUIPMENT NUMERAL.

LONGITUDINAL NO. = 7222.50  
QUARTER DK. 95.81 x 4.0 = 383.24  
BRIDGE 11.0 x 7.5 x 3/4 = 61.87  
FORECASTLE 31.0 x 7.0 x 3/4 = 162.75  
CASING 44.0 x 7.0 x 1/2 = 154.00  
EQUIPMENT NO. = 8024.36

2 BOWER ANCHORS STOCKLESS 14 1/2 CWTs EACH } COLLECTIVE WT.  
1 " " " 12 3/4 " } 41 3/4 CWTs

1 STEAM ANCHOR 4 1/4 CWTs EX-STOCK.


1 KEDGE " 2

195 Fms 1 1/2" STUD CHAIN CABLE.


60 " 1 1/2" STREAM CHAIN OR 5" STEEL WIRE.

75 " TOWLINE 3 1/2" HEMP OR 2 1/2" "


80 " HAWSER 6" " 2 1/2" "

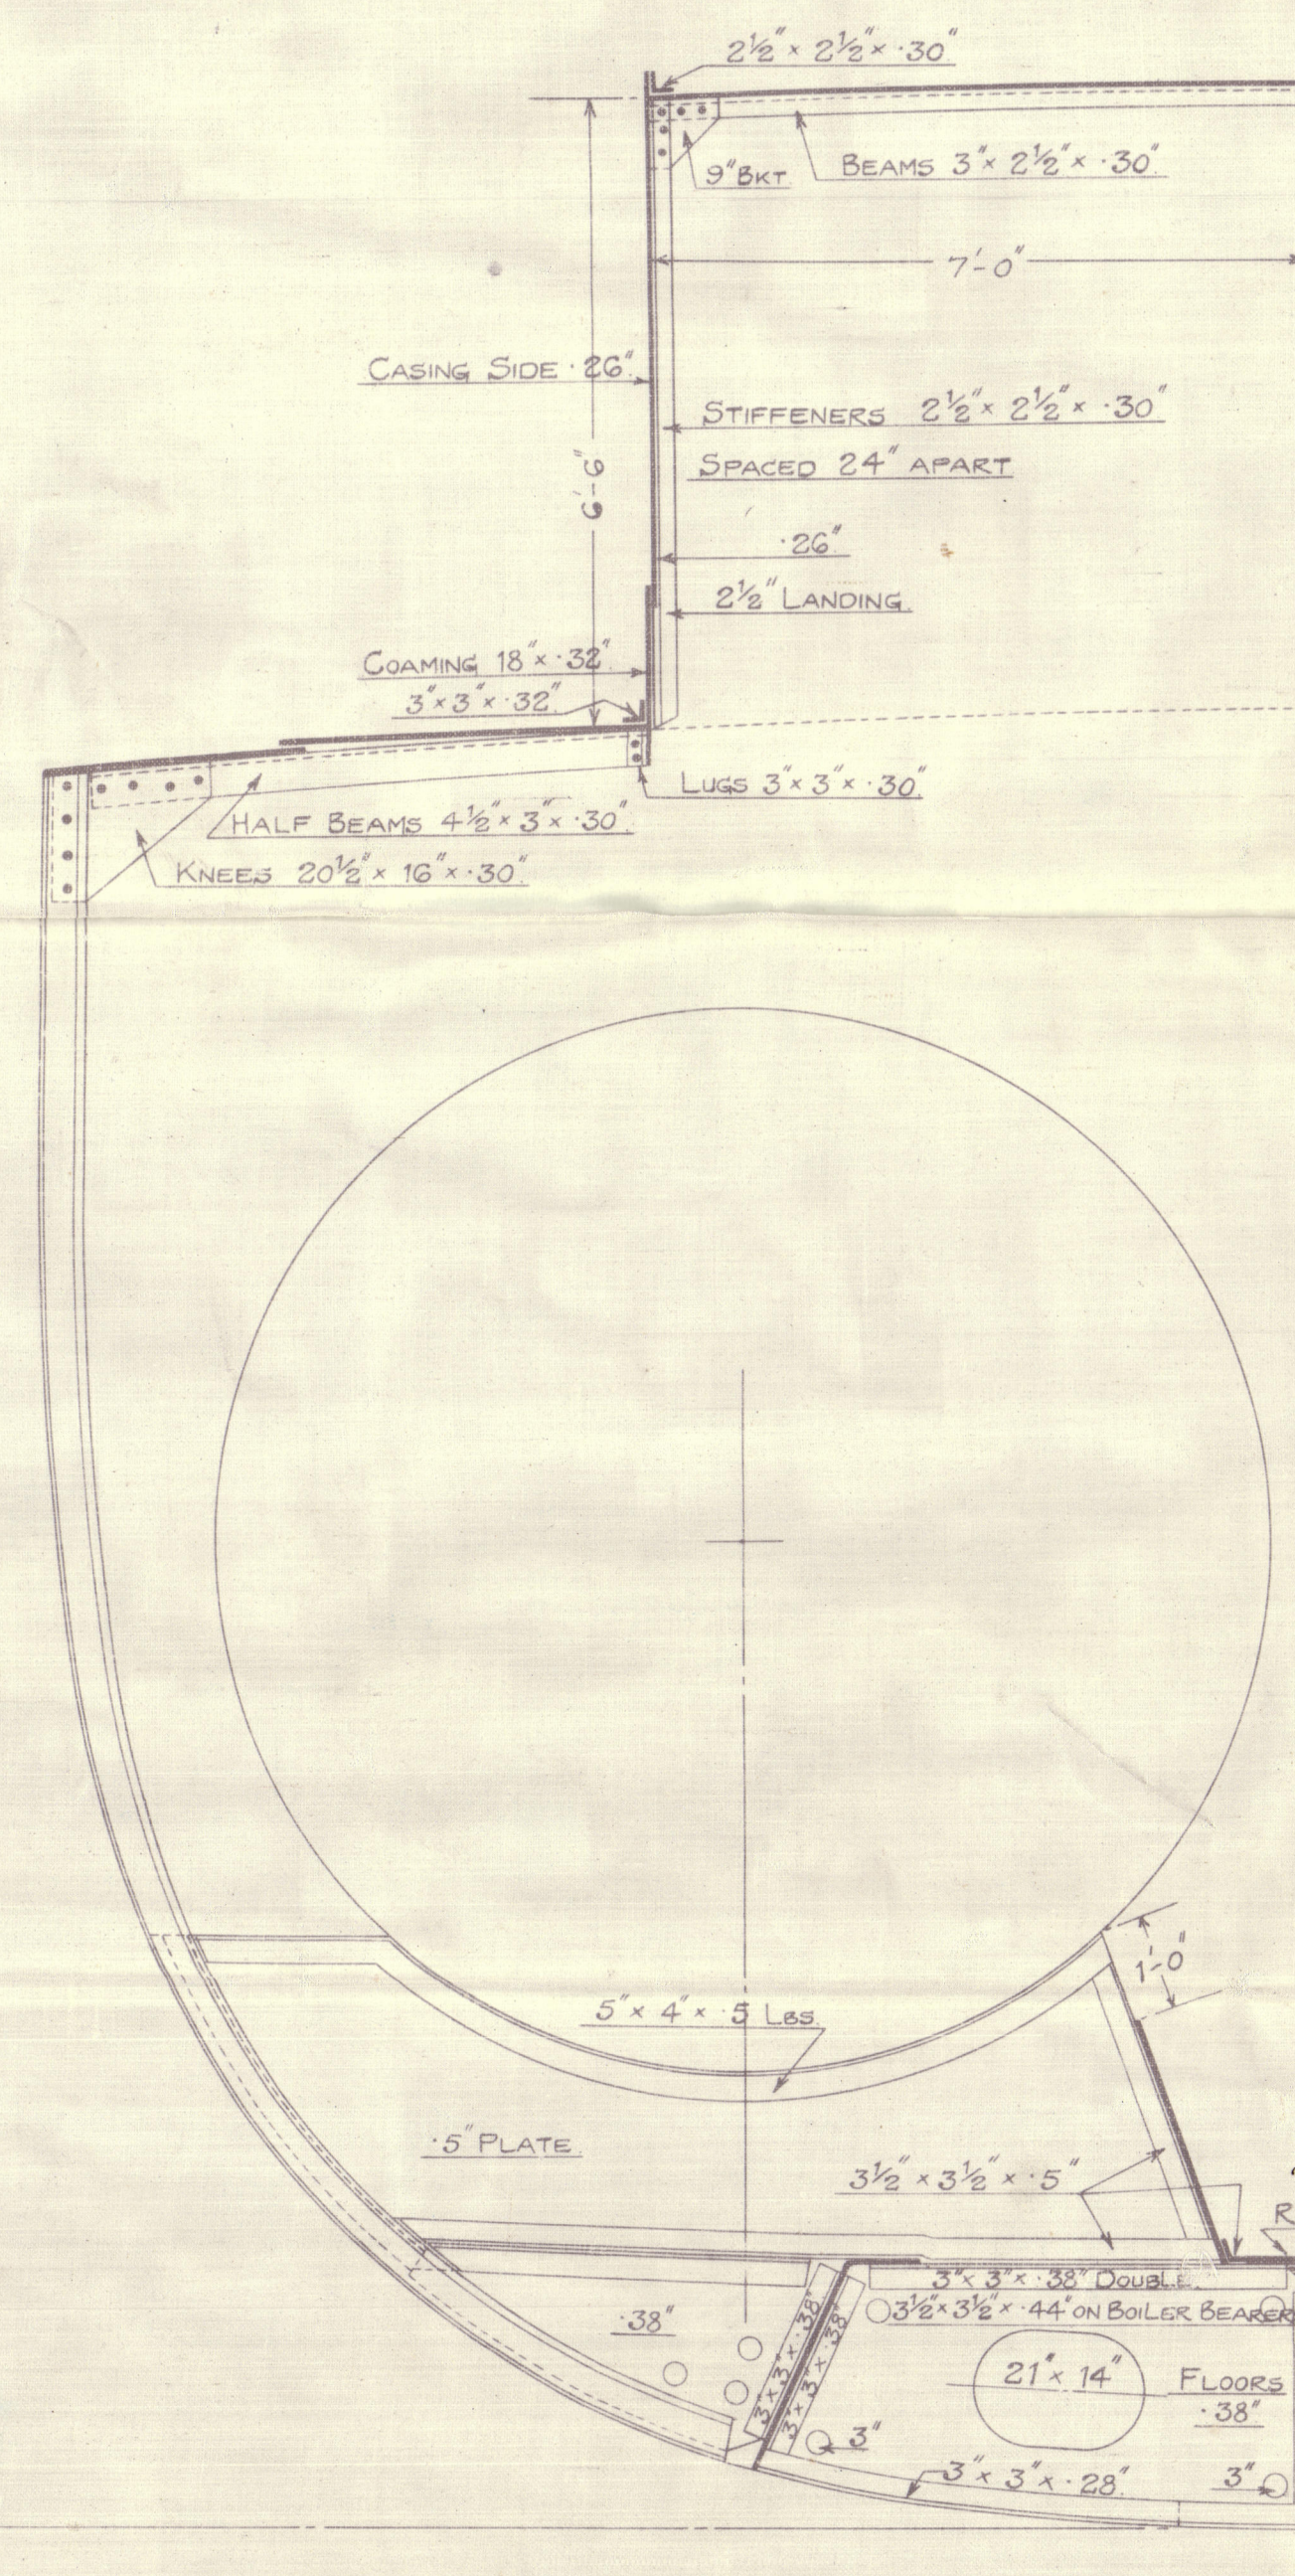


SECTION IN WAY OF BOILER ROOM.

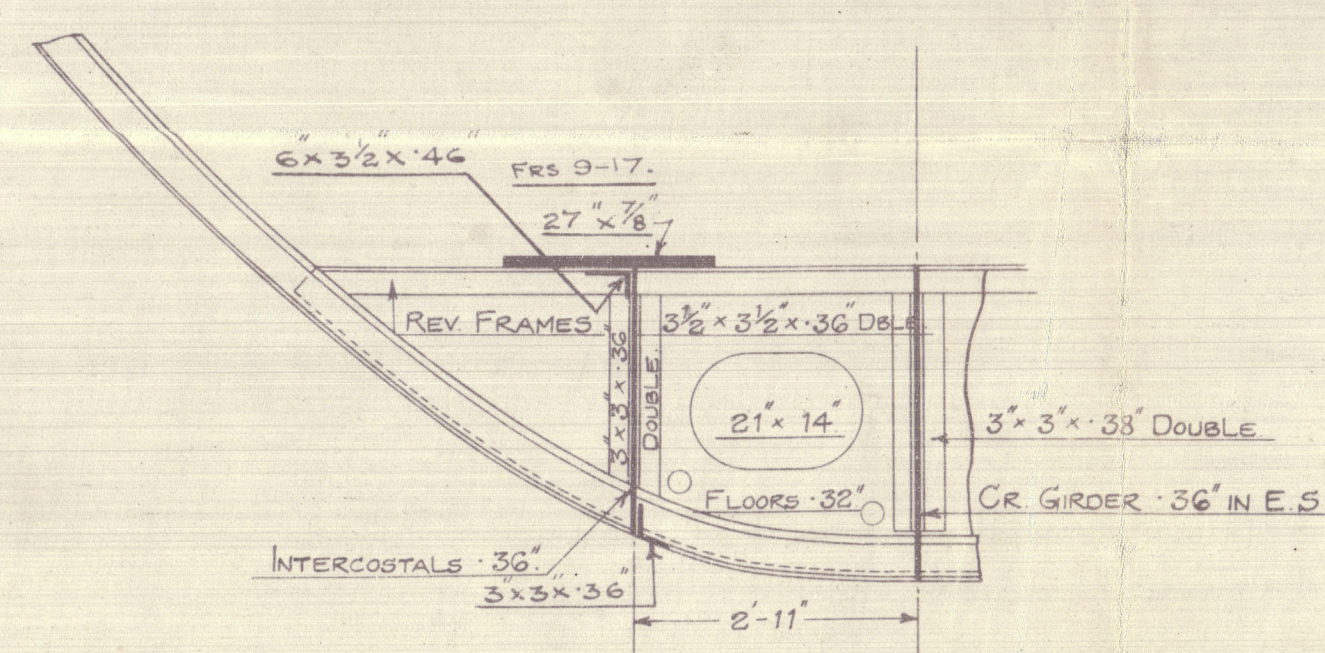

SECTION IN WAY OF ENGINE ROOM.

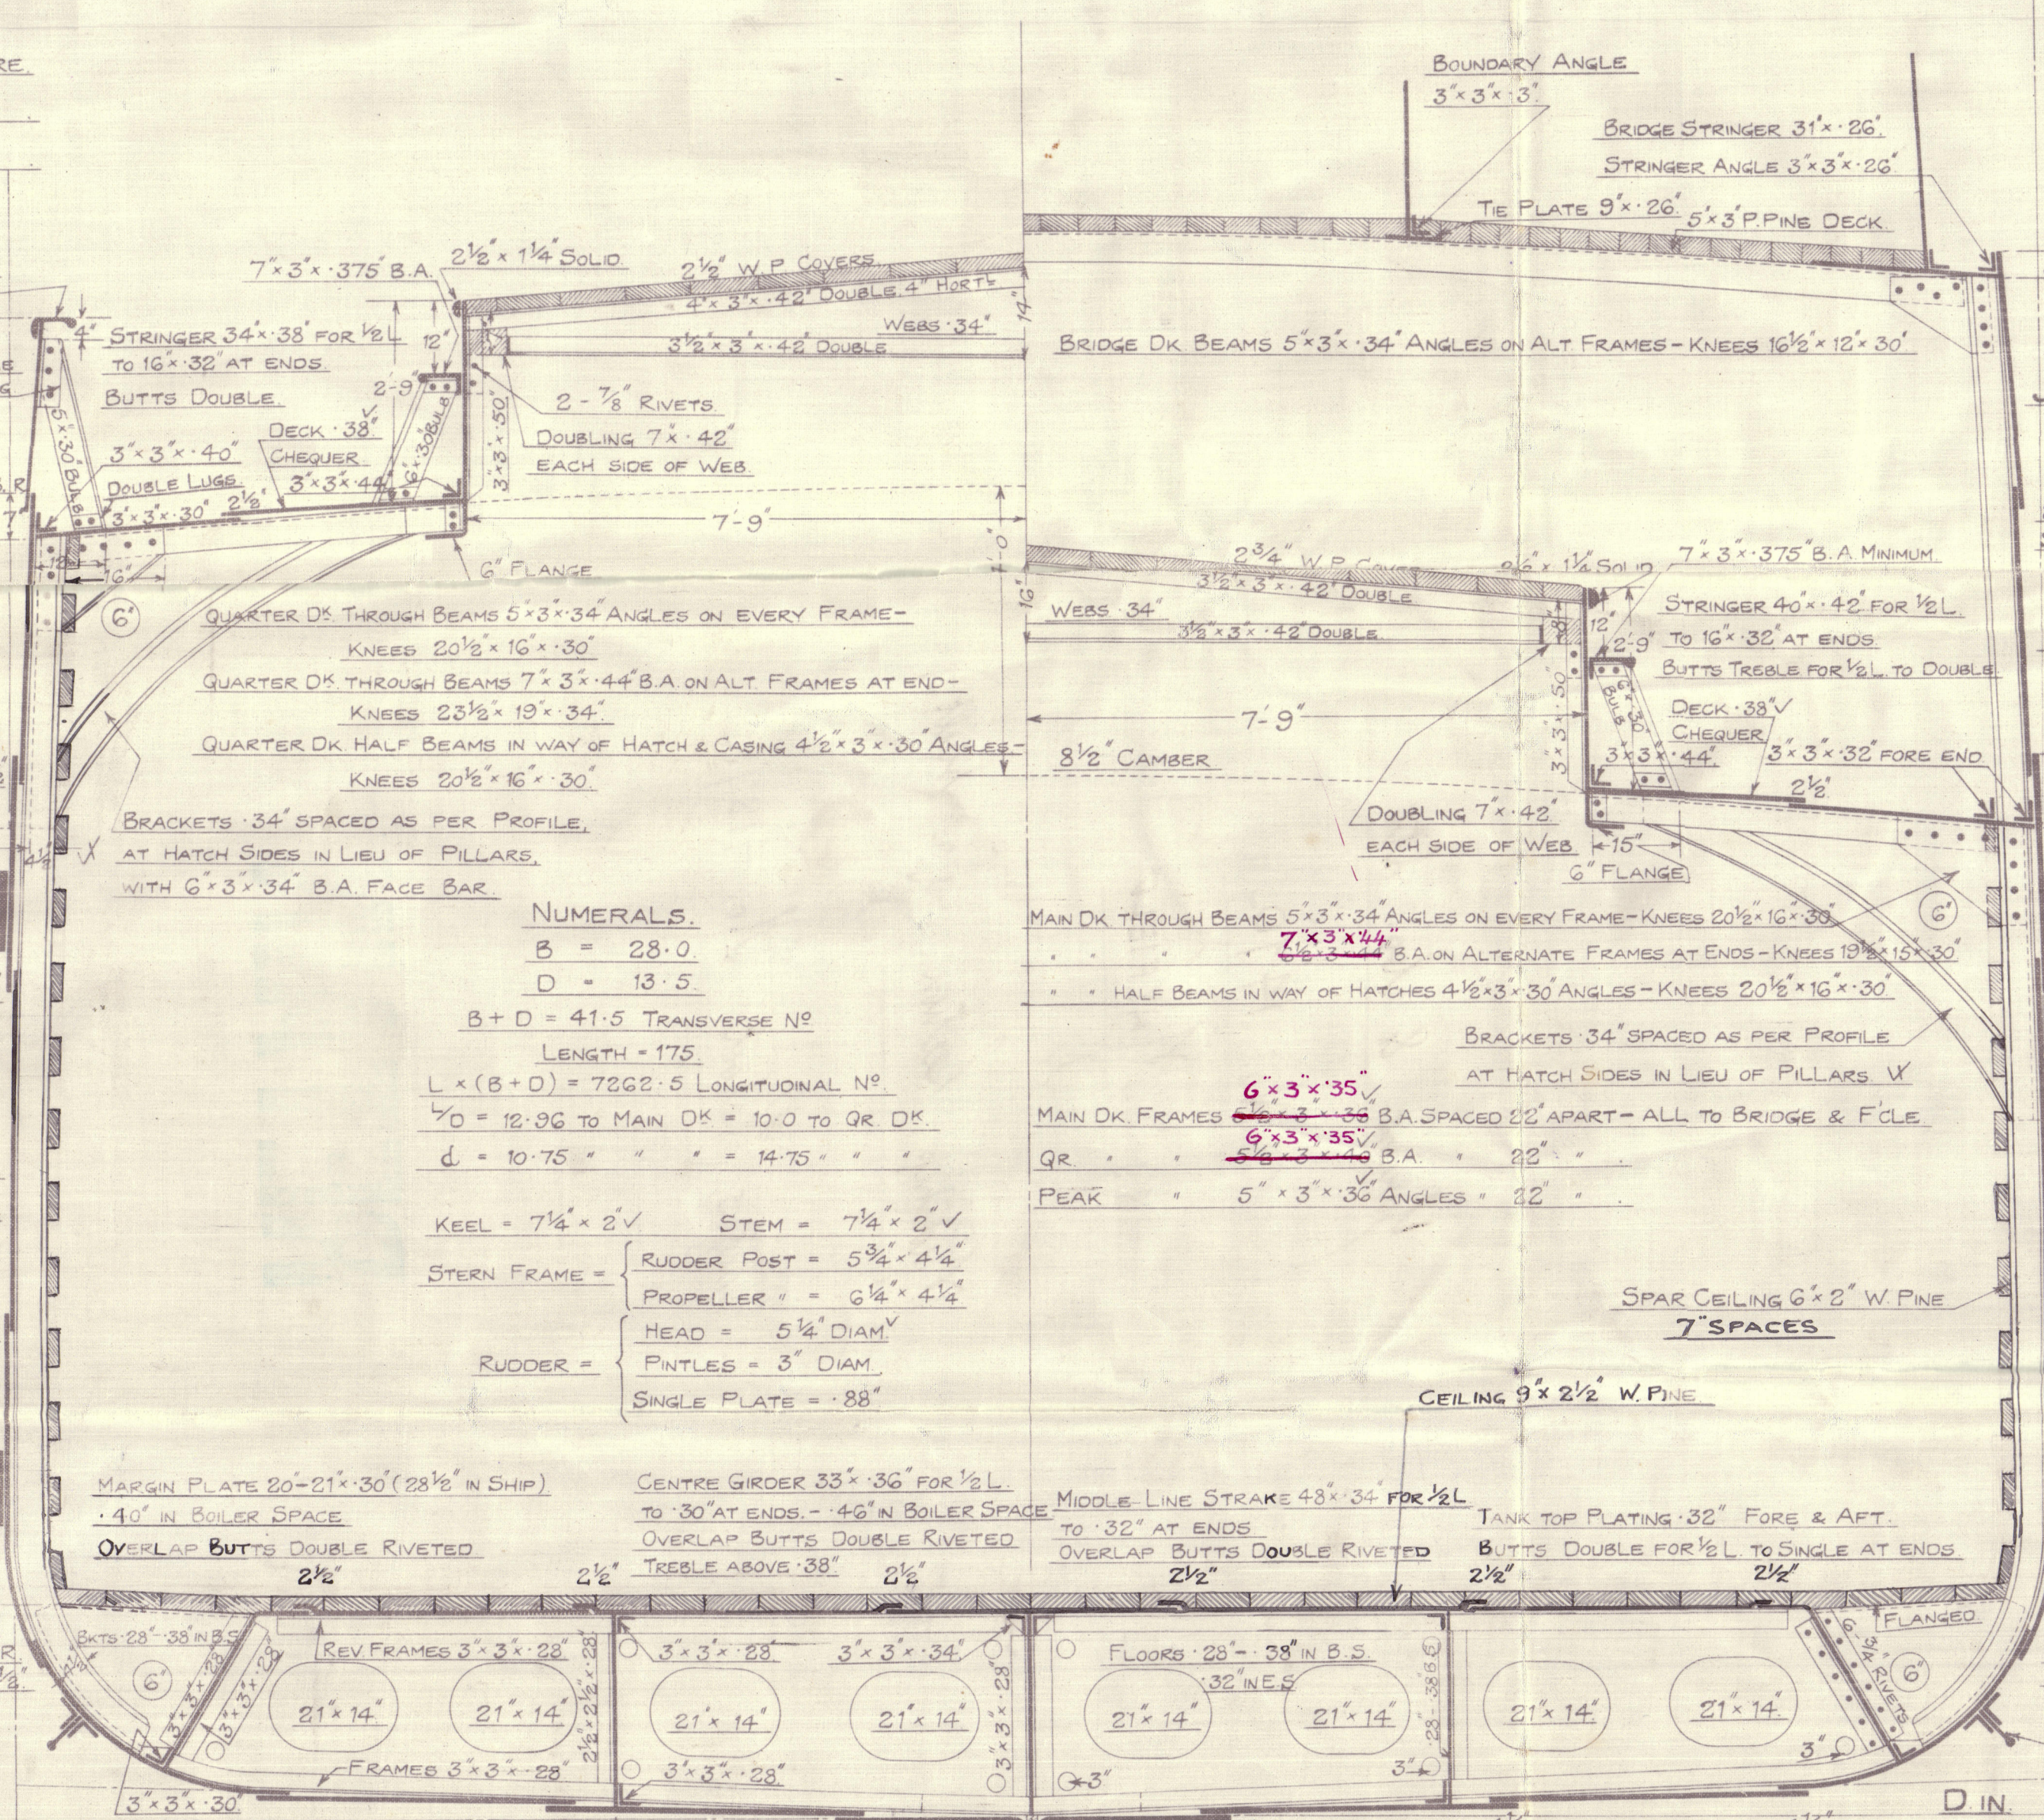

ALTERNATE BRACKET FLOORS.

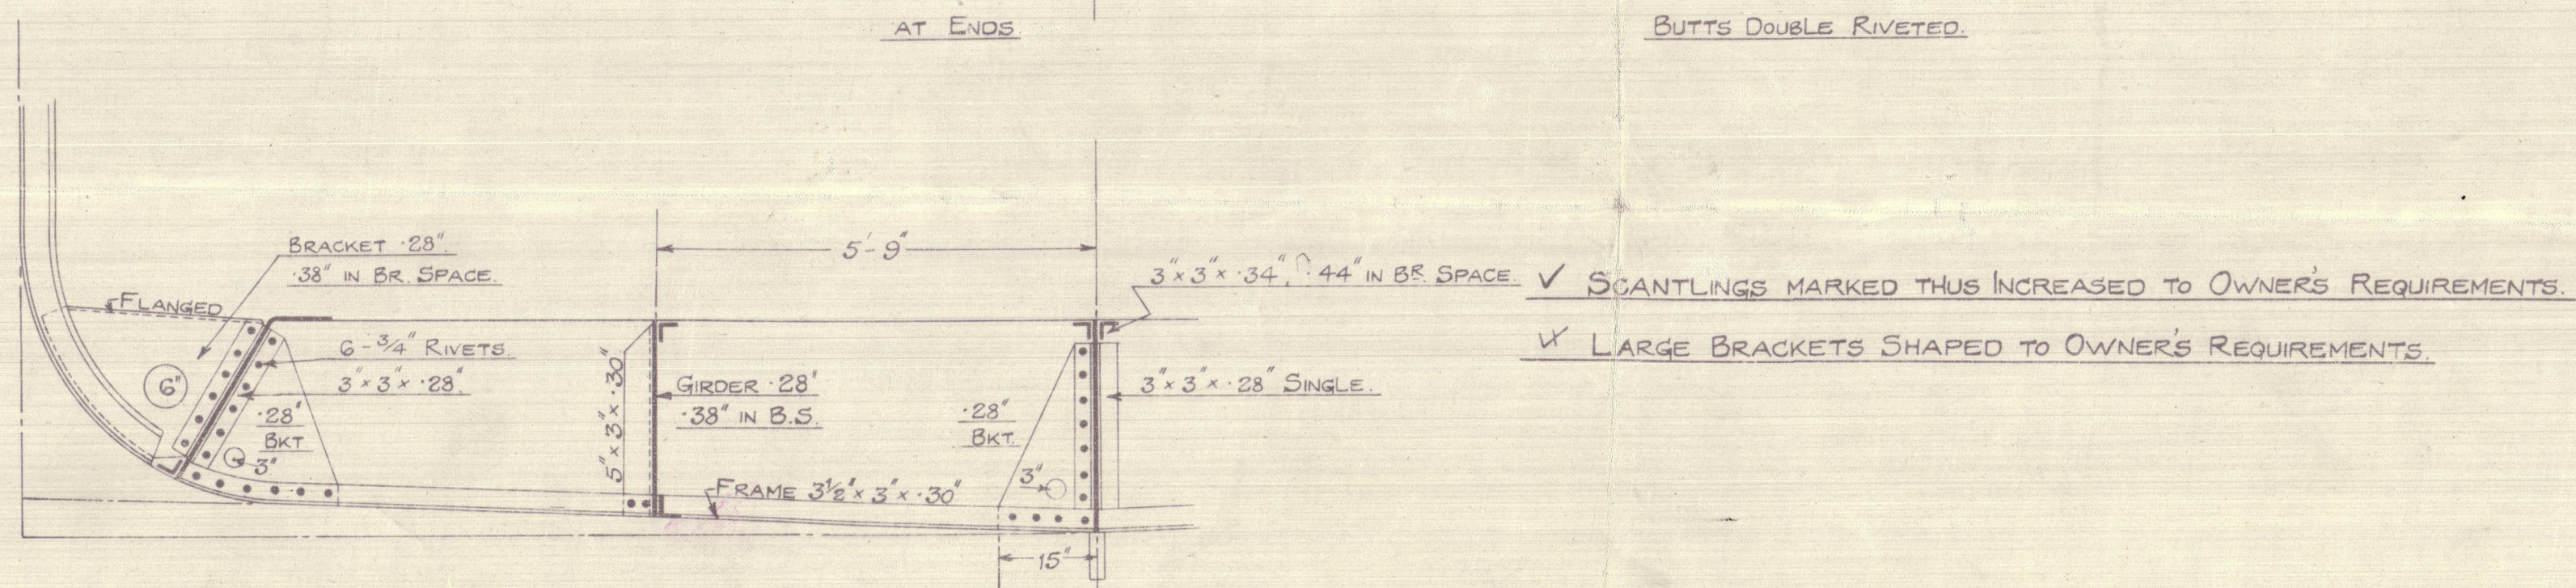

FILE STRINGER 33' x 26'  
DECK 30'  
BEAMS 5' x 3' x 30" ANGLES ON EVERY FRAME  
KNEES 16 1/2' x 12' x 30"

BRIDGE SIDE 26' - BUTTS DOUBLE

FILE 30'

BRIDGE SIDE 26' - BUTTS DOUBLE

FILE 30'

No 13052.

No 13052.

Lloyd's Register  
Foundation  
W472-0119



Yarrow & Co. Ltd.

No. 1470

S.S. " MAYFIELD "

Midship Section (as built.)

Glasgow Report No. 41876

RETAIN

W472-0119



© 2020

Lloyd's Register  
Foundation