


PROFILE N^o 231 ^s/_s

SCALE $\frac{1}{8}$ " = ONE FOOT.

DIMENSIONS
 LENGTH B.P. 345'-0" ✓
 BREADTH EX. 48'-0" ✓
 DEPTH MLD. 23'-6" ✓

JOHN PRIESTMAN & Co.,
 Shipbuilders, *John*
 SUNDERLAND. *20.8.13*

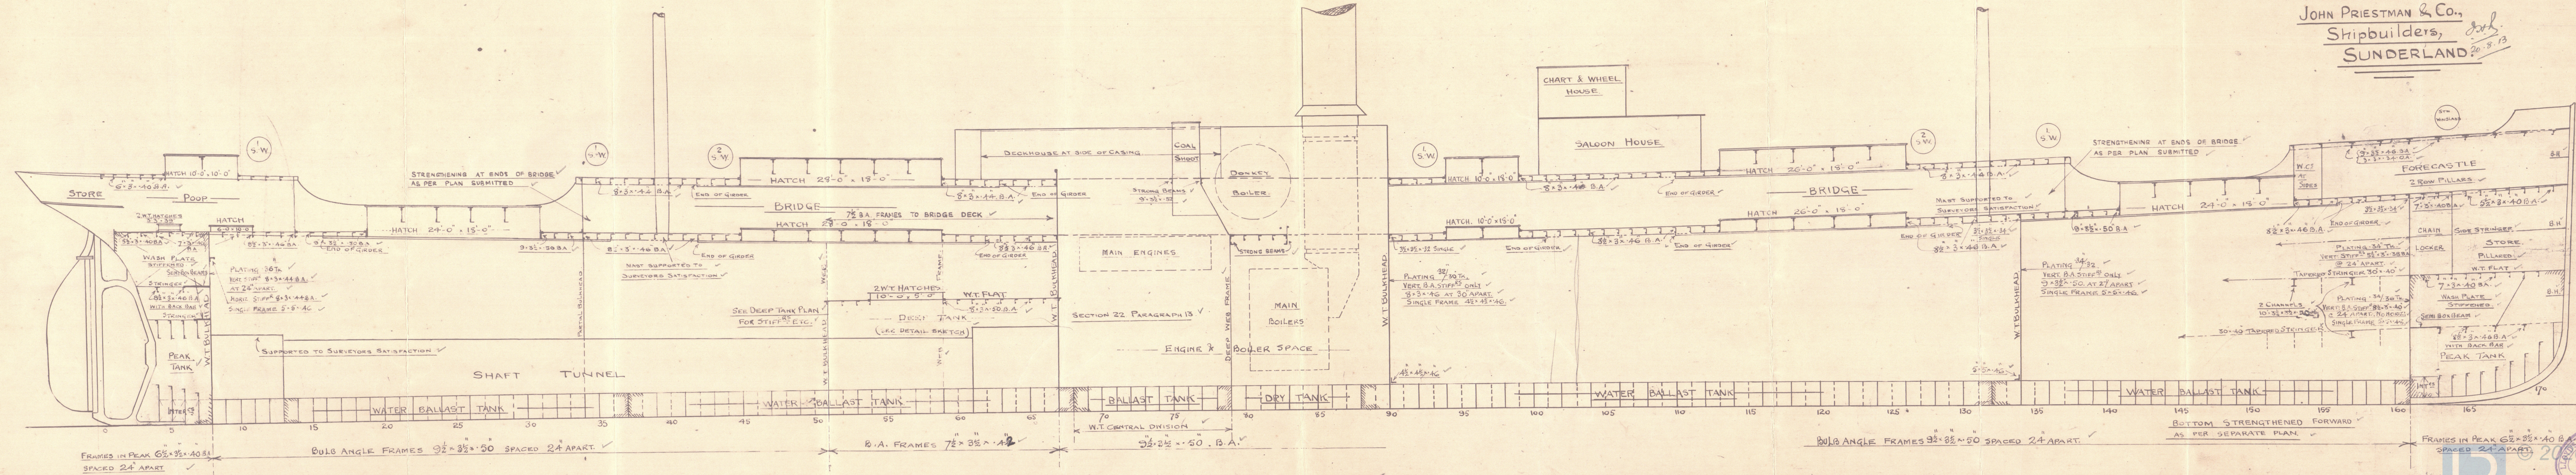

W48-0063

Tire

"ECATERINI MATSOUKI"

PROFILE. (AS FITTED)

S.S. N^o 231.

J. PRIESTMAN + C^o.

SLD RPT N^o. 25810

W48-0063



© 2020

Lloyd's Register
Foundation