


SCREW STEAMER

N^o 236

SCALE 1/2" = 1 FOOT

19.6.14
26.6.14
2.7.14
20.8.14
21.8.14
8.9.14
11.9.14

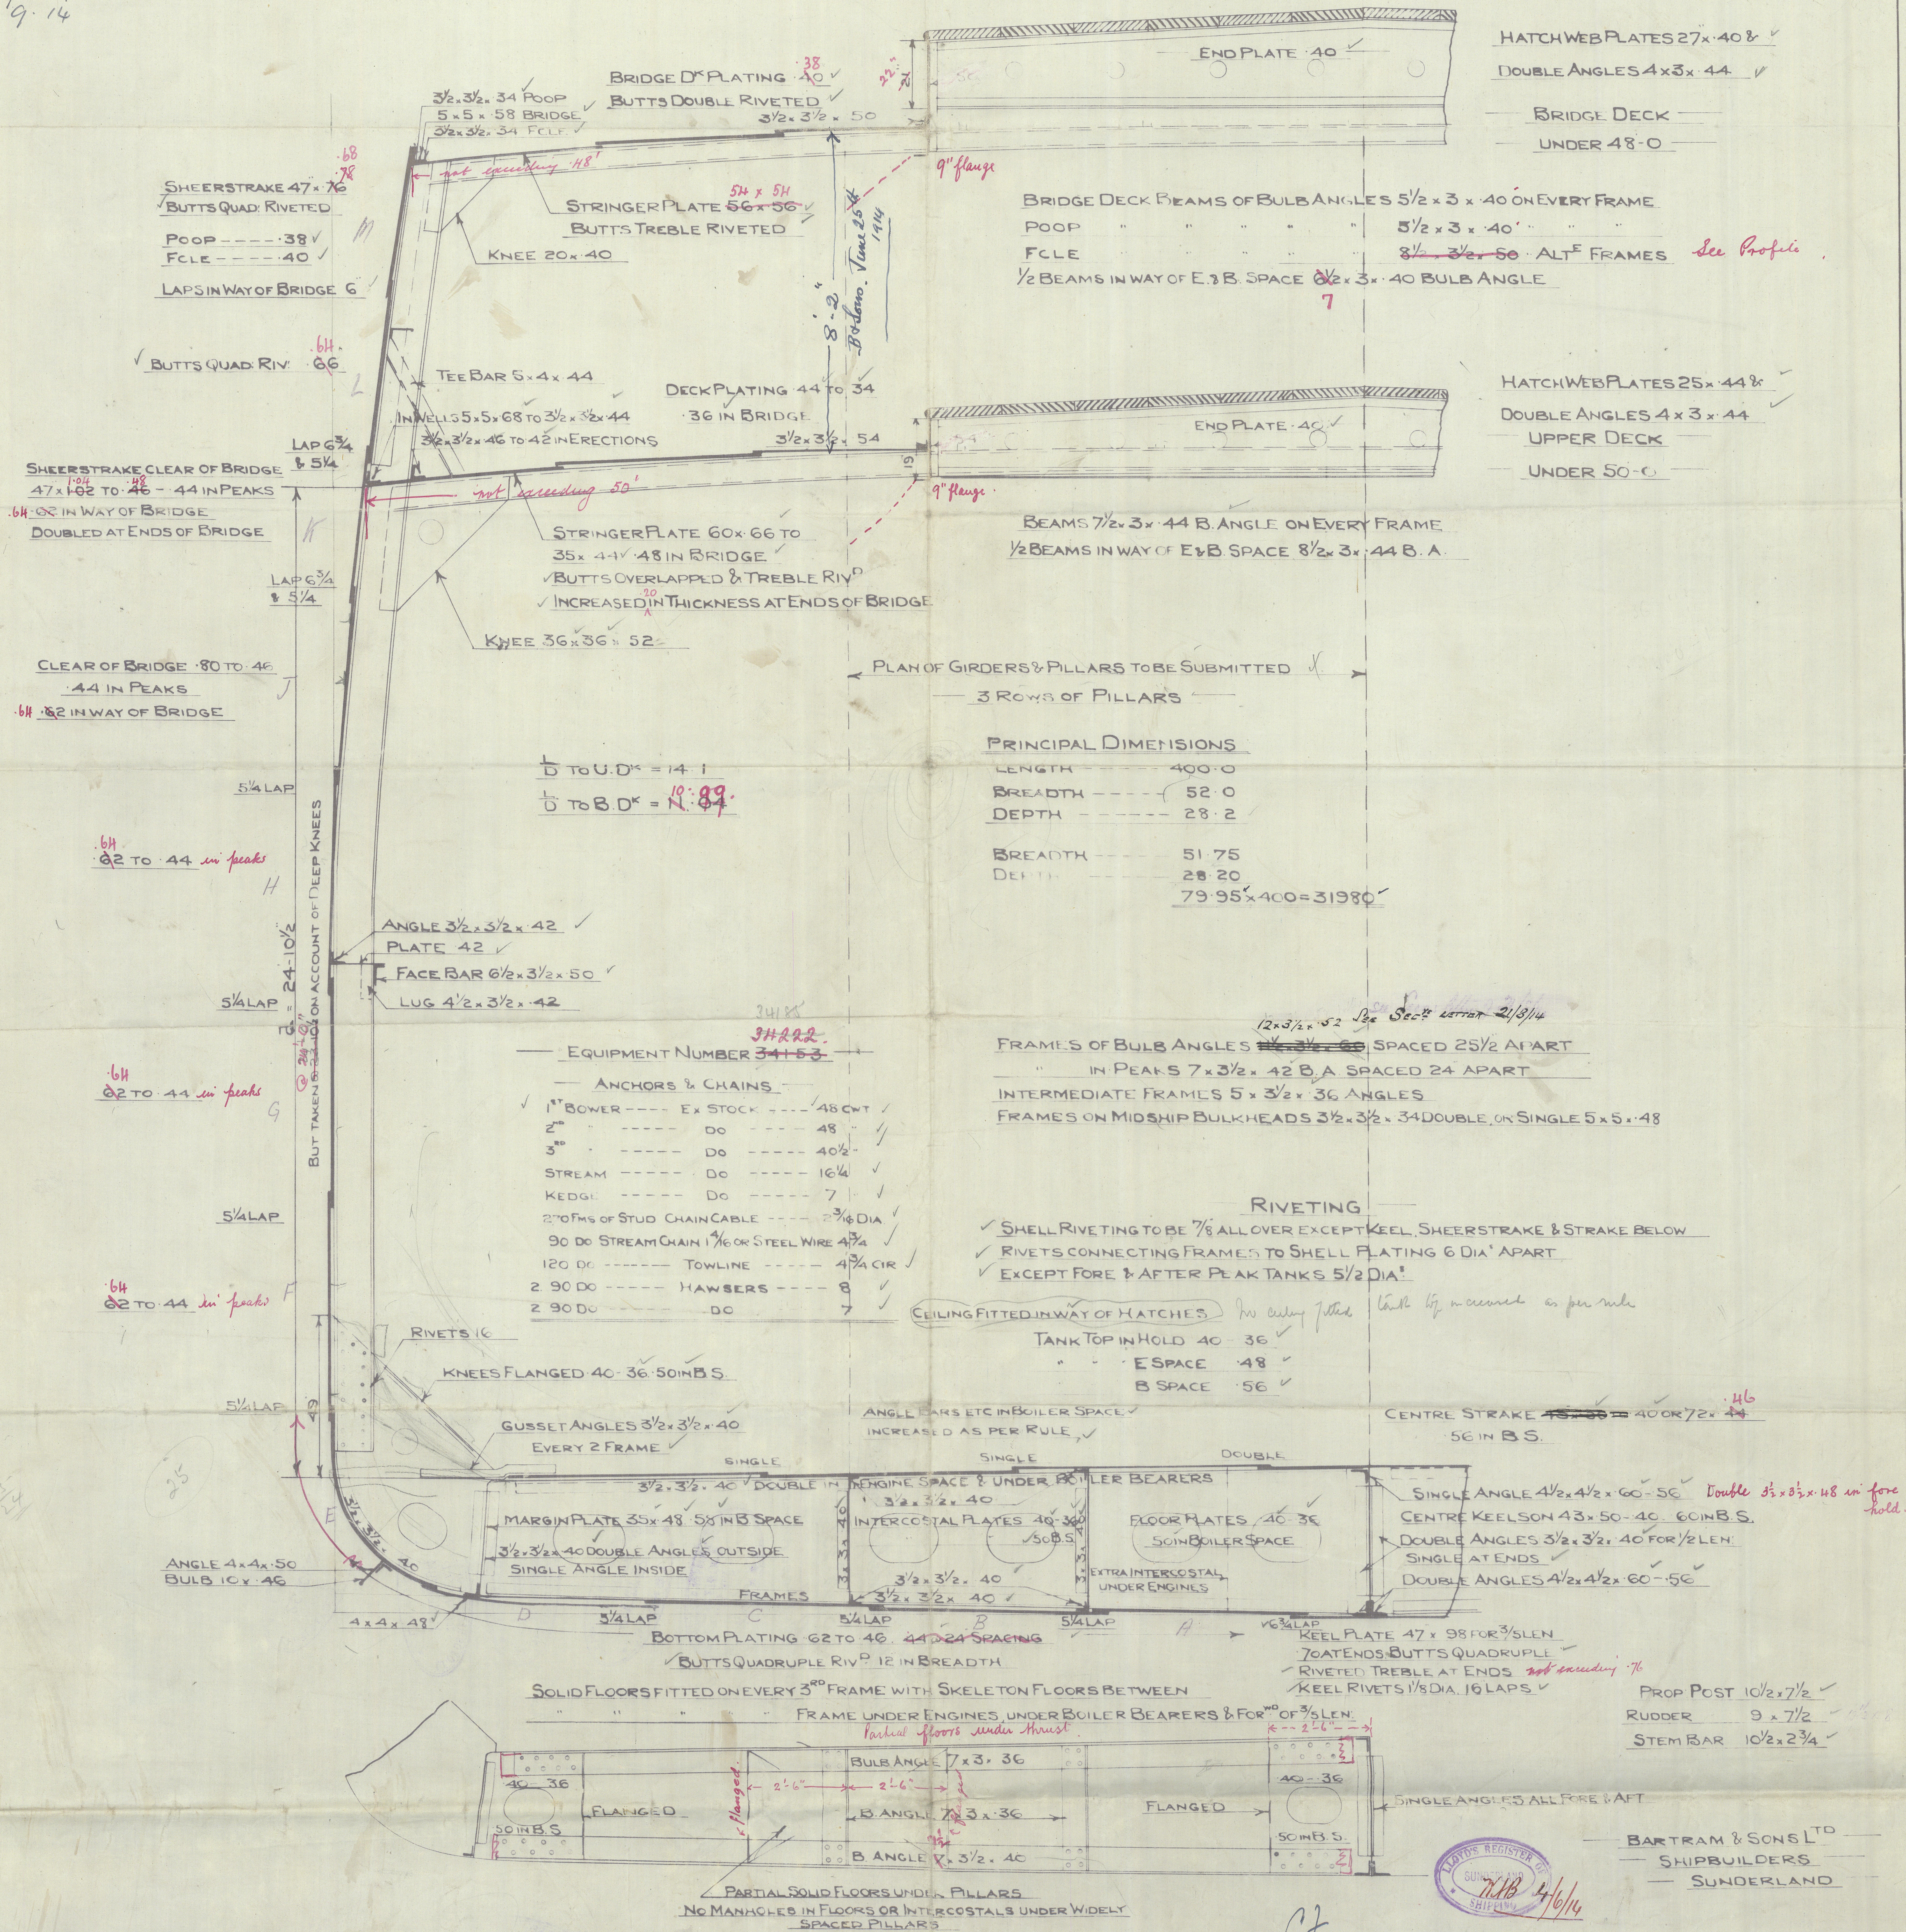

C.F.
19.6.14
26.6.14




Amended Midship Section

S.S. N^o 236


Mess^{rs} Bartram Sons & Co

S.S. HARTFIELD

No. 26442

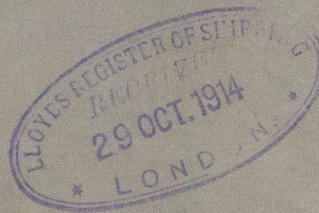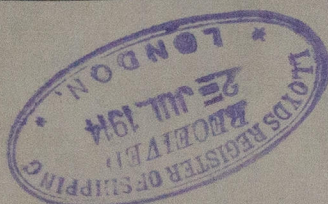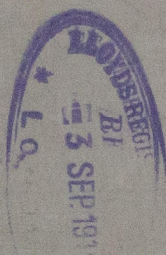

RETAIN

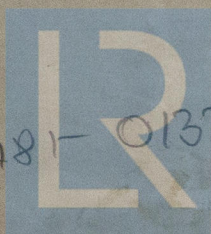

© 2020

W481-0133

Lloyd's Register
Foundation