

Scale $\frac{1}{2}$ inch = one foot as built


Midship Section
Russell & Co^s

N^o 493

S/S ⁴Albion⁴

as built

Grk. Rpt. N^o 13266

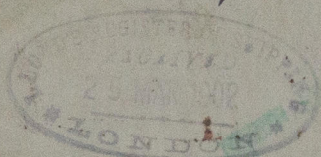

REMAINS



© 2020

Lloyd's Register
Foundation

W490-0226