


<sup>66</sup>  
5/5. MAINDY COURT.

### DIMENSIONS

LENGTH B.P. 350' 0".  
BREADTH EXT. 50' 10".  
DEPTH M.L.O. U.D. 26' 0".  
 " " S.D. 33' 11 1/2"

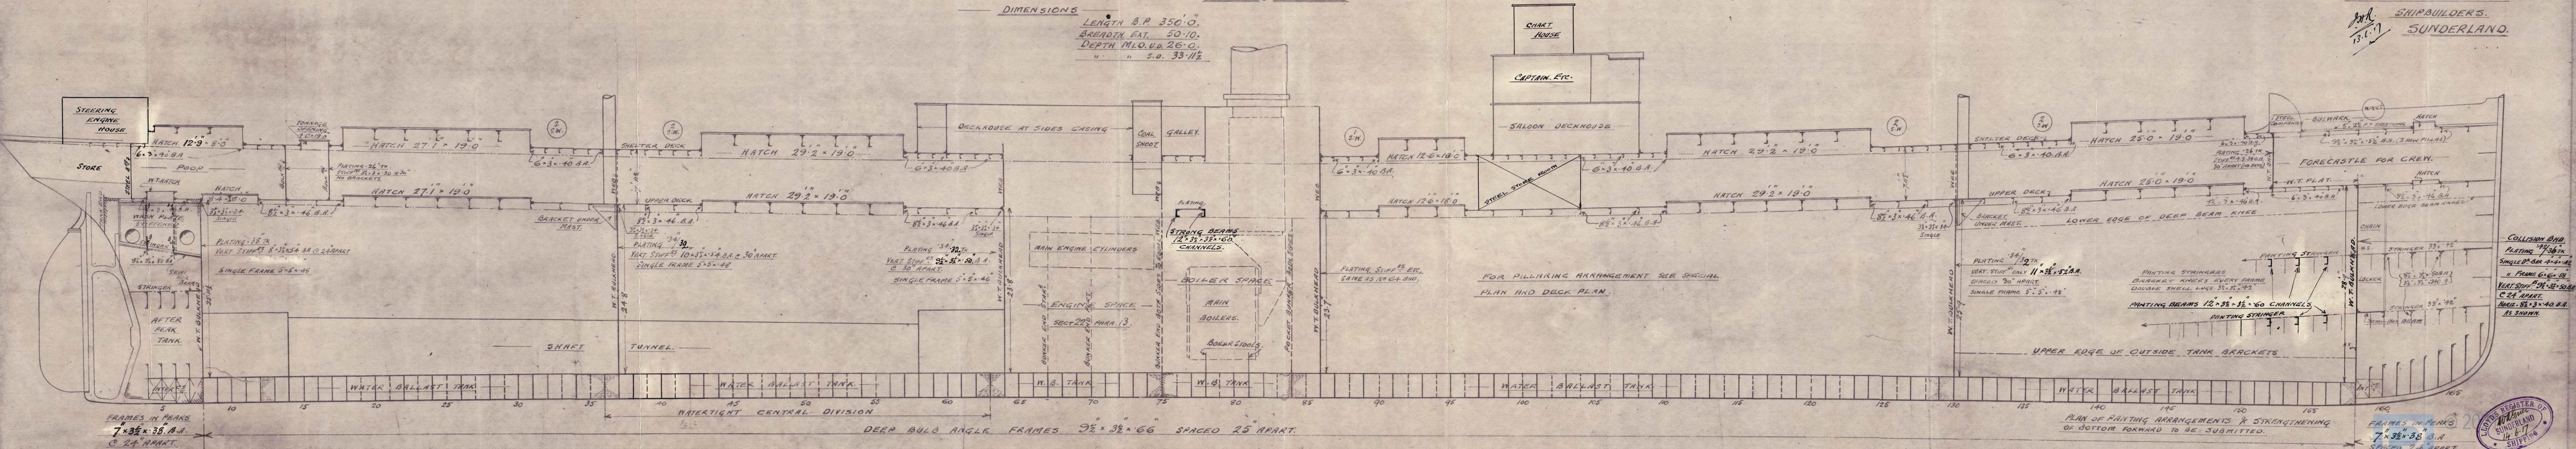

JOHN PRIESTMAN & CO.

SHIPBUILDERS

SUNDERLAND.

COLLISION B.H.D.  
PLATING <sup>72</sup>/<sub>36</sub> IN  
SINGLE D<sup>4</sup> BAR 4" x 4" A.D.  
" FRAME 6" x 6" x 58"  
VERT. STIFF. <sup>85</sup>/<sub>32</sub> x <sup>32</sup>/<sub>32</sub> x 50.0  
C 24" APART.  
NORZ. <sup>8 1/2</sup>/<sub>32</sub> x 3" x 40.0 B.A.  
AS SHOWN.



LLOYDS REGISTER OF  
SUNDERLAND  
SHIPPING

20

Lloyd's Register  
Foundation

W499-0411



PROFILE

(AS FITTED)

PRIESTMANS No 260

S. S. MAINDY COURT

SLD RPT No. 27024



RETAIN

RETAIN



© 2021

Lloyd's Register  
Foundation

W499-0411