



DECK PLANS, N° 260.

— SCALE $\frac{1}{8}$ " = ONE FOOT — $\frac{5}{8}$ " MAINDY COURT.

SHELTER DECK.

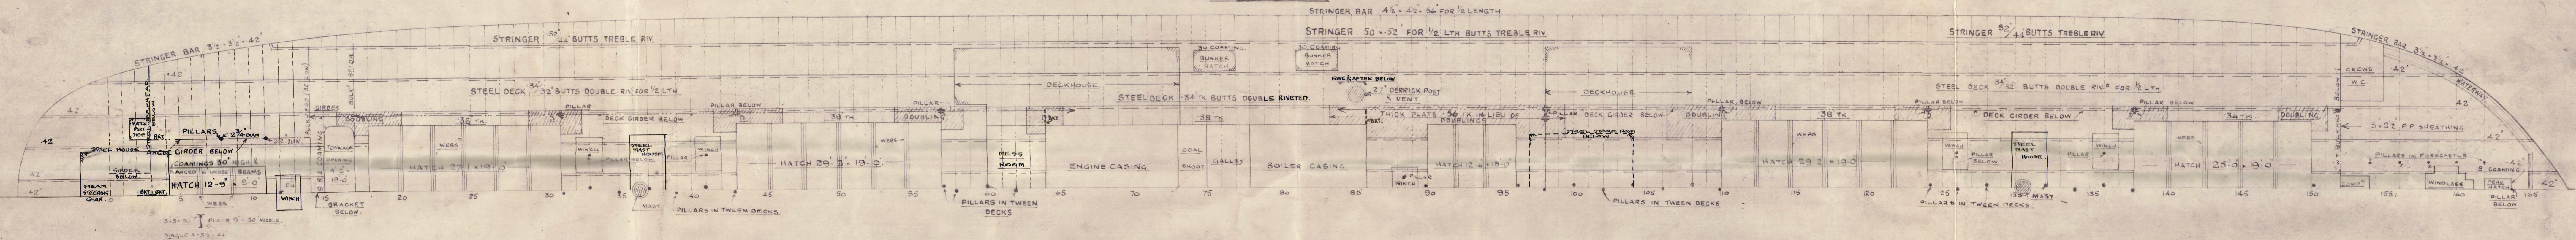

— UPPER DECK.

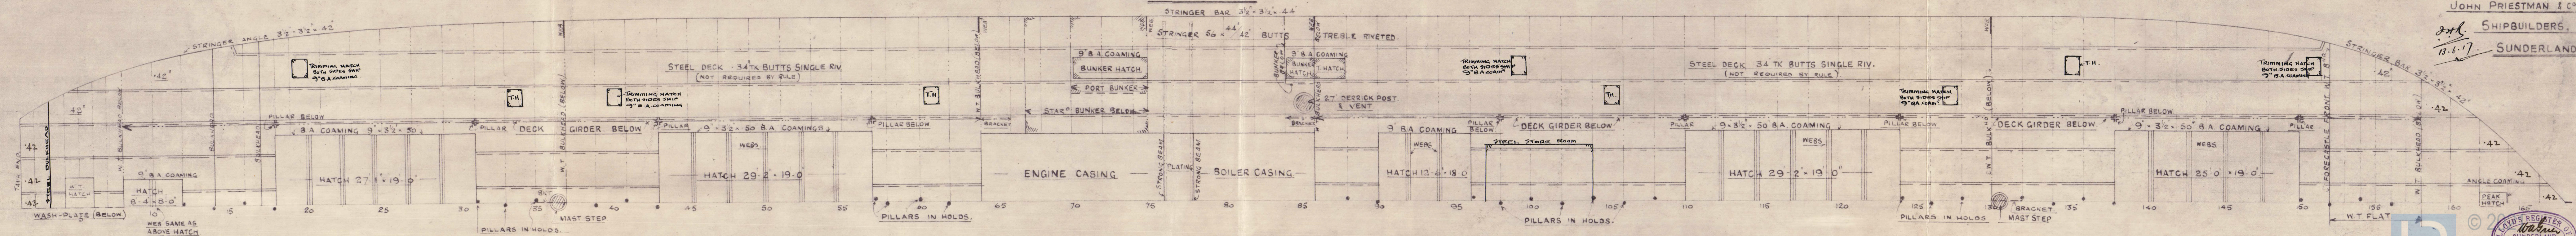

JOHN PRIESTMAN & COY

2nd. SHIPBUILDERS.

13.6.17. SUNDERLAND.


DECK PLANS

(AS FITTED)

PRIESTMANS N^o 260

S.S. MAINDY COURT

SLD RPT N^o. 27024

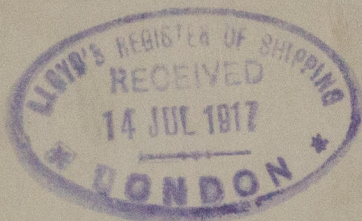

RETAIN

RETAIN



© 2021

Lloyd's Register
Foundation

W499-9412