

# Lloyd's Register of Shipping.


## SURVEYS FOR FREEBOARD.

### (CONDITIONS OF ASSIGNMENT.)

JUL -2 1938

Ship's Name "LOCHAVON" Port of Survey GLASGOW  
 Official Number 166504 Surveyor's Signature H. J. Pyle  
 Nationality and Port of Registry BRITISH, LONDON Date of Survey WHILST BUILDING.

Disposition and dimensions of superstructures, trunks, deckhouses and machinery casings to be inserted in the diagrams and tabular statement:—

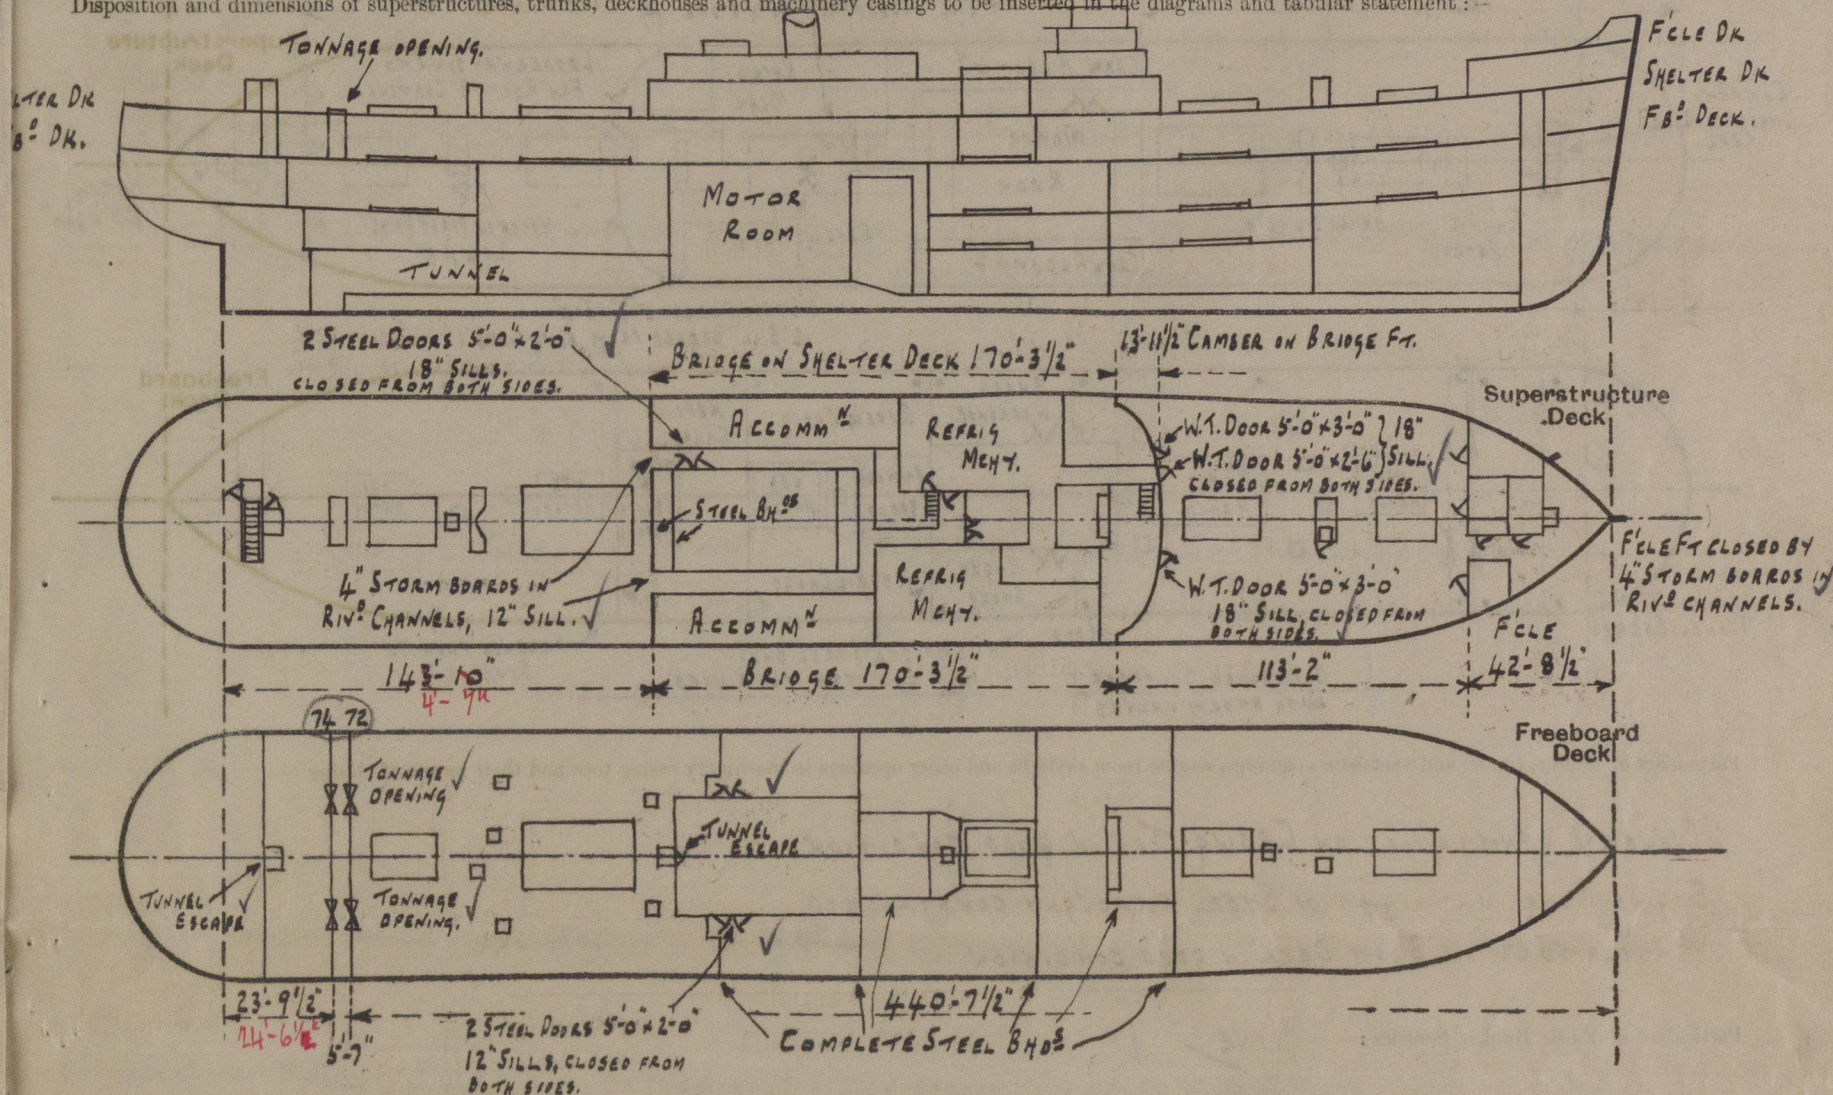

Particulars of Superstructures, Trunks, Casings, Deckhouses.


	Coaming	Plating	Stiffeners	Spacing	End Attachments of Stiffeners	Size of Openings	Height of Sills	Height of Casings
Poop Bulkhead N <sup>o</sup> 74 ON F'CL DECK ...	✓	.25" ✓	3" FLANGES ✓	34"-30" ✓	NONE. ✓	2@5'-3" x 4'-0" ✓	1'-3" ✓	8'-0" ✓
Raised Quarter Deck Bulkhead ...								
Bridge, After Bulkhead N <sup>o</sup> 72 ON F'CL DECK ...	✓	.25" ✓	3" FLANGES ✓	34"-32 1/2" ✓	NONE. ✓	2@5'-3" x 4'-0" ✓	1'-3" ✓	8'-0" ✓
Bridge, Forward Bulkhead ...								
Forecastle Bulkhead ...								
Trunk, Aft ...								
Trunk, Forward ...								
Exposed Machinery Casings on Freeboard or Raised Quarter Decks ...								
Exposed Machinery Casings on Superstructure Decks SHEL TER... DK. ...	.40 ✓	.26 ✓	4" x 8" x .36" ✓	33 1/2" ✓	TOP LAPPEL TO BEAM STIFF CARRIED DOWN AT BOTTOM	2@5'-0" x 2'-0" ✓	1'-6" ✓	8'-0" ✓
Machinery Casings within Superstructures not fitted with Class I Closing Appliances ON F'CL DECK... AFTER END.	END: ✓	.26" ✓	3" x 2 1/2" x .36" ✓	27" ✓	NONE	NONE	✓	8'-0" ✓
Deckhouses on Flush Deck Ships ...	SIDES .40 ✓	.26" ✓	4" x 3" x .40" ✓	33 1/2" ✓	TOP LAPPEL TO BEAMS & BOTTOM CARRIED TO BOTTOM OF COAMING.	NONE	✓	8'-0" ✓

Particulars of Closing Appliances (state if capable of being manipulated from both sides).

Poop Bulkhead N <sup>o</sup> 74 ON F'CL DECK ...	3 1/2" STORM BOARDS FULL HEIGHT IN RIVETED CHANNELS. ✓
Raised Quarter Deck Bulkhead ...	
Bridge, After Bulkhead N <sup>o</sup> 72 ON F'CL DECK ...	3 1/2" STORM BOARDS FULL HEIGHT IN RIVETED CHANNELS. ✓
Bridge, Forward Bulkhead ...	
Forecastle Bulkhead ...	
Exposed Machinery Casings on Freeboard or Raised Quarter Decks ...	
Exposed Machinery Casings on Superstructure Decks SHEL TER... DK. ...	2 STEEL DOORS ON PORT SIDE 5'-0" x 2'-0" CAPABLE OF BEING CLOSED FROM BOTH SIDES. ✓
Machinery Casings within Superstructures not fitted with Class I Closing Appliances ...	NONE. ✓
Deckhouses on Flush Deck Ships ...	



4

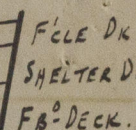

1

Lochavon.




# PARTICULARS OF PROTECTION TO OPENINGS, ETC.

HATCHWAYS ON FREEBOARD AND SUPERSTRUCTURE DECKS.										
SHELTER DECK			BRIDGE DK			SHELTER DECK			FREEBOARD DECK	
Description of Hatchway	...	...	Nº1	Nº2	Nº3	Nº4	Nº5	Nº1	Nº2	Nº3
Dimensions of Hatchway	...	...	24'9" x 17'0"	25'1 1/2" x 17'0"	22'4" x 17'0"	41'10 1/2" x 22'0"	25'1 1/2" x 17'0"	24'9" x 17'0"	22'4" x 17'0"	22'4" x 17'0"
COAMINGS	Height above Deck	...	42"	42"	42"	42"	42"	12"	12"	8"
	Thickness	...	50"	44"	50"	50"	50"	12" x 3/2" x 46" B.A.	8" x 3/2" x 40"	12" x 3/2" x 46" B.A.
	Sides	...	44"	44"	44"	44"	44"	...	...	...
	Stiffeners	...	9" x 3/2" x 50 B.A.	9" x 3/2" x 50 B.A.	9" x 3/2" x 50 B.A.	9" x 3/2" x 50 B.A.	9" x 3/2" x 50 B.A.	...	...	...
HATCH BEAMS	Brackets, Stays	...	7" x 3" x 40 B.A.	7" x 3" x 40 B.A.	7" x 3" x 40 B.A.	7" x 3" x 40 B.A.	7" x 3" x 40 B.A.	...	...	...
	Number	...	4	2	2	8	4	4	2	2
	Spacing	...	4'-11 1/2"	8'-4 1/2"	7'-5 1/3"	4'-7 1/8"	5'-0 3/10"	4'-11 1/2"	7'-5 1/3"	7'-5 1/3"
	Scantling and Sketch	...	WEBS 15" x 36" ANGLES 4 1/2" x 3" x 50" FWE WEBS AND ANGLES 4 1/2" x 3" x 46" AFTER WEBS 3 1/4"	WEBS 16" x 36" ANGLES 4 1/2" x 3" x 50" FWE WEBS AND ANGLES 4 1/2" x 3" x 46" AFTER WEBS 3 1/4"	WEBS 15" x 34" ANGLES 4 1/2" x 3" x 44" FWE WEBS AND ANGLES 4 1/2" x 3" x 44" AFTER WEBS 3 1/4"	WEBS 15" x 34" ANGLES 4 1/2" x 3" x 44" FWE WEBS AND ANGLES 4 1/2" x 3" x 44" AFTER WEBS 3 1/4"	WEBS 15" x 32" ANGLES 4 1/2" x 3" x 36" FWE WEBS AND ANGLES 4 1/2" x 3" x 36" AFTER WEBS 3 1/4"	WEBS 15" x 36" ANGLES 4 1/2" x 3" x 40" FWE WEBS AND ANGLES 4 1/2" x 3" x 40" AFTER WEBS 3 1/4"	WEBS 17" x 36" ANGLES 5" x 3 1/2" x 46" FWE WEBS AND ANGLES 5" x 3 1/2" x 46" AFTER WEBS 3 1/2"	WEBS 25" x 50" ANGLES 6" x 3 1/2" x 60" FWE WEBS AND ANGLES 6" x 3 1/2" x 60" AFTER WEBS 3 1/2"
FORE AND AFTERS	Bearing Surface	...	3 1/4"	3 1/4"	3 1/4"	3 1/4"	3 1/4"	3 1/4"	3 1/4"	3 1/2"
	Number	...	1	1	1	1	1	1	1	1
	Spacing	...	42"	42"	42"	42"	42"	42"	42"	42"
	Unsupported Lengths	...	12' x 3 1/2" x 50 B.A.	12' x 3 1/2" x 50 B.A.	12' x 3 1/2" x 50 B.A.	12' x 3 1/2" x 50 B.A.	12' x 3 1/2" x 50 B.A.	12' x 3 1/2" x 50 B.A.	12' x 3 1/2" x 50 B.A.	12' x 3 1/2" x 50 B.A.
HATCH COVERS	Material	...	SPRUCE	SPRUCE	SPRUCE	SPRUCE	SPRUCE	SPRUCE	P.PINE	SPRUCE
	Thickness	...	3"	4"	3 1/2"	3"	3"	3 1/2"	PLUG	3"
	How fitted	...	F&A	F&A	F&A	F&A	F&A	F&A	HATCHES	F&A
	Bearing Surface	...	3"	3"	3"	3"	3"	3"	3"	3"
Spacing of Cleats	...	...	24"	24"	24"	24"	24"	24"	24"	24"
Number of Tarpaulins	...	...	2	2	2	2	2	1	1	1

\*Are wood fore and afters steel shod at all bearing surfaces? ☒ YES  
 Are battens and wedges efficient and in good condition? ☒ YES  
 Are tarpaulins in good condition and in accordance with rule requirements? ☒ YES  
 Are lashings provided in accordance with rule requirements? ☒ YES

TONNAGE HATCH AFT OF Nº5 HATCH ON SHELTER DK:-  
 5'-7" x 17'-0" WIDE, 9" x 3 1/2" x 44" B.A. COAMING WITH 3" x 3" x 40"  
 REST BARS, 3" WOOD COVERS, 2 TARPAULINS

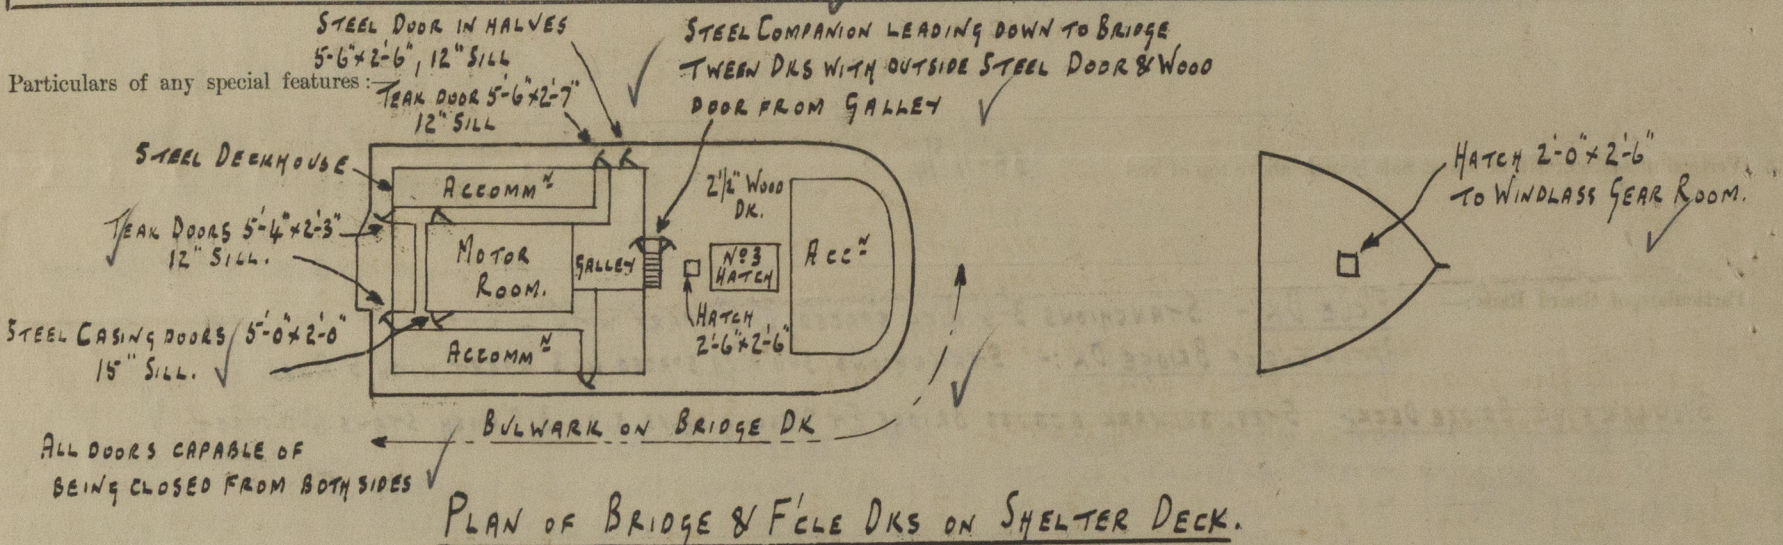

Endorsement at first survey and at surveys for renewal of Certificate:—

The fittings and appliances are in accordance with the particulars shown on this form (or as now modified) and are in good condition.