

PARTICULARS FOR FREEBOARD	
LENGTH BETWEEN PERPENDICULARS	366'-0"
BREADTH EXTREME	52'-6"
DEPTH MOULDED W.H.D. AT MID LENGTH	24'-3"
" OF HOLD (K.W. 28.19 W. 1.4)	22'-0"
TONNAGE UNDER D.S. (APPROX)	3580
COEFFICIENT OF FINENESS (CORRECTED)	
SCANTLING: CLASS 100 A.1. FULL SCANTLING VESSEL	
ROUND OF BEAM	12'
SHEER: AFTER SIDE OF STERN POST 4'-8" FORESIDE OF STEM 9'-6"	
" LENGTH FROM " 2'-7" & LENGTH FROM " 5'-3"	
LENGTH OF POOP: 29'-4" AT SIDE 29'-4" AT CENTRE 8'-0" HIGH	
" BRIDGE 22'-8" 22'-8" 8'-0"	
" FORE 33'-4" 33'-4" 8'-0"	
UPPER D.K. NOT SHEATHED WITH WOOD	


30/3/27

Nº487.


## PROFILE & DECK PLANS.

LENGTH BETWEEN PERPENDICULARS	366'-00
BREADTH MOULDED	52'-31
DEPTH	24'-25
CLASS	100 A.1. FULL SCANTLING VESSEL
SCALE	1/8" = 1 FT.

WINDLASS, MASTS, WINCHES & STEERING GEAR  
TO BE SUPPORTED TO SURVEYORS SATISFACTION.

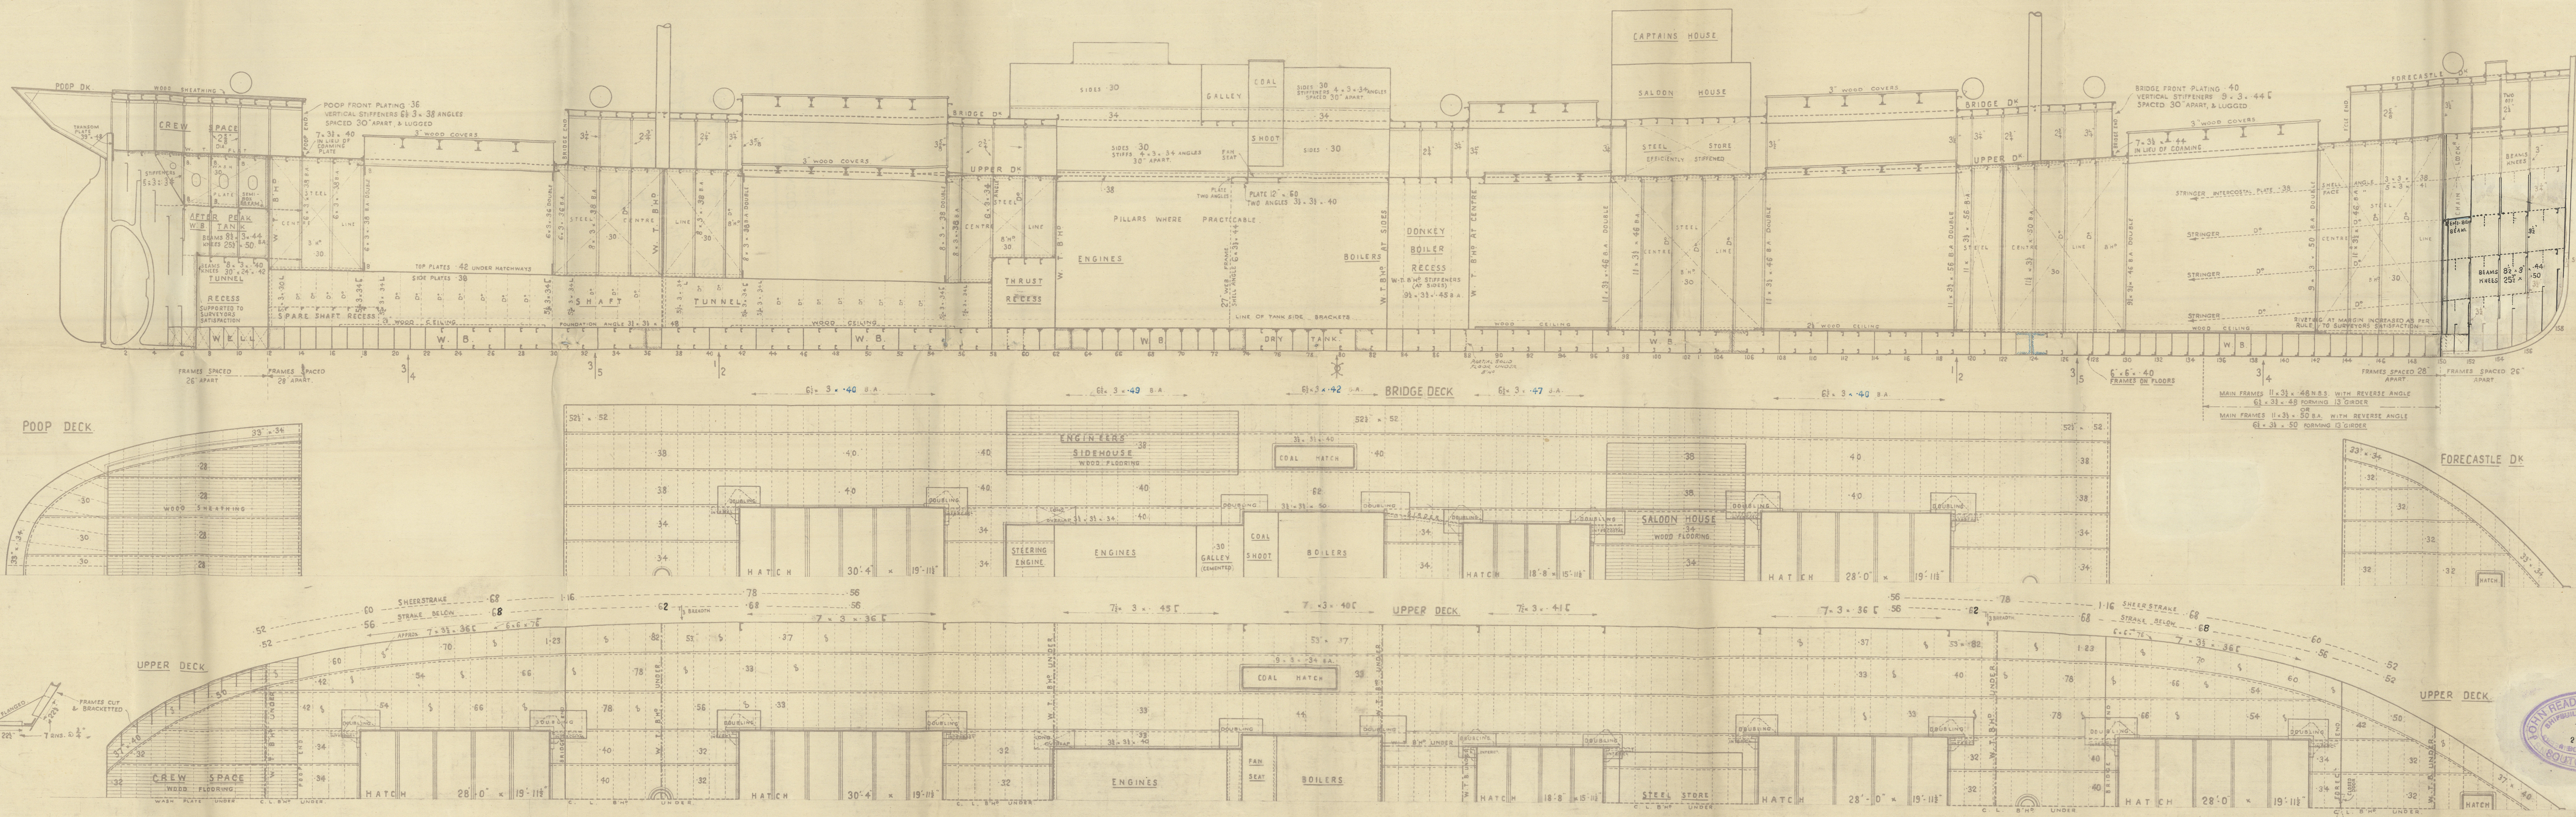

WJ.  
30.3.27

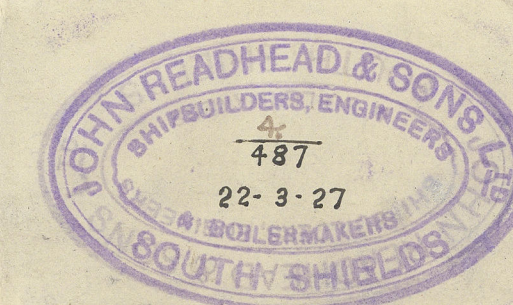



Readings

487

Supplement of 484

Profile & Deck Plans

---


S. S. "KAIRNWOOD"

NEWCASTLE ON TYNE.

Report No. 8222H.

---

V151-0161

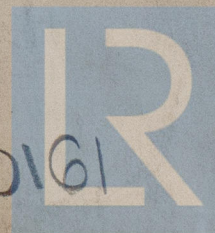

© 2021

Lloyd's Register  
Foundation