

# N<sup>o</sup> 677 & 8. PROFILE & DECK PLANS.

31/7/19  
DIMENSIONS MOULDED 230' 7" x 38' 0" x 20' 3"  
1<sup>st</sup> N<sup>o</sup> 58.25 2<sup>nd</sup> N<sup>o</sup> 1A.596  
SCALE 1/8" = 1' 0"




TWO ROWS OF TUBULAR FILLS AT HATCH ENDS.





Handwritten note: "Handless Supported 16" Surveys on Satisfaction."

Sec. 22 para 12.

See Elevation.

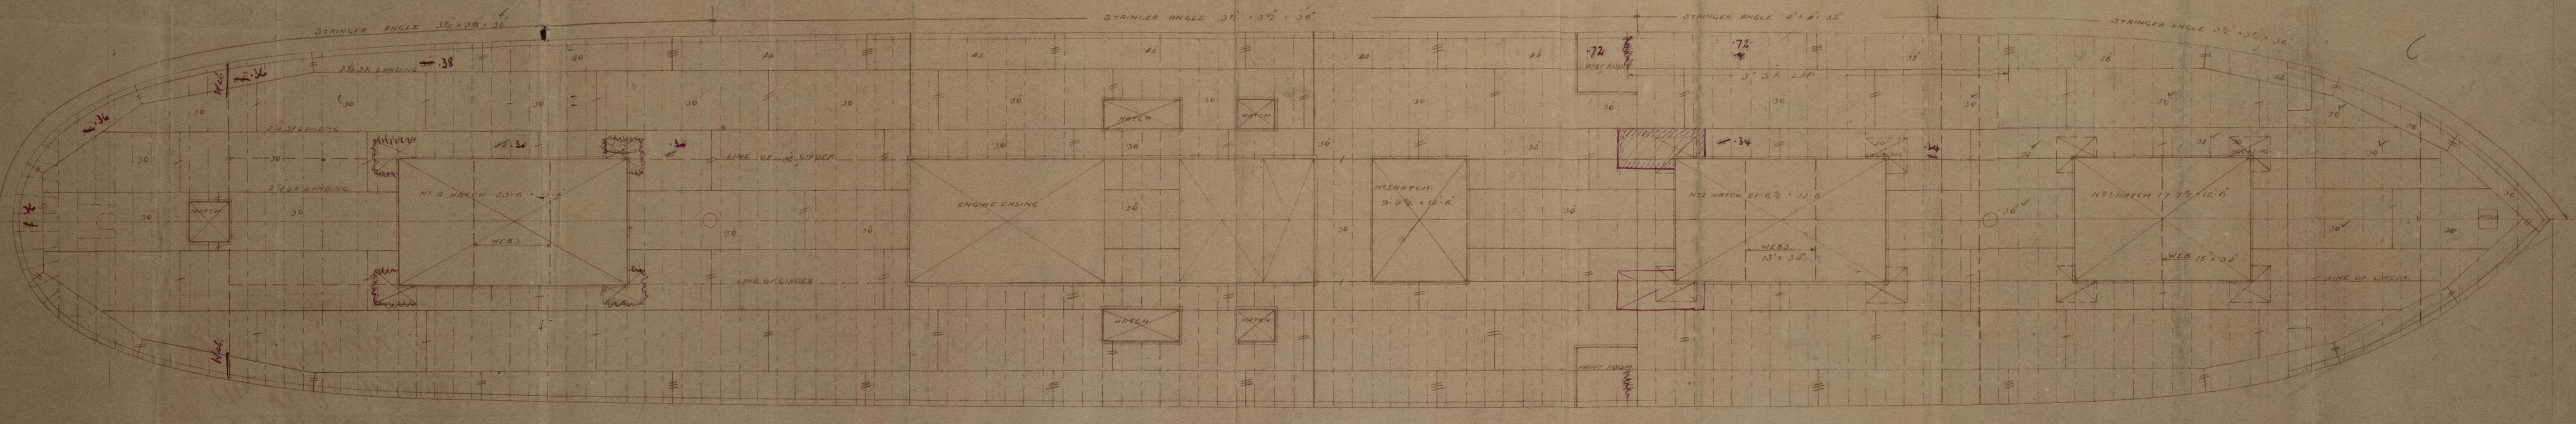

ALTERNATIVE. (See Elevation) (See Elevation) (See Elevation)

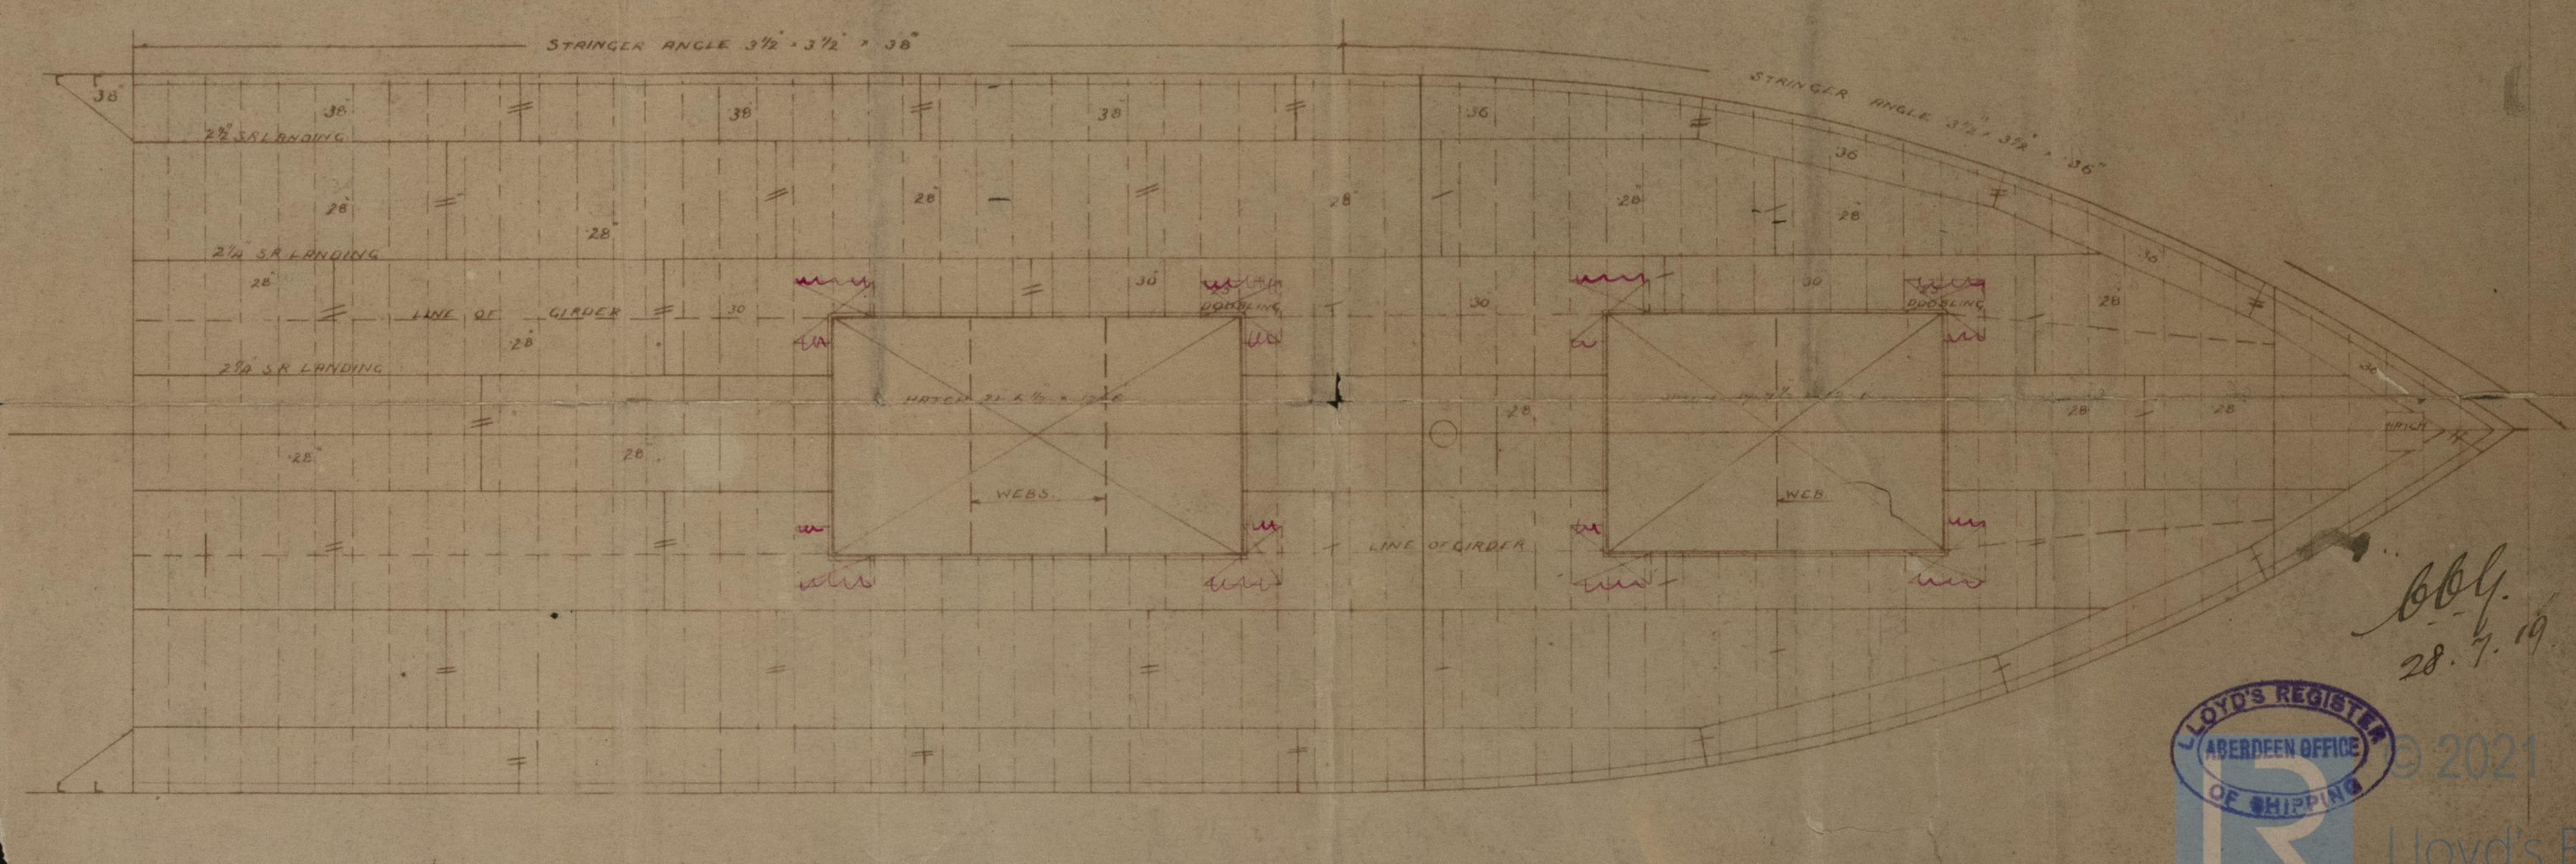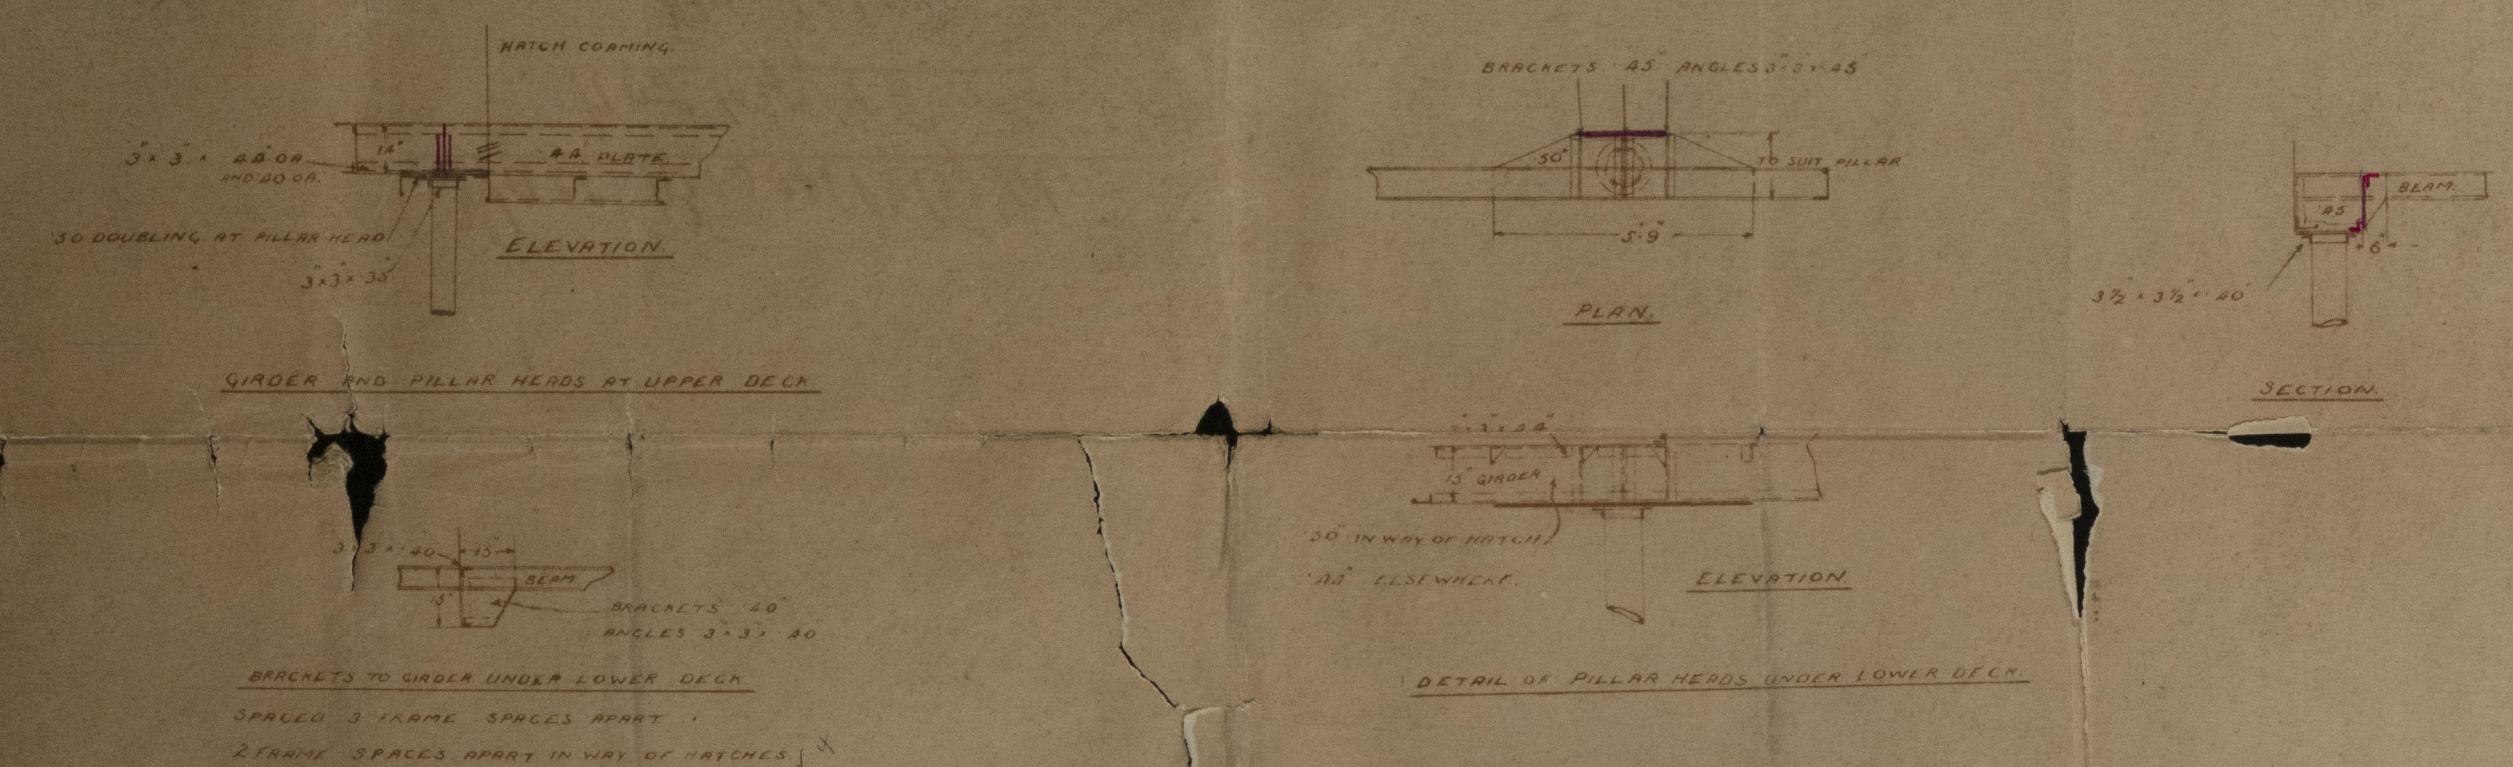

Handwritten note: "bbl. 20.7.19"



Hall Russell & Co. Ltd

Nos. 6244 & 8

Profile.

S. S. Lisbon

Abn. Y. & Co. Rept. No. 12545.

S. S. "Castellano"

Abn. Y. & Co. Rept. No. 12632.

Aberdeen

W51-0217



© 2021

Lloyd's Register  
Foundation