

SJ 12: 295

Hauptspant


1:25

Haupt Dimensionen

Länge zwischen den P.R.	39.45 m
Breite auf Spanten	8.50 m
Breite über Deck	7.35 m
Seitenhöhe	2.55 m
Tiefgang	1.00 m

class 100 A with fwd corresponding to and aft of 6'-0" For coasting services between Lorne Marquis and Port Elizabeth.

Nistula

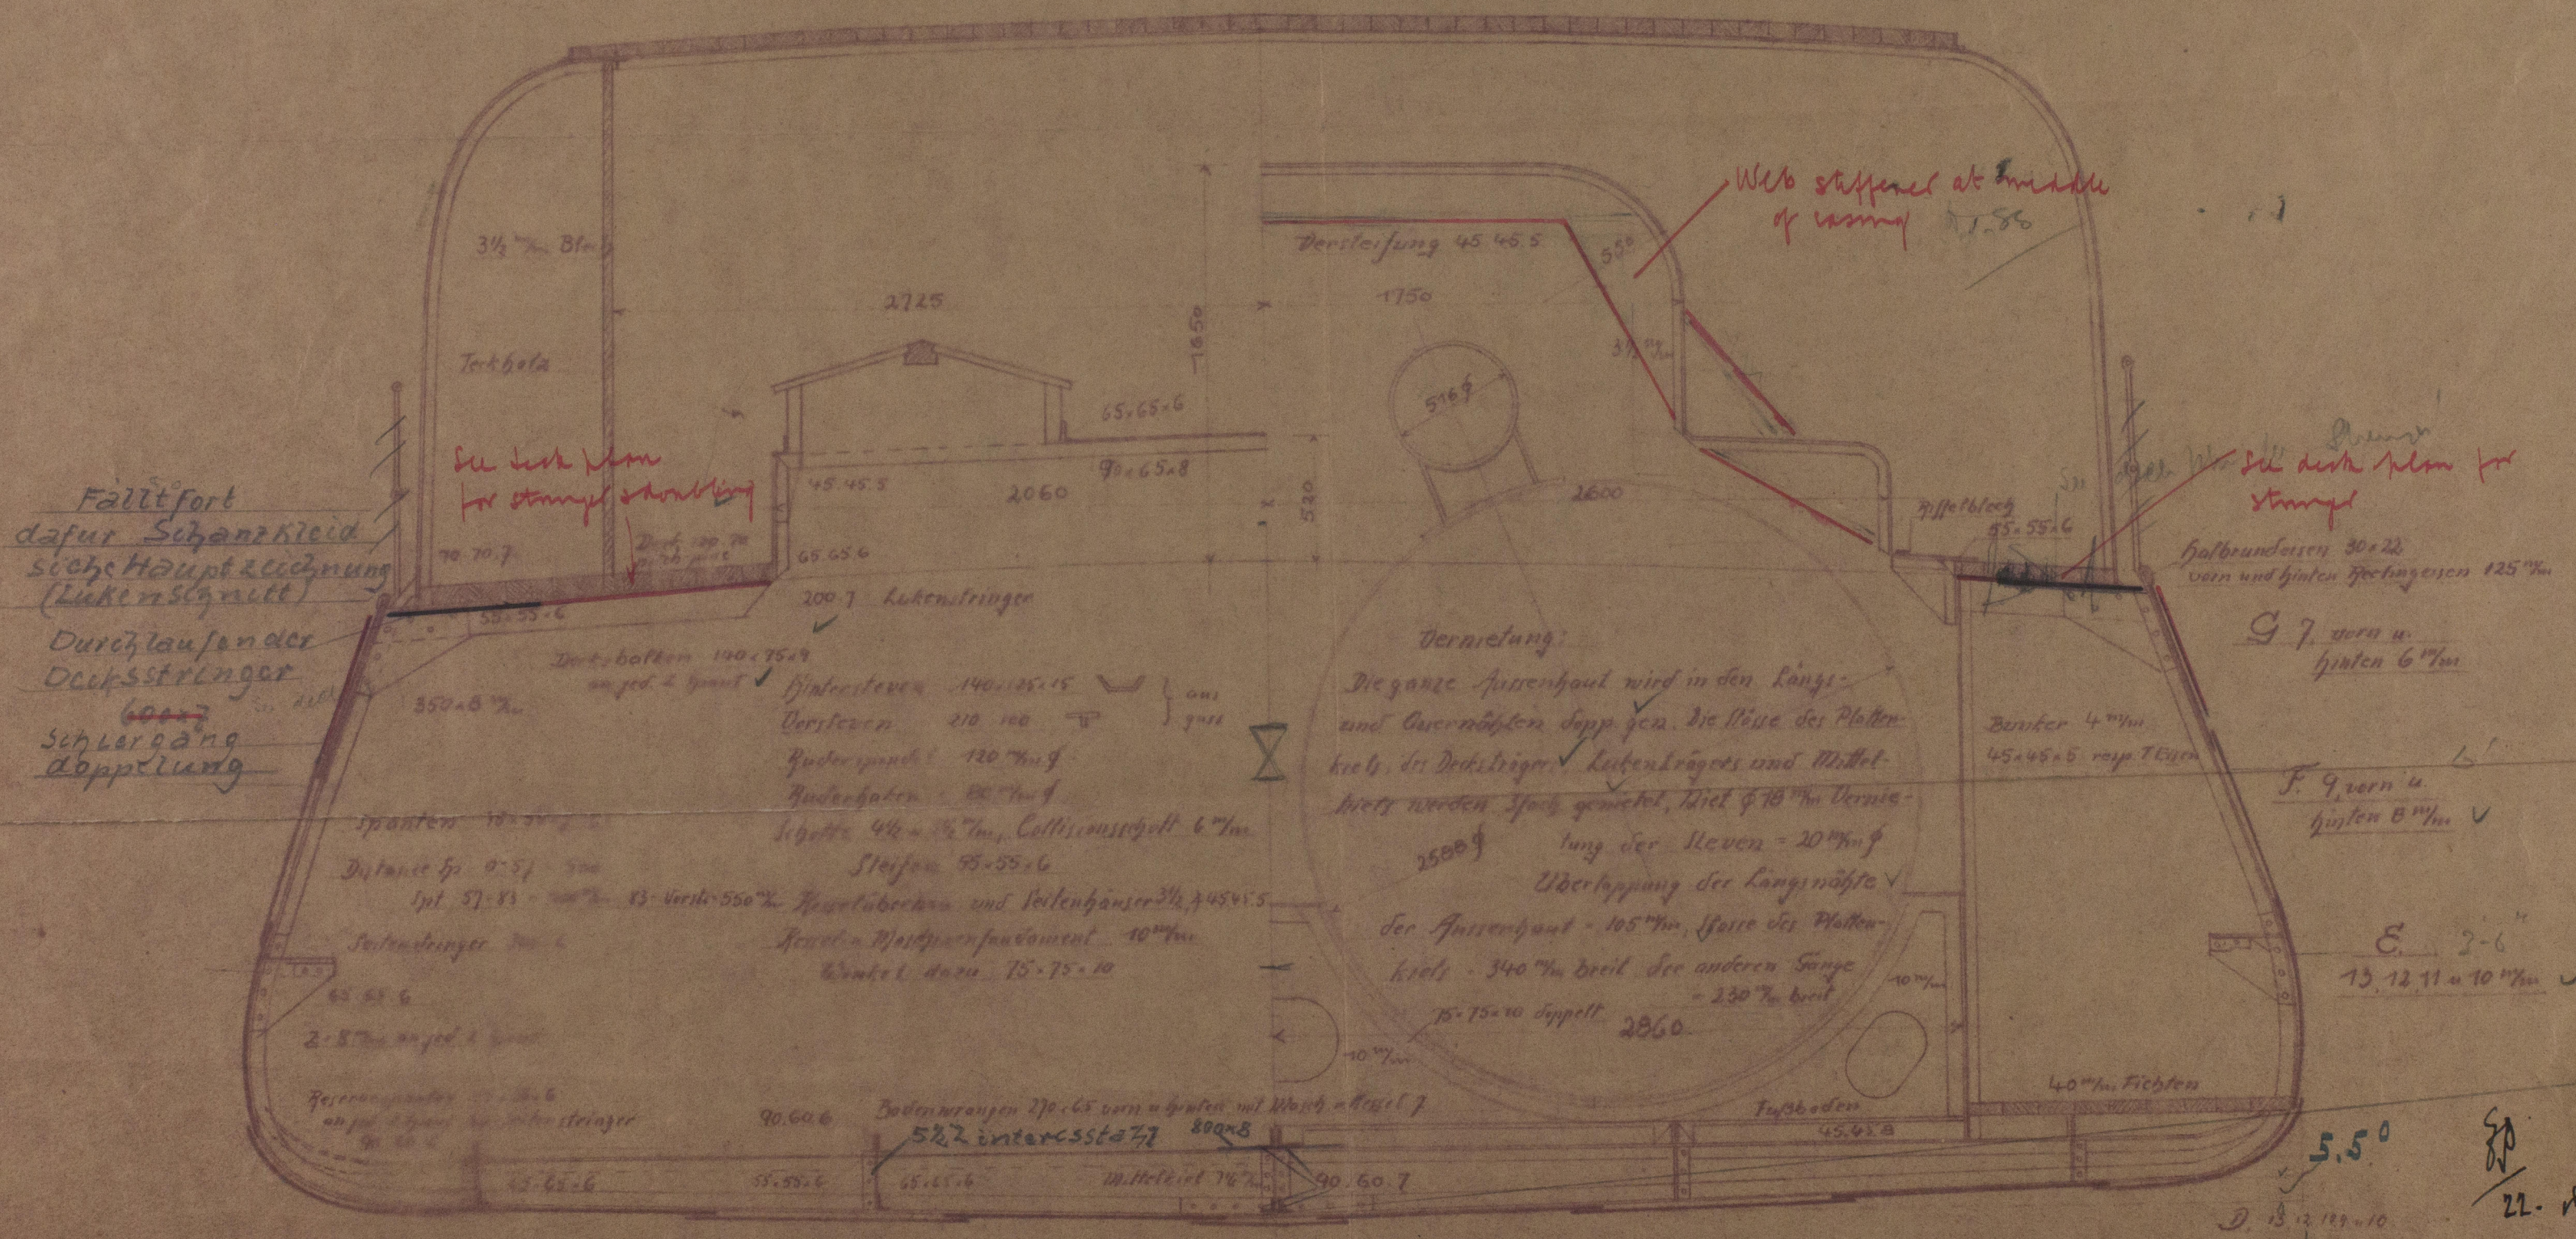

lidship section
55" Sandera
Hunting after 204 m.

RETAIN

W512-0099

8-4
8-5 $\frac{1}{2}$
1-9
6-8 $\frac{1}{2}$
-



© 2020

Lloyd's Register
Foundation