
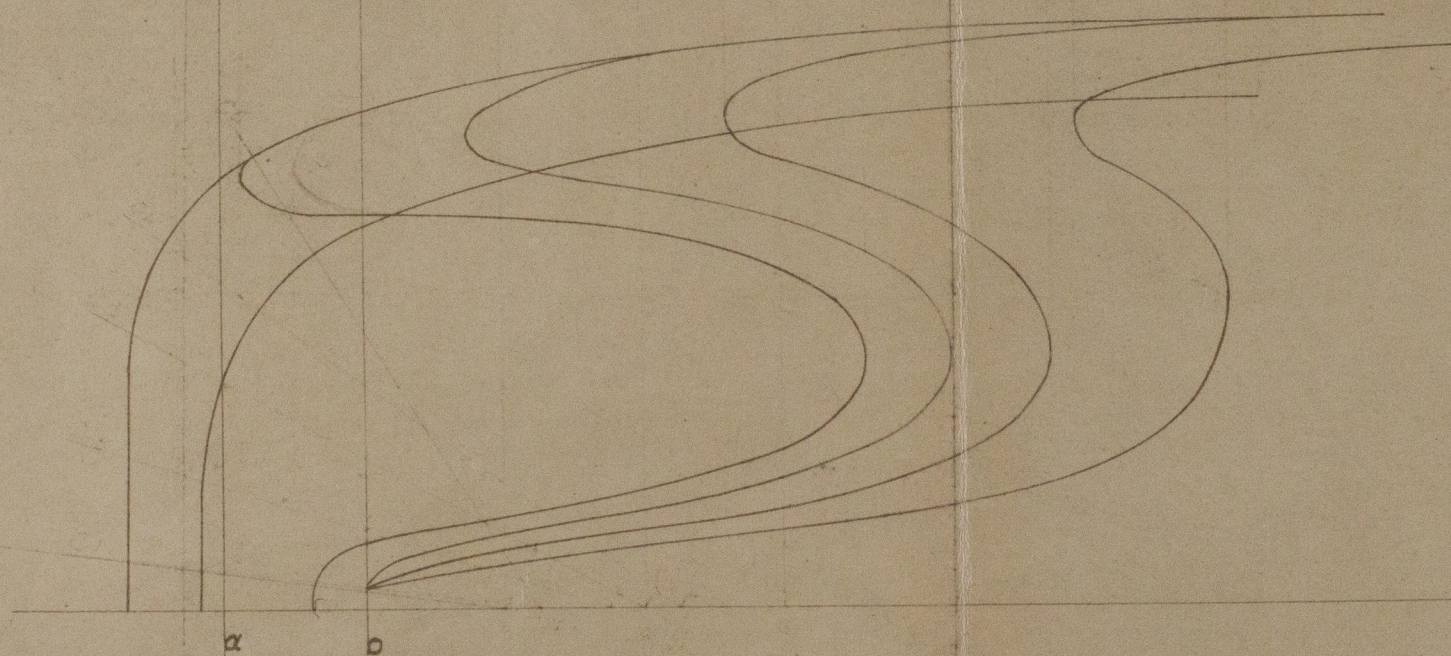


Forwarded to LR
with Survey Report - Gibraltar 2261
20/1/33
W. Matthews.

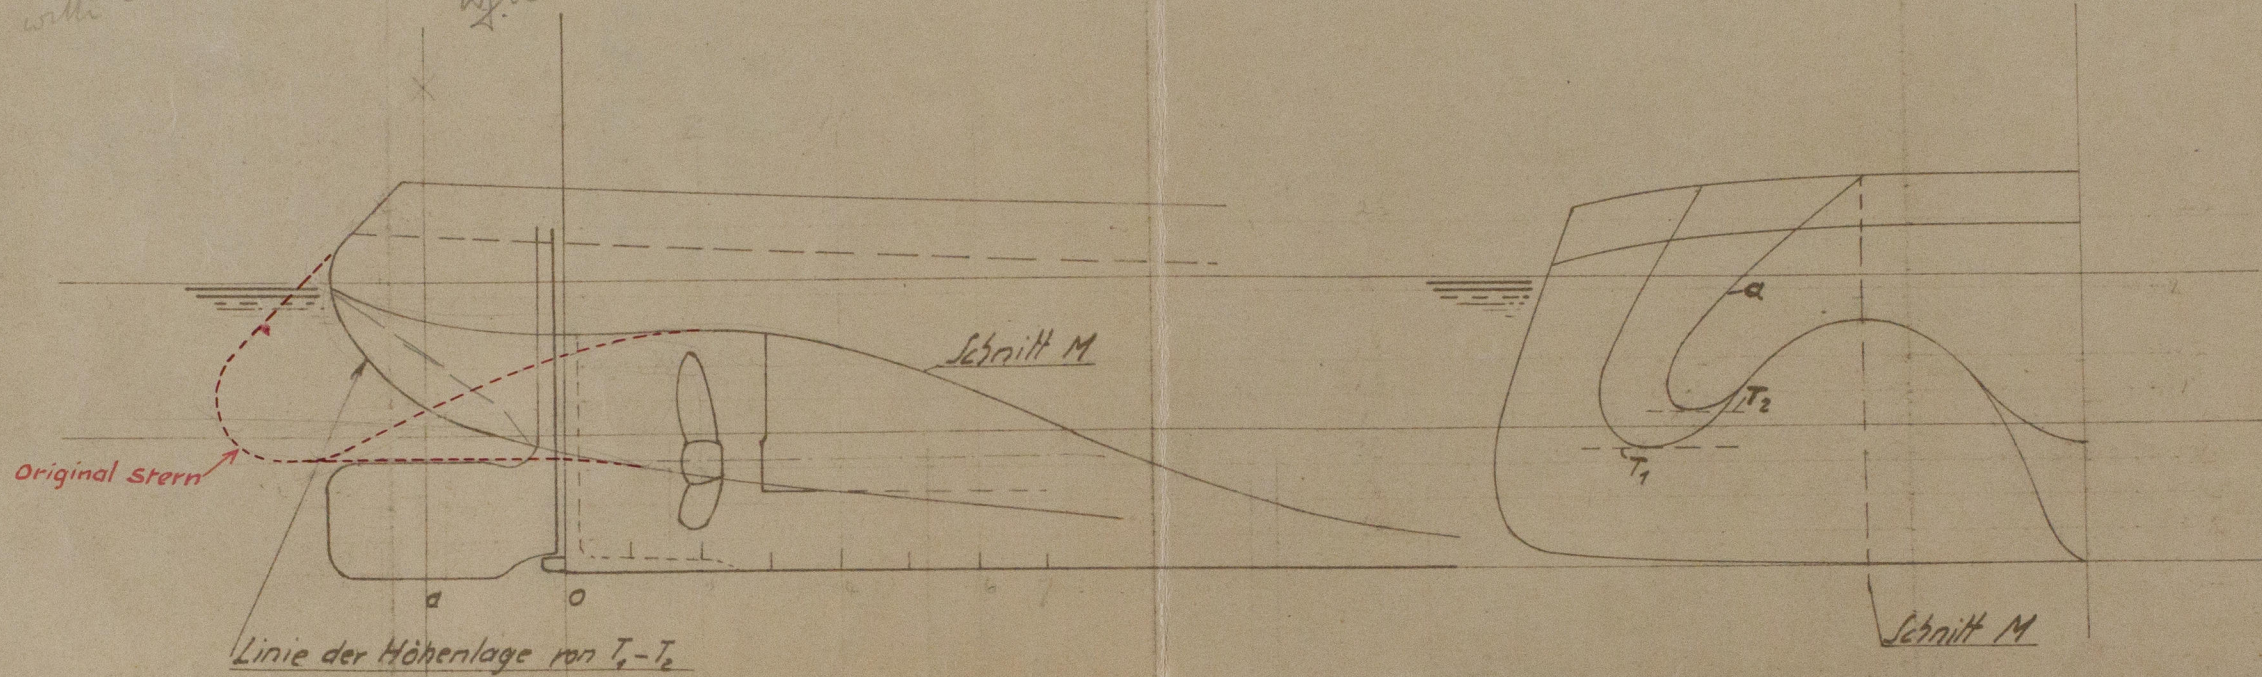

S.S. Gardenga

Hinterschiff

14. 1. 50

W 512-0101

S. S. Gardenza

File # 2261

Alteration to
Oster.

RETAIN

© 2020

Lloyd's Register
Foundation

W512-0101