


BUILT BY -
THE NORTH OF IRELAND SHIPBUILDING COY LTD.,
FOYLE SHIPYARD,
LONDONDERRY,
1921.

LLOYDS NUMERALS.


BREADTH MLD.	52.5
DEPTH MLD.	23.25
TRANSVERSE NUMERAL	81.75
LENGTH B.P.	388.00
LONGITUDINAL NUMERAL	31719.00
1/2 [UPPER DECK]	13.26

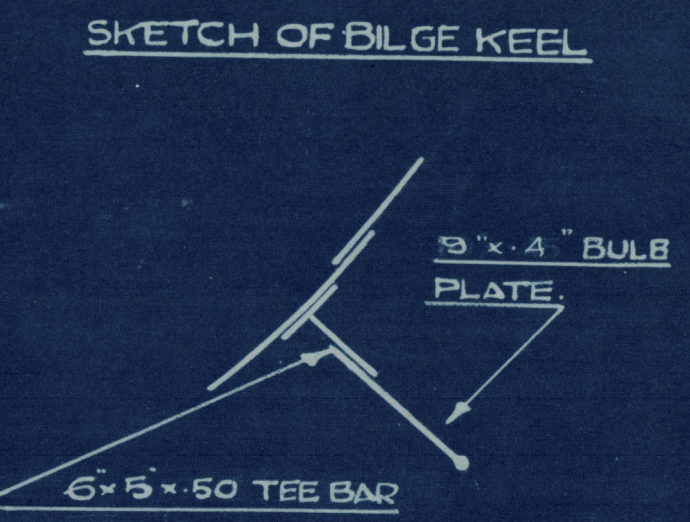



S.S. "NAUSICAA"
SHELL EXPANSION

SCALE 1/8" = 1 FOOT
PRINCIPAL DIMENSIONS 388'-0" LBP X 52'-6" B MLD X 29'-3" D MLD

SECTION THRO' KEEL PLATE

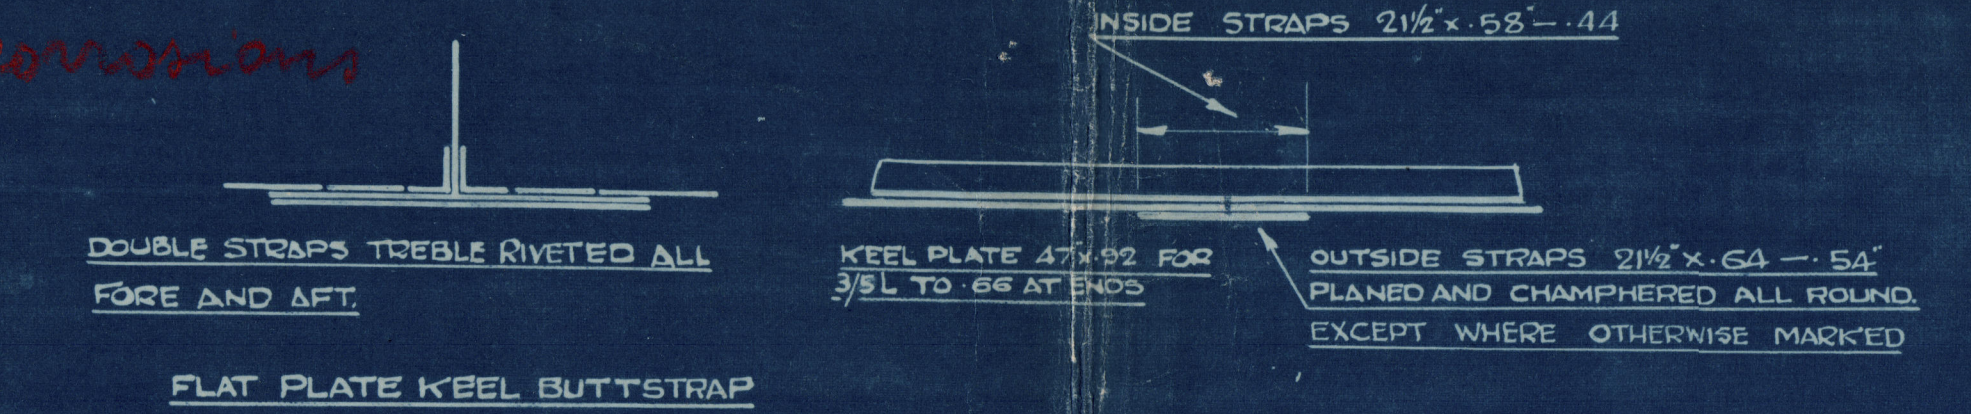


YARD N° 100

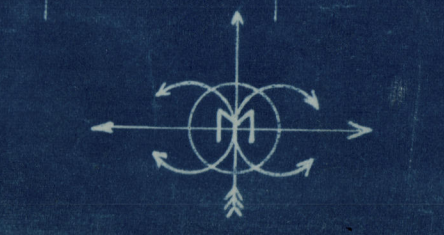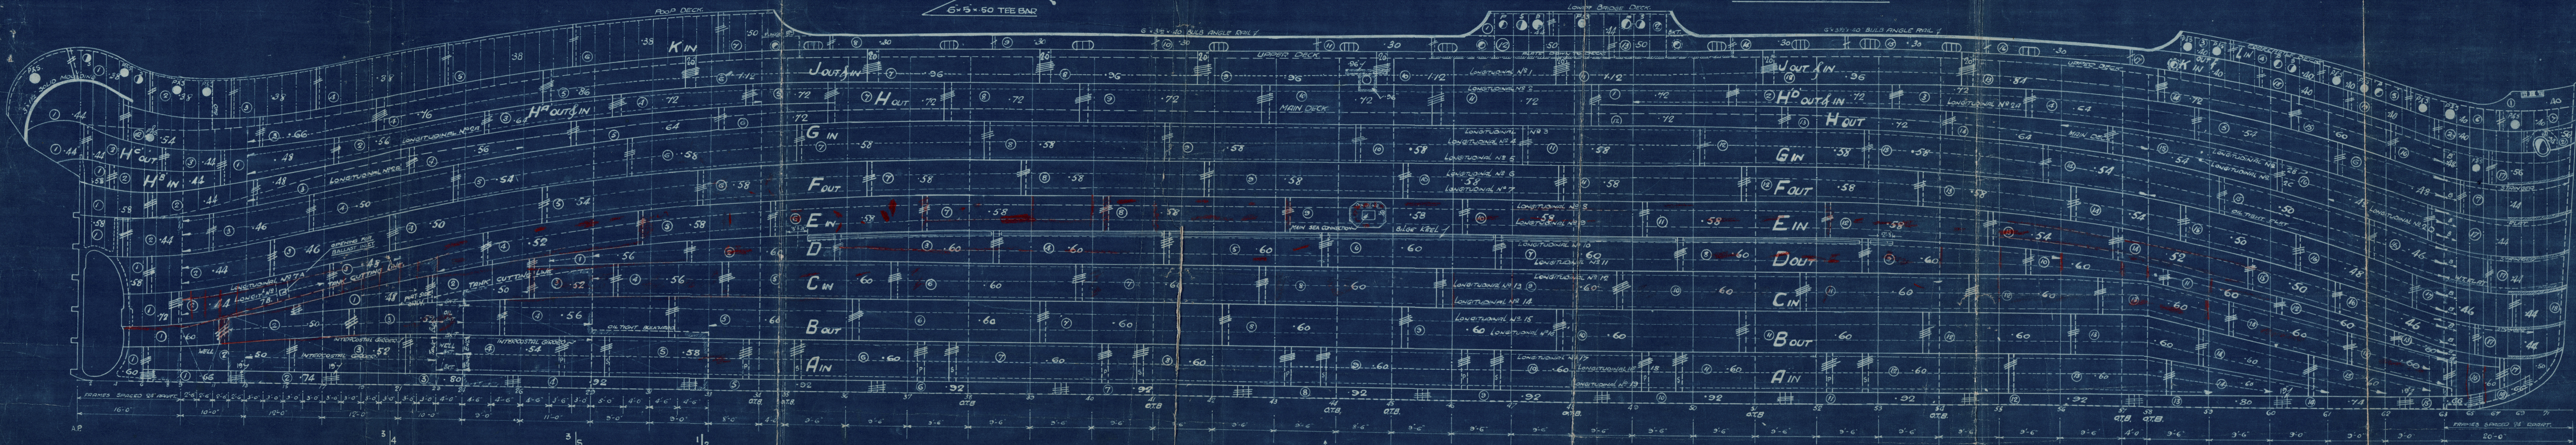

INSIDE STRAPS 21½" x .58"

OUTSIDE STRAPS
PLANED AND CH
EXCEPT WHERE

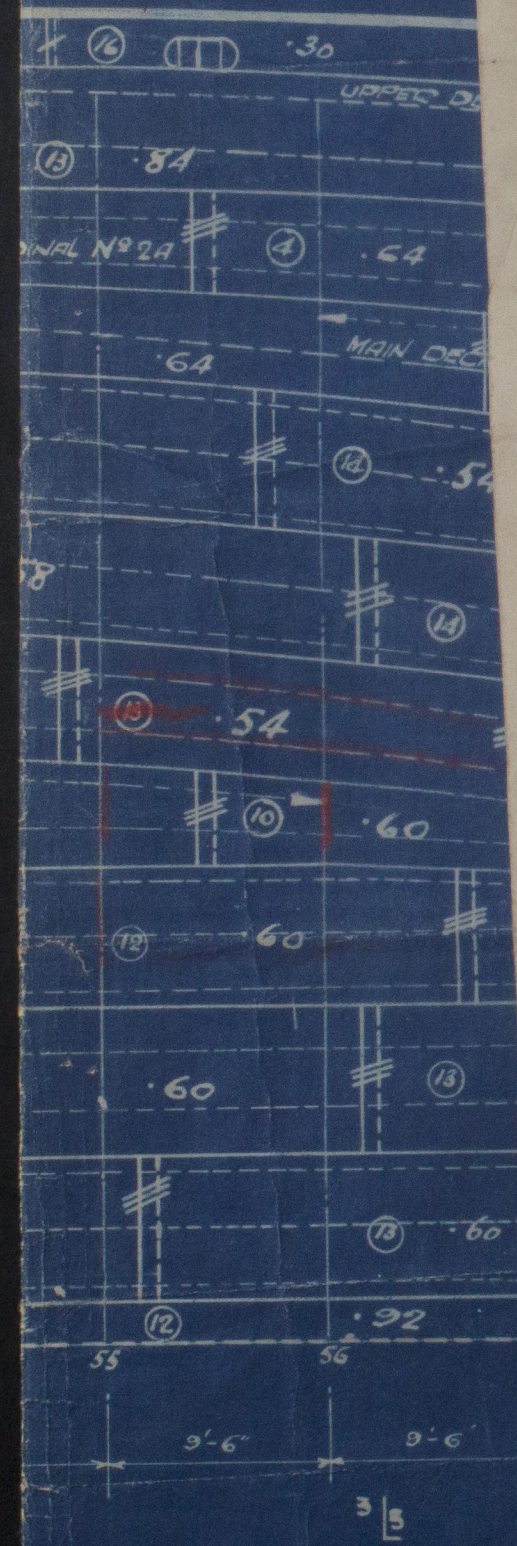

H

Nausicaa

Développement du bordé

7

W518-0235