



24.1.13.
19.2.13


DECK PLAN. NO 57 1/2

SCALE 1/8" = ONE FOOT.


DIMENSIONS:- 405'-0" B.P. x 31'-0 1/2" M.D. x 30'-6" M.D.

TO CLASS 100 A.I. LLOYDS


POOP DECK.

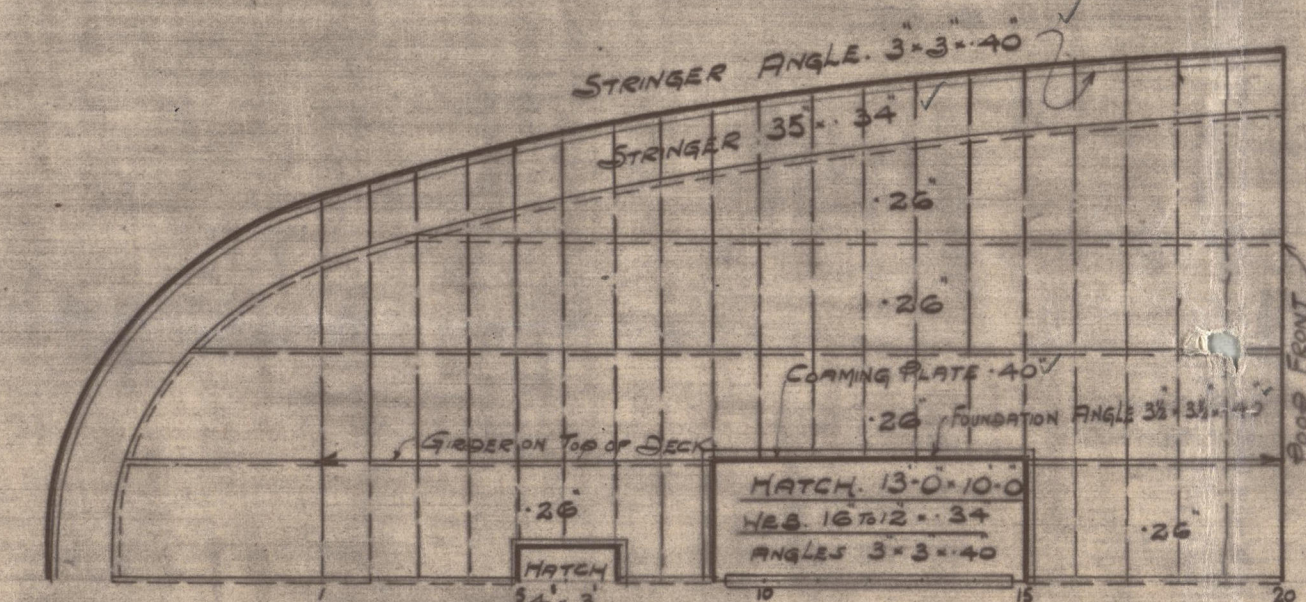


BRIDGE DECK.

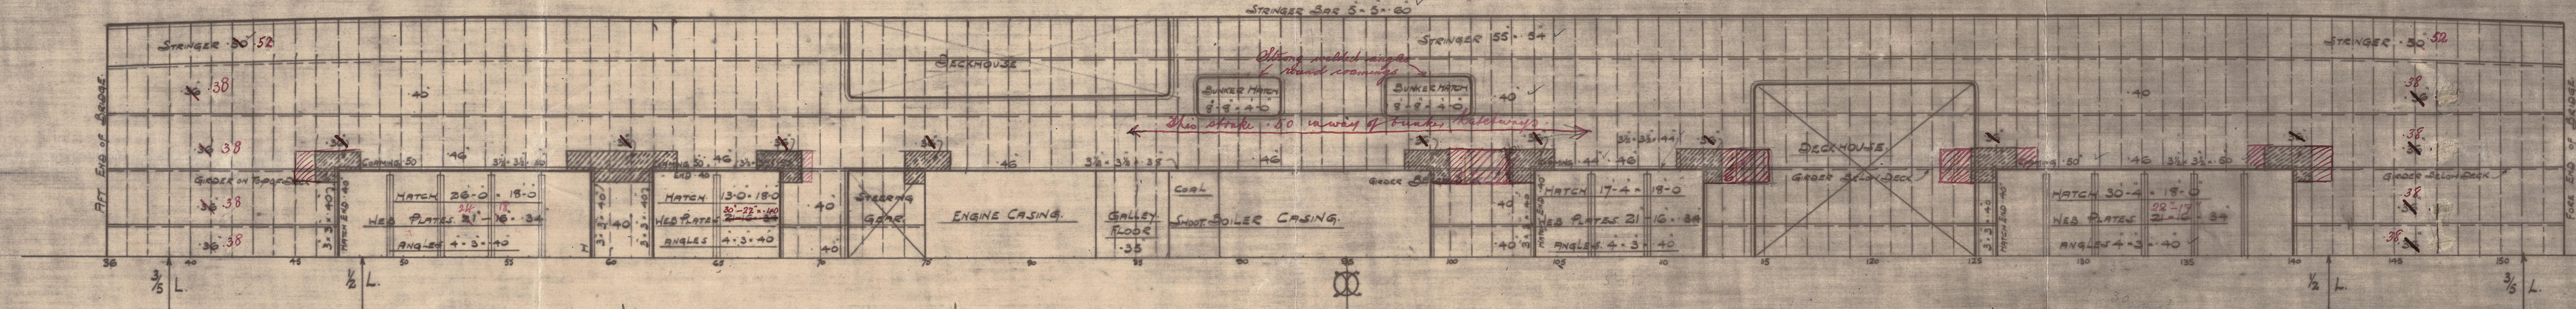


FORECASTLE DECK.

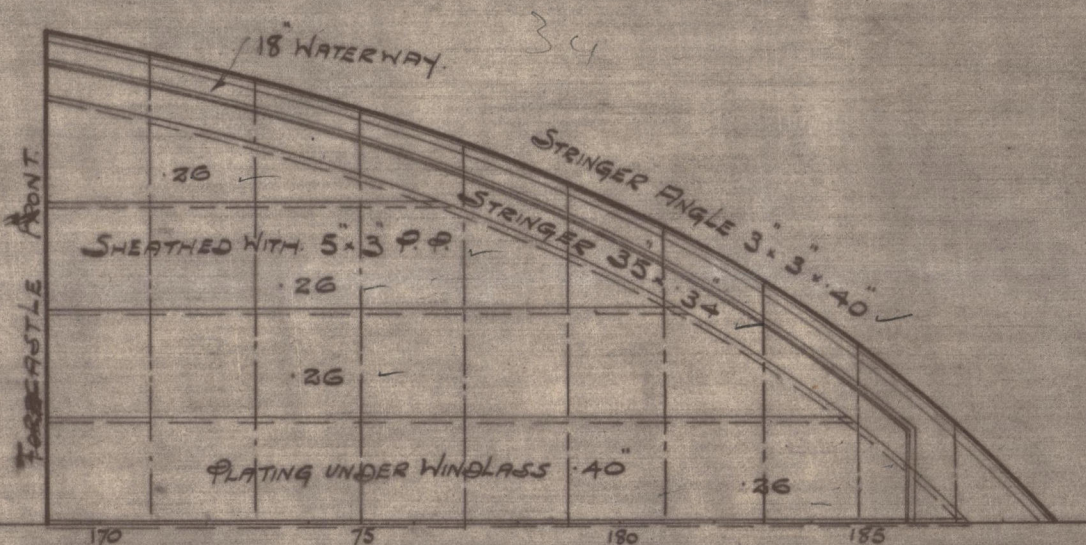

UPPER DECK.

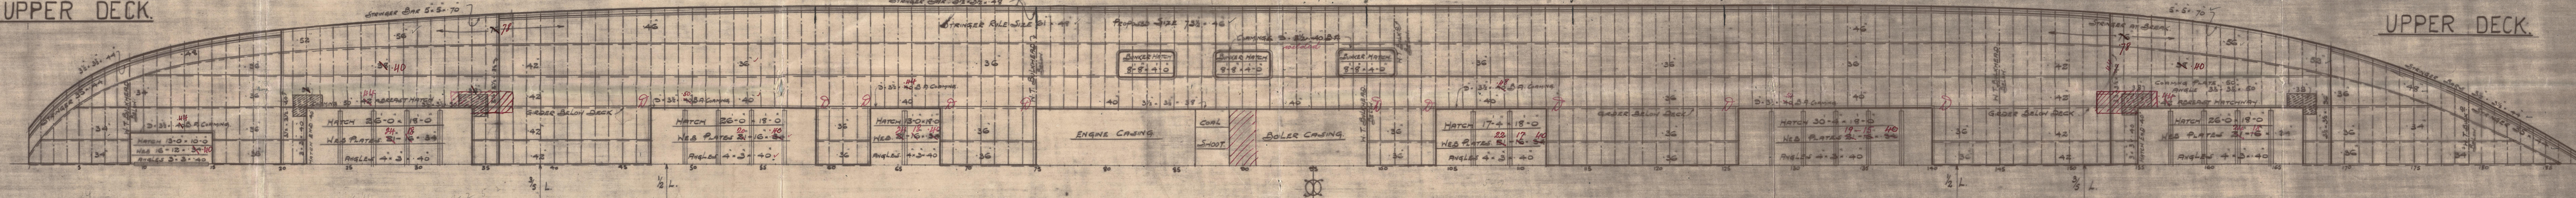

MAIN DECK.

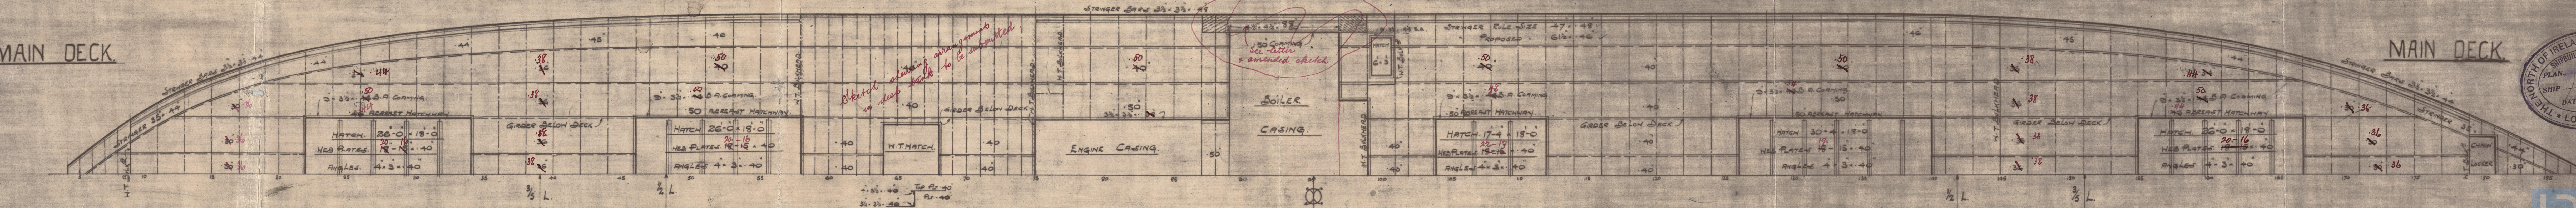

MAIN DECK.



North of Ireland S.B. Co. Ltd


Nº 57

Duck. Plans.



"Lammol du Pont"

^{ex}
s. "San Francisco"
Bel. 7381.

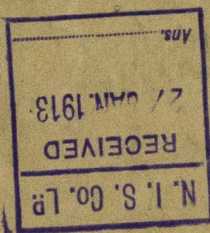

© 2021

Lloyd's Register
Foundation

WS2 F0048