

— Nº 186. —  
MIDSHIP SECTION.


LLDYS NUMERALS.

MOULDED BREADTH	49.79
MOULDED DEPTH	26.00
1 <sup>ST</sup> NUMBER	75.79
	350.0
2 <sup>ND</sup> NUMBER	26526.50

DEPTH TO LENGTH U.D. 13.46  
" " " B.D. 10.44  
d = 22.58 UNDER 22

PRINCIPAL DIMENSIONS  
LENGTH B.P. 350'0" BREADTH EX. 50'0" DEPTH MLD 26'0"  
CLASS B.B. 1. AT LLOYDS.  
SEALED 1 FEB

<u>SHEER.</u>	
FORWARD	10-0'
AFT	5-0'
1/8 L FORWARD	5-5'
1/8 L AFT	2-7 1/2'
APPROX UNDER DECK TONNAGE = 3440.	

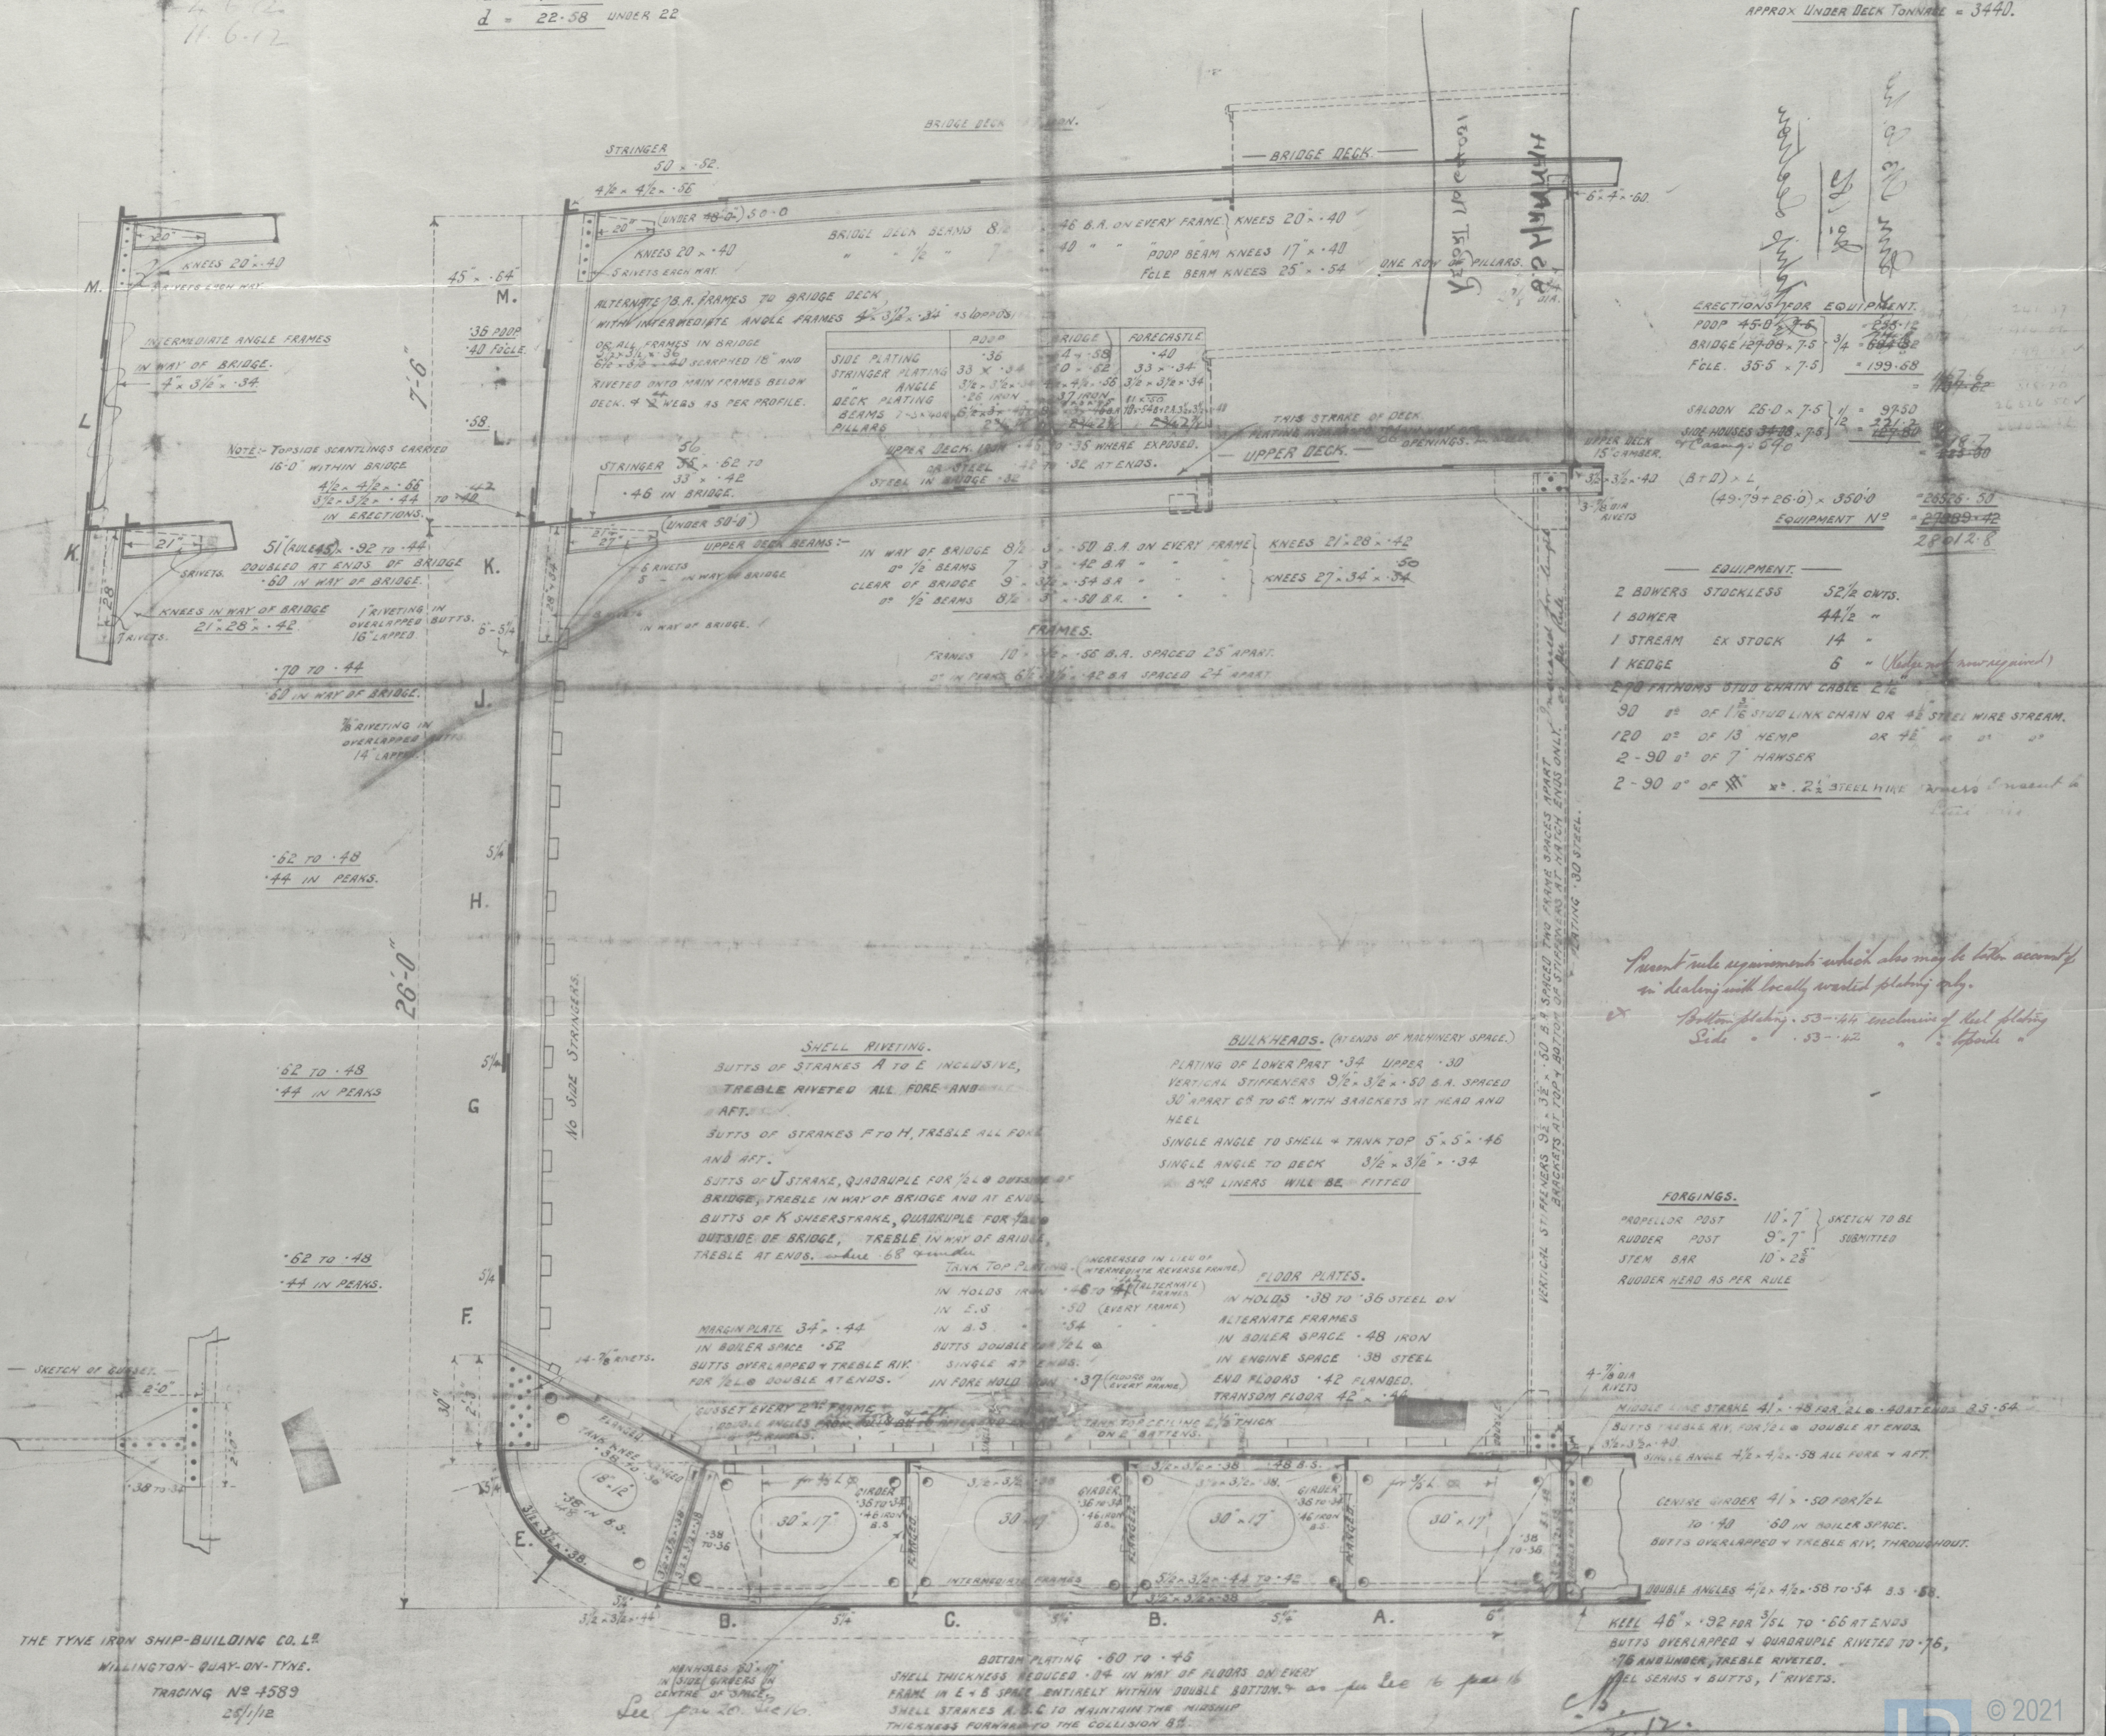



*Admiral  
Hutchinson*

St. Le HANNAH Built Nov. 1913.  
Midship Section (Spare copy)

File with F.E. ref.

RETAIN

RETAIN

WS24-0179



© 2021

Lloyd's Register  
Foundation