

# Lloyd's Register of Shipping.

(Report on Vessel No. \_\_\_\_\_ Port Sunderland.)

## No. \_\_\_\_\_ SHIP FORGINGS OR CASTINGS.

I have to report that the undermentioned Iron or Steel Forgings or Castings, manufactured by M<sup>rs</sup> J. S. Forster & Son Ltd of Sunderland for the Vessel No. 424, being built by Short Bros Ltd of Sunderland have been inspected by me as set forth below and found to be, so far as can be seen, Sound.

The words FORGINGS or CASTINGS, IRON or STEEL, should be struck out as may be required.

Mark on Forgings or Castings.

Lloyd's  
No. 4166

2-3-26



D. D. Williamson

Sunderland 3-3-26



	STERN FRAME.	RUDDER FRAME.	STEM.		
Material* ...	<u>Scrap Iron</u>	/	/		
How made † ...	<u>Forged</u>				
Dimensions ...	<u>9x8 1/2" &amp; 10 1/2" x 8 1/2"</u>				
Progress on Inspection ...	<u>Forged &amp; Finished</u>				
Date when Inspected	<u>22-1-26 &amp; 2-3-26</u>				
CASTINGS.					
Tests on Standard Test Pieces.					
Tensile Test—					
Tons per square inch ...					
Extension per cent. ...					
Cold Bending Test—					
Angle before fracture ...					
Drop Test—					
Height from ground ...					
Hammering Test—					
If made according to Rules and found satisfactory ...					


SKETCHES OF FRAMES SHOWING POSITION AND DESCRIPTION OF WELDS OF FORGINGS.

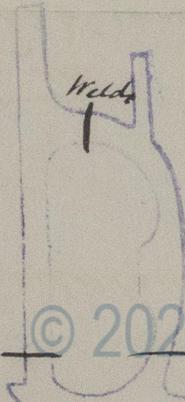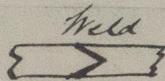

Fee (if any chargeable) £

To be paid at

\* If of Iron, state whether scrap or puddled Iron. If of Steel, state whether made on the Open Hearth process.

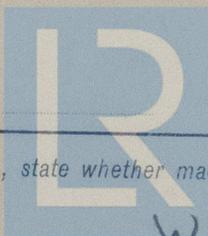

© 2021

Lloyd's Register Foundation

W528-0327

Sunderland

Shott Bros.

No. 424

Stem Frame

"s/ Angle Australian"

SUNDERLAND RPT. NO. 29431

LR

© 2021

Lloyd's Register  
Foundation

W528-0327